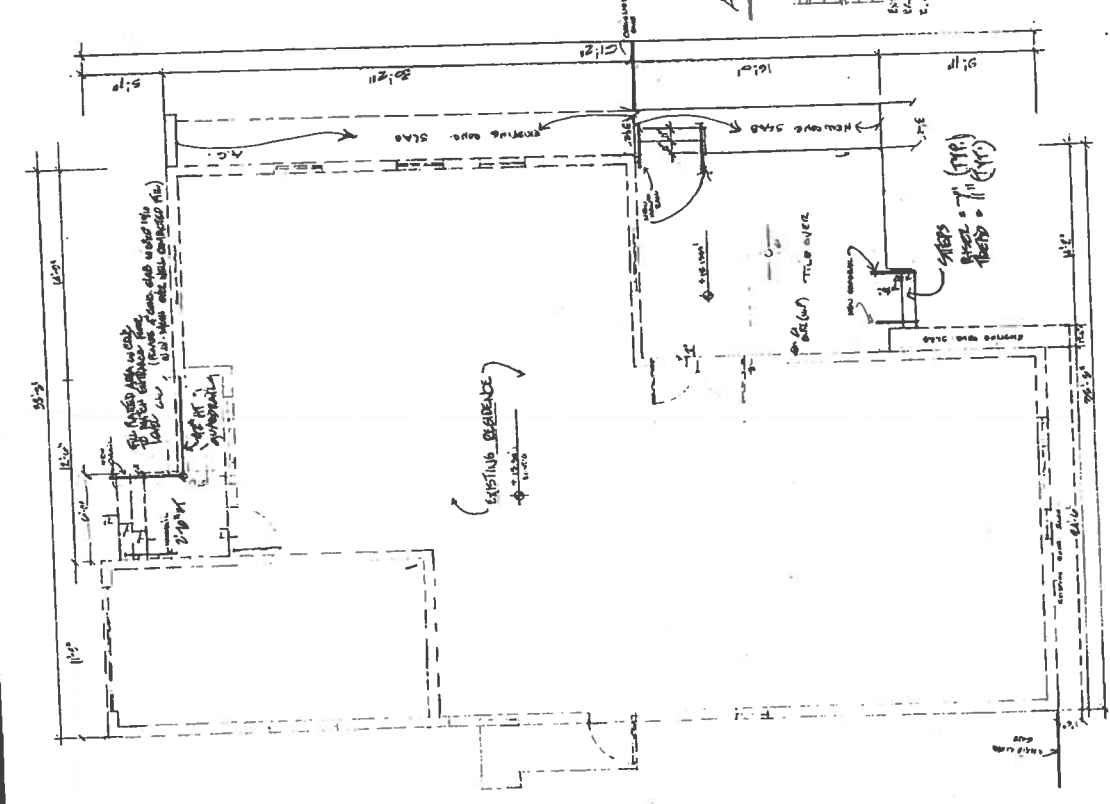


AS-BUILT

RESIDENCE IMPROVEMENT for MR & MRS IGLESIAS

Reviewed by: 8/30/08


[illegible]

LEGEND: New
 --- Exist

Flood Road as: V4-1-1-1

GENERAL NOTES:

- 1) CONTRACTOR TO VERIFY ALL DIMENSIONS AGAIN FIELD DISCREPANCY. THE REQUIREMENTS SHOULD BE NOTIFIED
- 2) ALL WORK TO MEET ALL REQUIREMENTS OF 40 P.A. 81.06 CODE AND LATEST REVISIONS.
- 3) ALL CONCRETE - 3000 PSI W 4% FATS

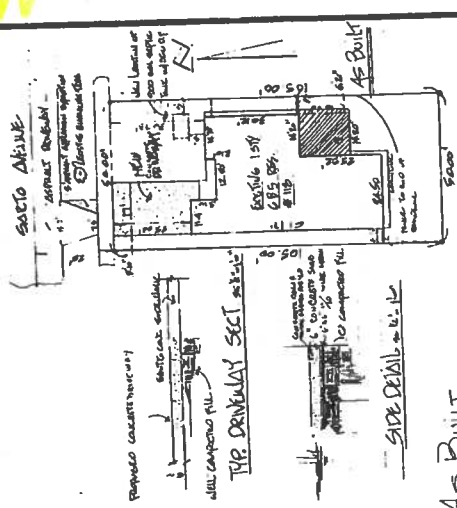

AS 1001


020201-001

FLU PLAN 5-1-72

LEAD: LOTS 9 AND 10 W BLACK N CAROL
GABLES CORRUPT CORRUPT SECTION
PART OF 18 N 18 25

ROOF FRAME LAYOUT 2: 8-10-03

As Built

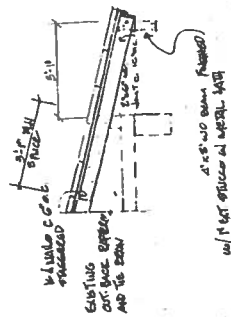


DETAIL ② 2.2.22

सद्वृत्ति

•

711

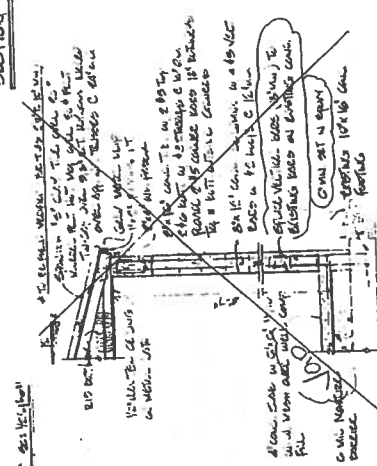

Note: _____
 Address to PAID with _____
 Permit No. 93030243 _____

section  No. 101 - 101

9/3883

9805632

Porch As-Built

Revision

OFFICE SET

#1719

to

permit #

93030343

1 93030343

118 S. 10 Ave.

SECTION	BY	DATE
CHARTER AREA	W.R.	5/17/88
LANDING MARK	W.R.	5/17/88
ADDITIONAL	W.R.	5/17/88
STRUCTURAL	W.R.	5/17/88
FINISH	W.R.	5/17/88
APPENDIX	W.R.	5/17/88

LINK 92108575

9403