## PLUMBING DEMOLITION NOTES


- 1. CONTRACTOR SHALL VERIFY WITH OWNER PRIOR TO DEMOLISHING ALL EXISTING SINKS AND WC TO BE REMOVED OR RELOCATED.
- 2. UNLESS OTHERWISE NOTED AS EXISTING TO REMAIN OR TO BE RELOCATED, ALL PLUMBING FIXTURES LOCATED IN THE AREAS SHOWN AS BEING DEMOLISHED OR NOT USED AFTER WORK IS COMPLETED, SHALL BE REMOVED. LINES RUN IN SLAB SHALL BE CUT FLUSH, PLUGGED AND ABANDONED AFTER FIXTURES ARE REMOVED.
- 3. SEE PLUMBING SHEETS FOR DETAILS.


## **ELECTRICAL DEMOLITION NOTES**

- 1. CONTRACTOR IS TO VERIFY WITH OWNER AND IDENTIFY ALL EXISTING PIPES, CONDUITS, ETC. TO REMAIN PRIOR TO DEMOLITION. MARK ALL PIPES, CONDUITS, ETC. NOT TO BE DEMOLISHED WITH RED PAINT. INFORM ALL SUB-CONTRACTORS.
- 2. UNLESS OTHERWISE NOTED AS EXISTING TO REMAIN OR TO BE RELOCATED, ALL LIGHTING FIXTURES, RECEPTACLES, SWITCHES, SPECIAL OUTLETS, TELEPHONE CABLES, TV CABLES, MISCELLANEOUS SYSTEM WIRING, POWER CONDUCTORS, CONDUITS, ELECTRICAL BOXES, RACEWAYS AND OTHER ELECTRICAL SYSTEM COMPONENETS LOCATED IN THE AREAS SHOWN AS BEING DEMOLISHED OR NOT USED AFTER WORK IS COMPLETED, SHALL BE REMOVED. CONDUITS RUN IN SLAB SHALL BE CUT FLUSH, PLUGGED AND ABANDONED AFTER CONDUCTORS ARE REMOVED. NO WIRING SHALL BE LEFT ABANDONED AFTER WORK IS COMPLETED.
- 3. SEE ELECTRICAL SHEETS FOR DETAILS.

## DEMOLITION PLAN LEGEND

EXISTING WALL TO REMAIN EXISTING WALL TO BE REMOVED. CONTRACTOR TO COORDINATE W/ ARCHITECTURAL AND STRUCTURAL ----------DRAWINGS BEFORE REMOVING ANY STRUCTURAL EXISTING DOOR AND FRAME TO REMAIN EXISTING DOOR AND FRAME TO BE REMOVED EXISTING WINDOW TO REMAIN EXISTING WINDOW TO BE REMOVED

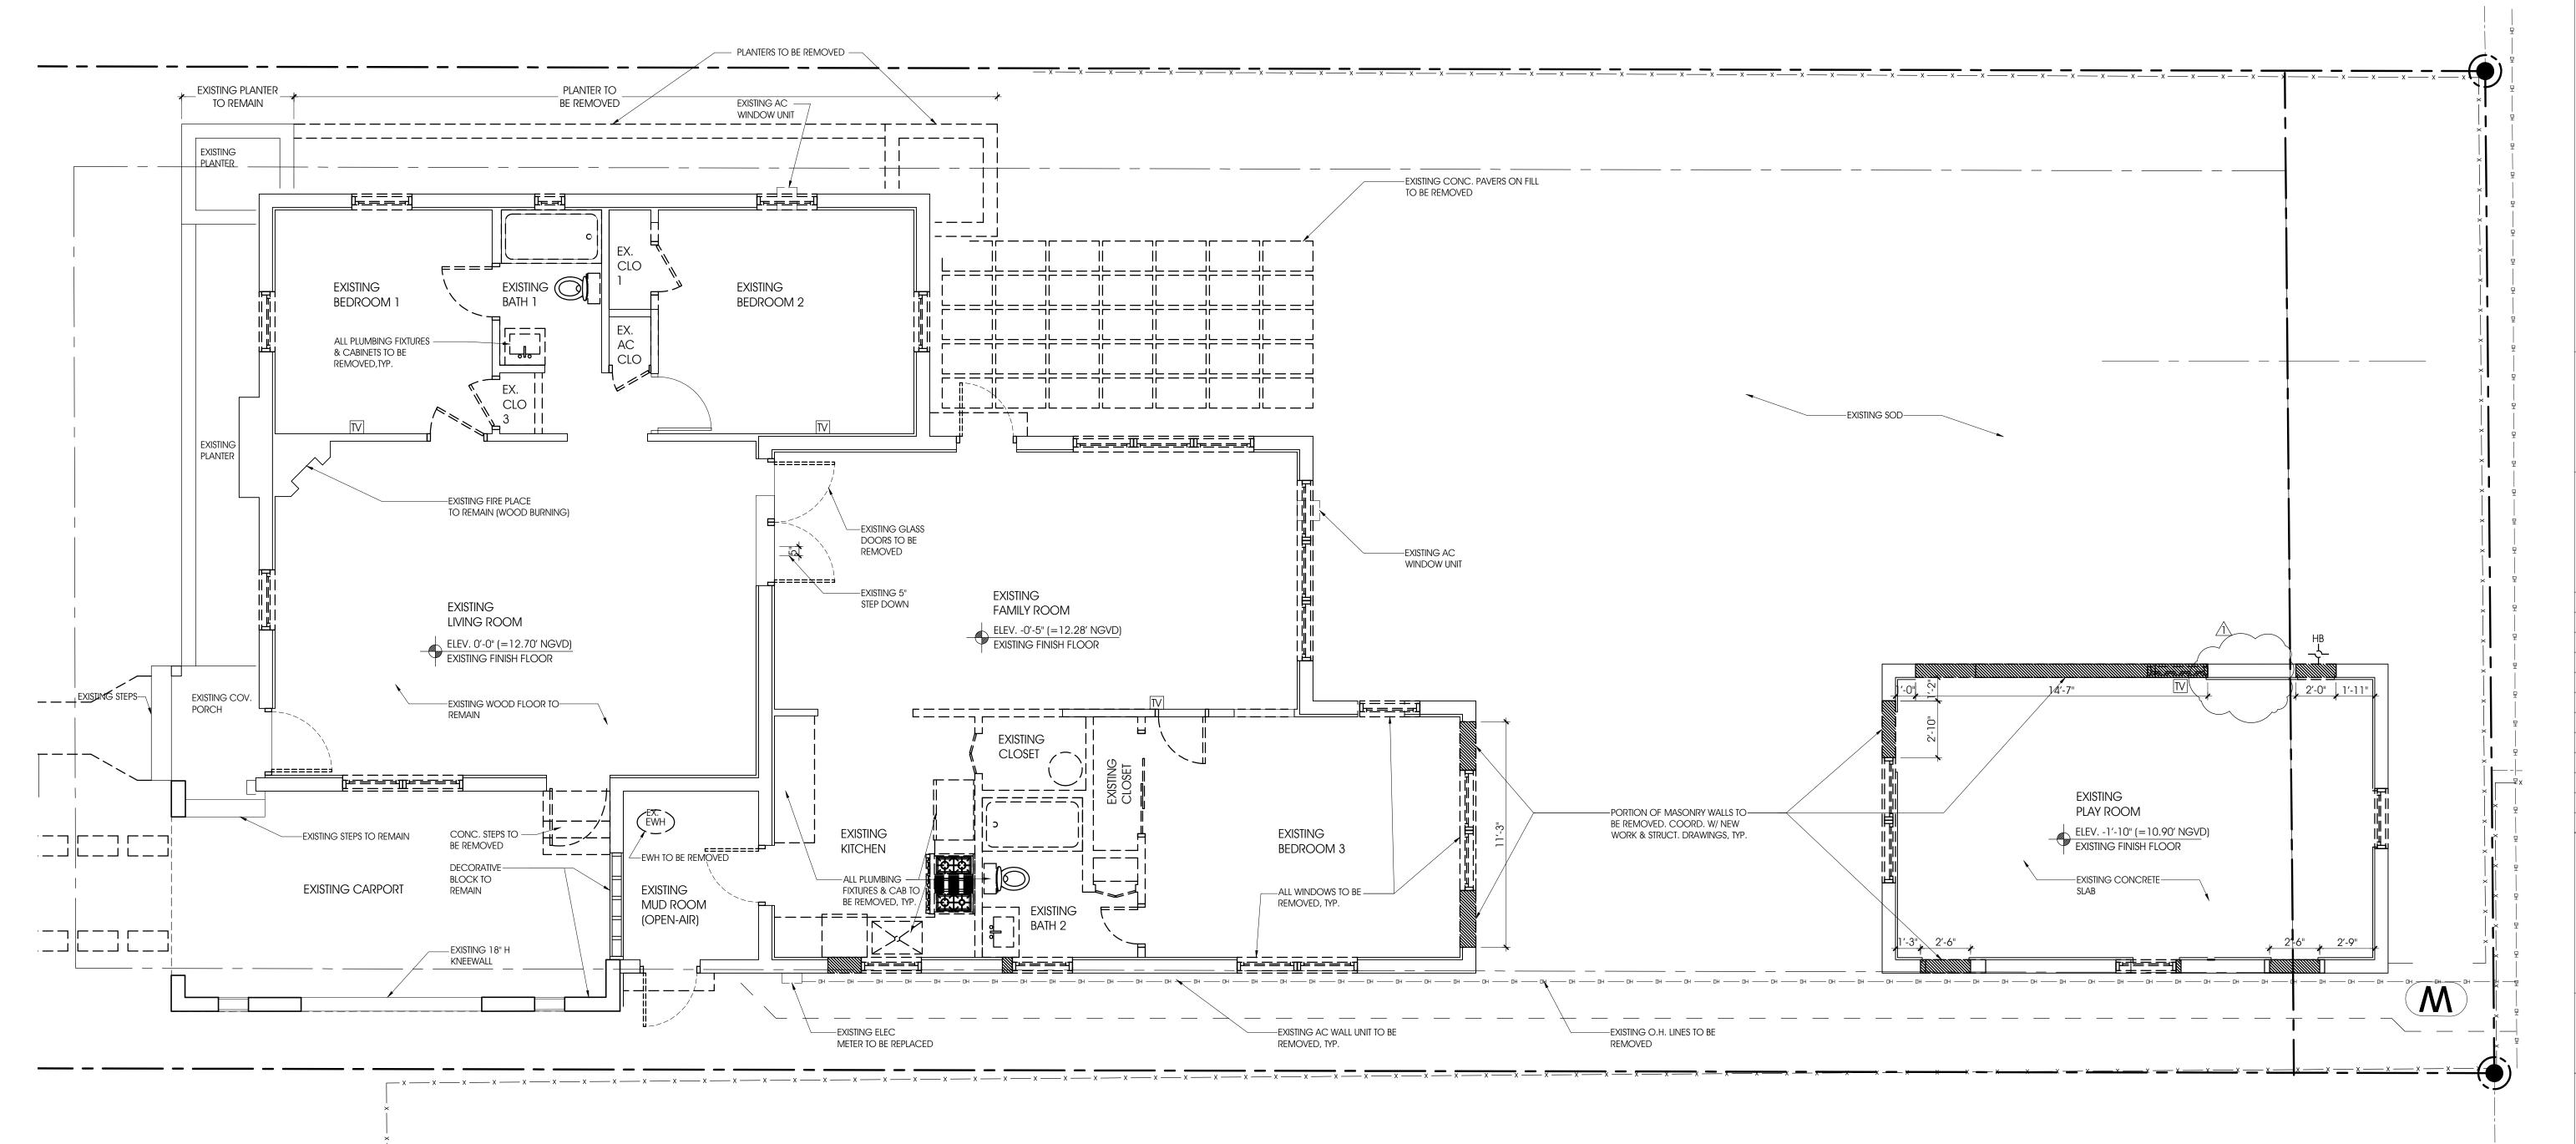

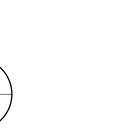



CONSULTANT(S)

NO.	REVISION/SUBMISSION	DATE
	PERMIT SUBMITTAL	10-04-24
	PRELIMINARY BOA	10-07-24
$\triangle$	REVIEW COMMENT	11-18-24
	PRELIMINARY COA	
	PROJECT	

Remodel & Addition to 1-Story Residence

720 Madeira Avenue Coral Gables, FL 33134

SCALE

DRAWN

REVIEWED NdL

PROJ. NO.

DRAWING

Existing and Demolition Floor Plan



AR 13937 SHEET NO.

A-02.0

EXISTING AND DEMOLITION FLOOR PLAN NORTH SCALE: 1/4" = 1'-0"