


**NOTES**

1. MAINTAIN A MINIMUM DISTANCE OF 10" BETWEEN THE WALL AND THE EDGE OF ANY CEILING MOUNTED DIFFUSERS.
2. CENTER ALL LIGHTS AND DIFFUSERS AS SHOWN ON THIS PLAN. COORDINATE WITH ARCHITECT ANY CONFLICTS.
3. GC TO COORDINATE SECURITY, SOUND, DATA LOCATIONS WITH OWNER'S CONSULTANT.
4. SEE EXTERIOR AND INTERIOR ELEVATIONS FOR ALL WALL MOUNTED LIGHT AND SCENCE HEIGHT LOCATIONS.
5. COORD W/ OWNER LOCATION OF LIGHTS ON DIMMERS.
6. SPACE WALL OUTLETS 4" APART AND ALIGN TOPS AT ALL LOCATIONS WITH 2 OR MORE OUTLETS/SWITCHES.
7. CENTERLINE ALL AC EQUIPMENT WITH CEILING LIGHTS WHEREVER POSSIBLE.

**LEGEND**

- RECESSED DOWNLIGHT
- ◐ RECESSED WALL WASHER
- WALL MOUNTED LIGHT
- D WALL MOUNTED SCENCE
- ⊙ SMOKE DETECTOR
- ⊞ EXHAUST FAN
- J JUNCTION BOX (RATED FOR 100 LBS MINIMUM CAPACITY)
- ◻ RETURN AIR DIFFUSER
- ⊞ SUPPLY AIR DIFFUSER
- ◁ SECURITY LIGHT
- - - UC LIGHT OR LED STRIP
- ▬ PICTURE LIGHT (WALL MID)
- TV TV OUTLET
- ◇ WALL FAN
- SURFACE MOUNTED LIGHT
- ⊙ PENDANT LIGHT OR CHANDELIER (BOX RATED FOR 100 LBS)
- ⊞ CEILING FAN (RATED FOR 100 LBS MINIMUM CAPACITY) W/ LIGHT
- SP SPEAKER (SOUND)-COORD. LOCATIONS WITH OWNER REP.
- LINEAR DIFFUSER.

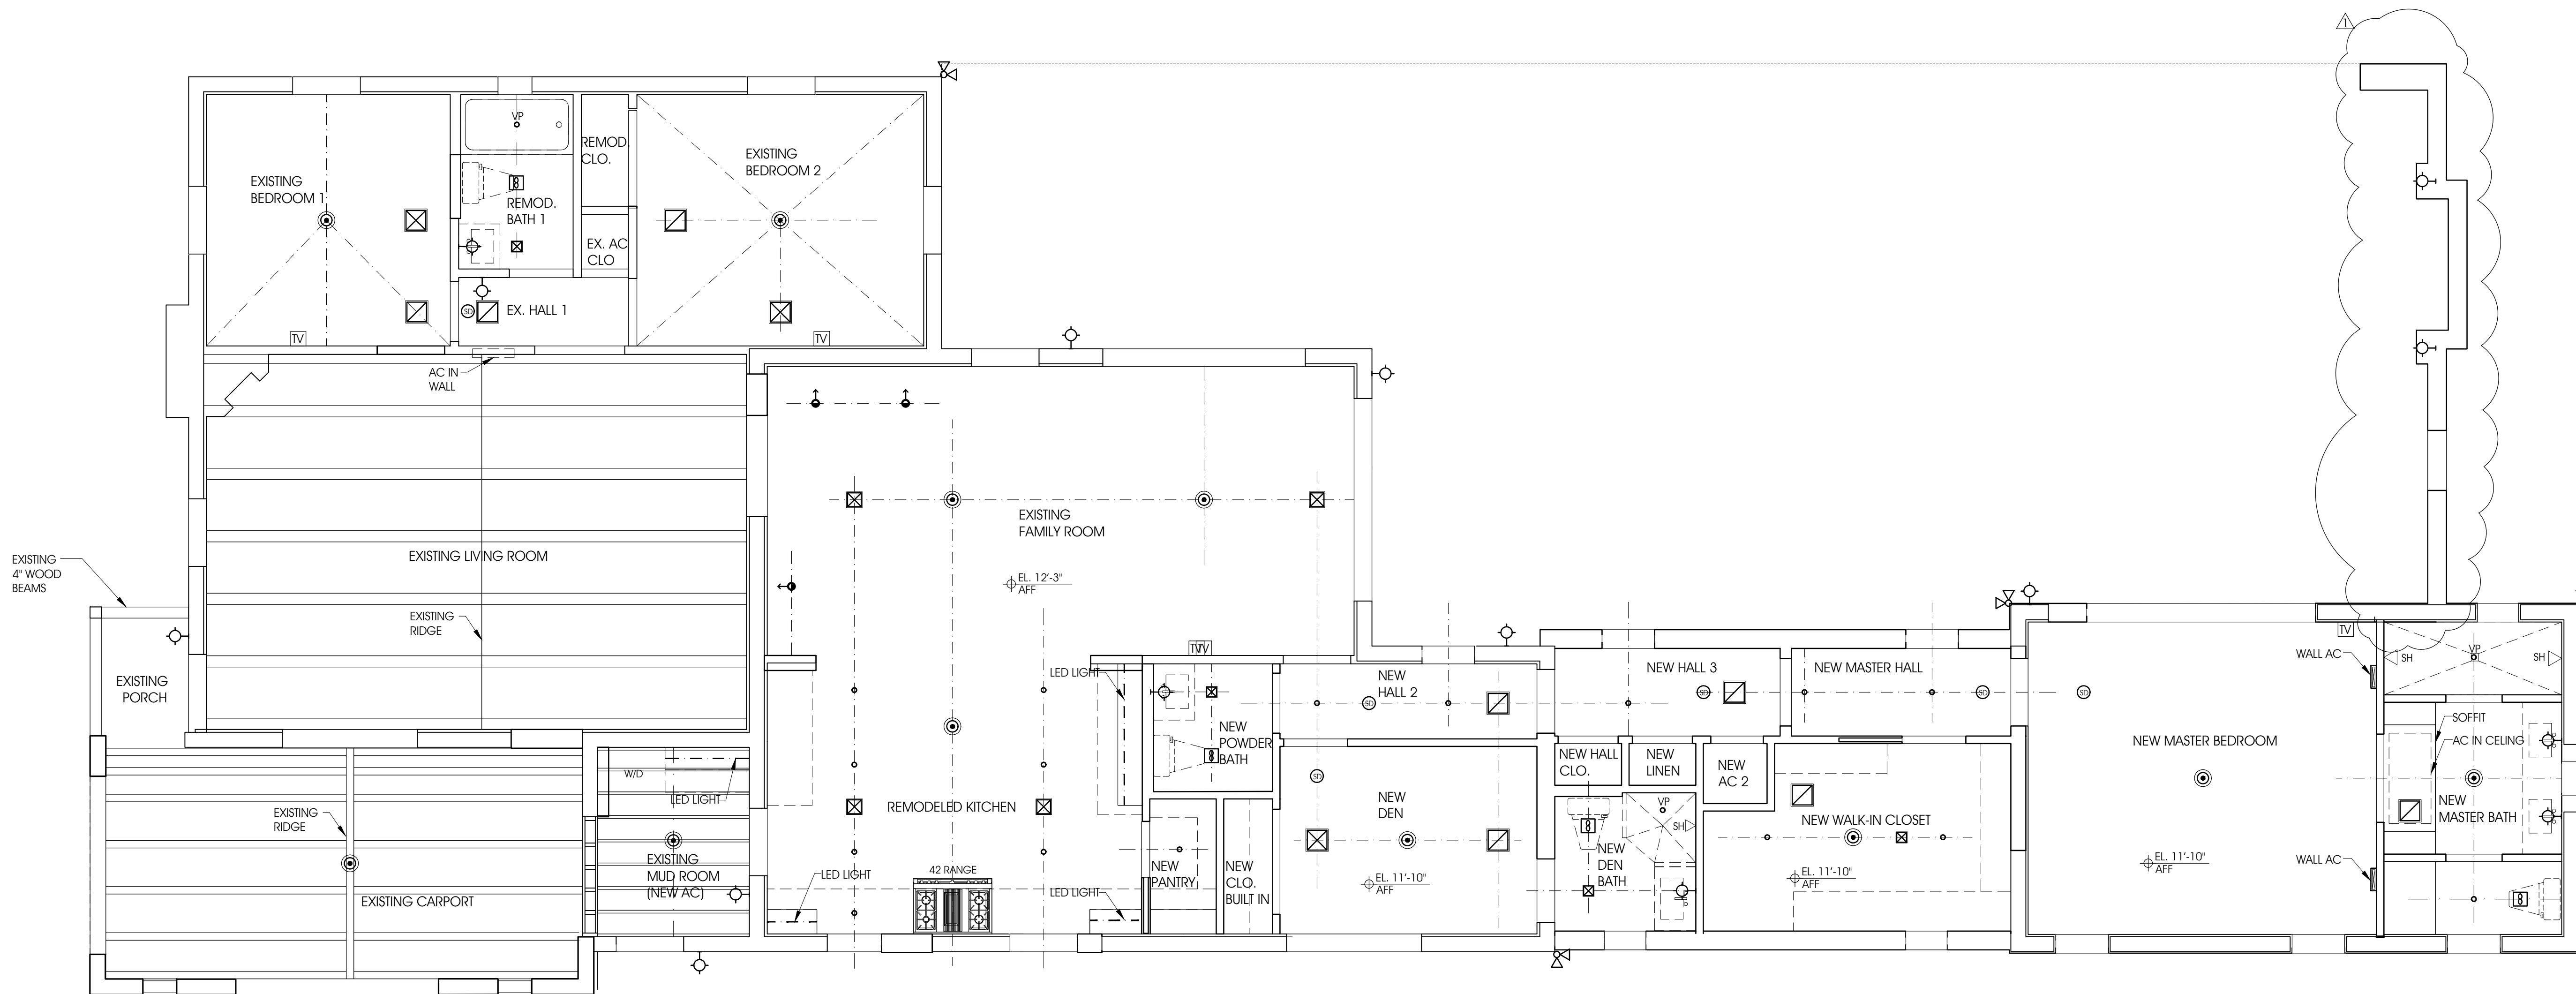


**LOCUS ARCHITECTURE**  
 INCORPORATED  
 500 South Dixie Highway, Suite 307  
 Coral Gables, Florida 33146  
 Tel: (305) 740-0120  
 Fax: (305) 740-0520  
 License No. AA0002733

CONSULTANT(S)

NO.	REVISION/SUBMISSION	DATE
	PERMIT SUBMITTAL	10-04-24
	PRELIMINARY BOA	10-07-24
	REVIEW COMMENT	11-18-24
	PRELIMINARY COA	

PROJECT  
 Remodel & Addition to  
 1-Story Residence  
 720 Madeira Avenue  
 Coral Gables, FL 33134


DRAWING  
 Proposed Reflected  
 Ceiling Plan

SEAL  
  
 Nelson de Leon  
 AR 13937

SCALE  
 DRAWN  
 REVIEWED  
 NdL  
 PROJ. NO.  
 361

**PROPOSED REFLECTED CEILING PLAN**

SCALE: 1/4" = 1'-0"

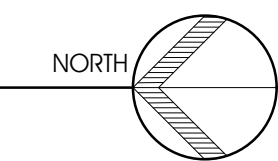

SHEET NO.  
**A-03.0**