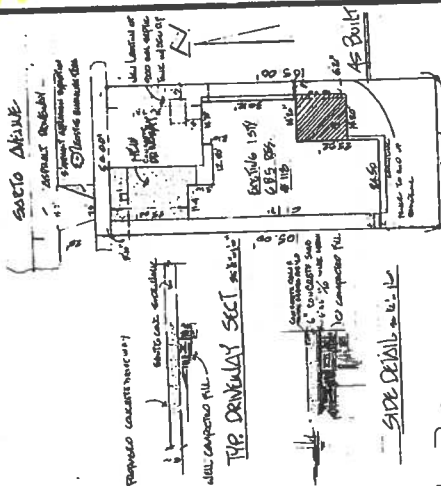



RESIDUE IMPROVEMENT FOR MR & MRS IGLESIA

Reviewed by:

[illegible]

20T PLAN sec 10.2d

Find: Lots 9 and 10 w/ Block 11 Corral
GARRETS CORRAL (Concrete Section)
Get all EB in Photos

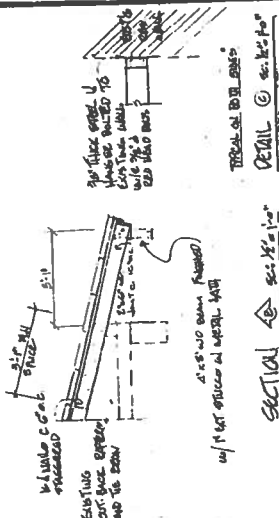


Physical Body

SECTION $\triangle$ $\sin 45^\circ = \frac{1}{\sqrt{2}}$


Note: Answer to PMS 1984
PMS No. 93030343

Section $u = \frac{40^2}{2} = 800$


the the water impregnation at this time
the the water impregnation is about 1/2
the the water impregnation is about 1/2
the the water impregnation is about 1/2
the the water impregnation is about 1/2

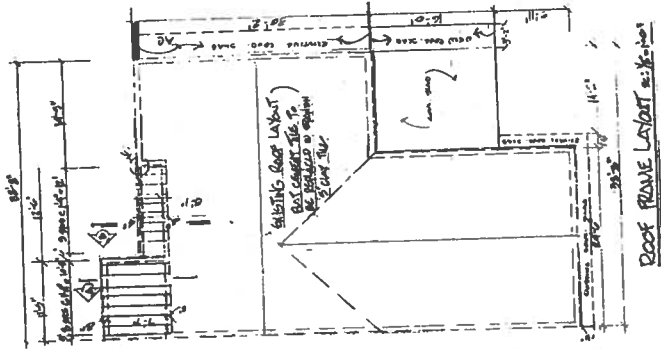

DOOF PRAME LATART $\approx \frac{1}{2} \cdot \frac{1}{2} \cdot \frac{1}{2}$

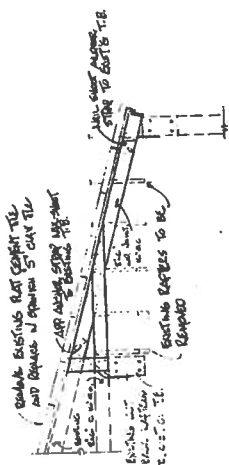

As Built

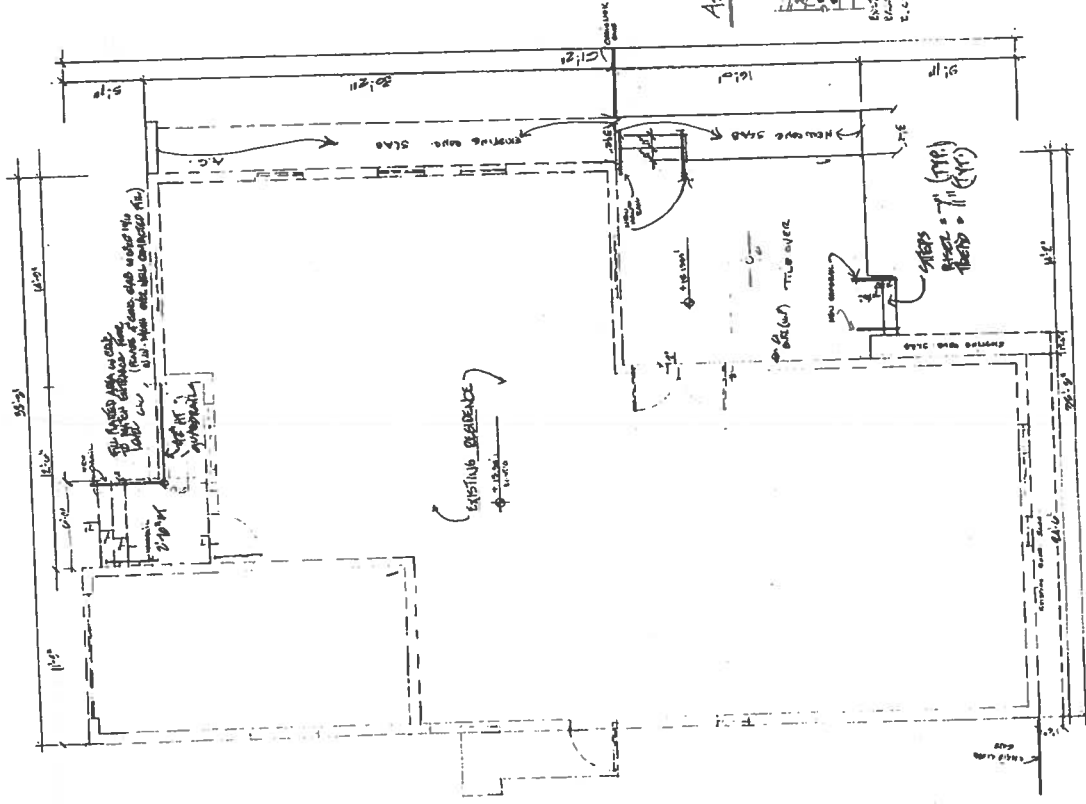

LEGEND: --- Exist --- New

Flood Risk as: 14-1-1-1

GENERAL NOTES:

- 1) CONTRACTOR TO VERIFY ALL DIMENSIONS
- 2) GAIN FIELD DISCREPANCY THE ARCHITECT SHOULD BE NOTIFIED
- 3) ALL WORK TO MEET ALL REQUIREMENTS OF 200 F.L. BLDG CODE AND LATEST REVISIONS.
- 4) ALL CONCRETE 3000 PSI W 4% FIBERS

C/38.83

98056327

Porch As-Built

35

Revision

OFFICE SET

to

perm. + #

93030343

93030373
118 Sarto Ave.

— 133 —

[illegible]

LINK → 92108575
9903