


Historically Designated Italian Village Remodeling and Additions to: Olivera Residence

641 San Lorenzo Avenue
Coral Gables, Florida 33134

Project Team

 LOCUS ARCHITECTURE	INCORPORATED	ARCHITECTURE
	500 South Dixie Highway, Suite 307 Coral Gables, Florida 33146 Tel: (305) 740-0120 Fax: (305) 740-0120 Licenses No.: AK0002733	
	Armando Olivera	OWNER
	712 San Eleccion Avenue Coral Gables, FL 33146 Tel: (305) 754-8805	

Torre Development

500 South Dixie Highway, Suite 301 Coral Gables, Florida 33146 Tel: (305) 740-0120 Fax: (305) 740-0056 Licenses No.: 061766	GENERAL CONTRACTOR
---	--------------------

ARPE, Engineering Inc.

2665 Le Jeune Road Suite 1109 Coral Gables, FL 33134 Tel: (305) 444-9899 Fax: (305) 444-9827 License No.: 60256	MECHANICAL, ELECTRICAL, PLUMBING
---	----------------------------------

Ignacio J. Calvo, PE

1800 SW 27th Ave, Ste. 401 Miami, FL 33145 Tel: (305) 248-9008 Fax: (305) 248-9123 License No: 56755	STRUCTURAL
--	------------

Drawing Contents


SHEET NO.	SHEET CONTENTS	
ARCHITECTURE		
A-01	SITE PROPOSED PLAN, ZONING INFORMATION	E-01 ELECTRICAL SITE PLAN
A-01.1	SITE WALLS AND DETAILS	E-1.0 POWER 1ST PLAN
A-02	SITE DEMOLITION PLAN	E-1.1 LIGHTING 1ST PLAN
A-03	FIRST & SECOND FLOOR DEMOLITION PLAN	E-1.2 POWER 2ND PLAN
A-04	FIRST FLOOR PROPOSED PLAN	E-1.3 LIGHTING 2ND PLAN
A-04.1	FIRST FLOOR PROPOSED REFLECTED CEILING PLAN	E-2.0 ELECTRICAL NOTES AND SCHEDULES
A-05	SECOND FLOOR PROPOSED PLAN	E-2.1 ELECTRICAL PANEL
A-05.1	SECOND FLOOR PROPOSED REFLECTED CEILING PLAN	
A-06	ROOF PROPOSED PLAN	MECHANICAL
A-07	EAST & SOUTH EXTERIOR ELEVATIONS, EXISTING & PROPOSED	M-1.0 MECHANICAL 1ST PLAN
A-08	WEST & NORTH EXTERIOR ELEVATIONS, EXISTING & PROPOSED	M-1.1 MECHANICAL 2ND PLAN
A-09	BUILDING SECTIONS-ELEVATIONS: A,B,C,D	M-2.0 MECHANICAL NOTES AND DETAILS
A-10	BUILDING SECTIONS-ELEVATIONS: E,F,G,H	M-2.1 MECHANICAL SCHEDULES
A-11	WALL SECTIONS: 1,2,3	
A-12	WALL SECTIONS	PLUMBING
A-13	WINDOW AND DOOR SCHEDULES, DETAILS	P-01 PLUMBING SITE PLAN
A-14	STAIR SECTIONS AND DETAILS	P-1.0 PLUMBING 1ST PLAN
		P-1.1 PLUMBING 2ND PLAN
		P-2.0 PLUMBING NOTES AND DETAILS
STRUCTURE		
S-1	FOUNDATION FRAMING PLAN	
S-2	SECOND FLOOR FRAMING PLAN	
S-3	ROOF FRAMING PLAN	LANDSCAPE
S-4	GENERAL STRUCTURAL NOTES AND TYPICAL SECTIONS	L-1 LANDSCAPE EXISTING SITE PLAN
S-5	SCHEDULES	L-2 LANDSCAPE PROPOSED SITE PLAN
S-6	STRUCTURAL SECTIONS	
S-7	STRUCTURAL SECTIONS	
S-8	STRUCTURAL SECTIONS	
SWP1	WIND PRESSURE ELEVATION	
SWP2	WIND PRESSURE ELEVATION	

B.O.A. PRELIMINARY REVIEW- JULY 12, 2012

HISTORICAL RESOURCES SUBMITTAL- JULY 20, 2012

PERMIT SUBMITTAL- SEPTEMBER 20, 2012

"AS-BUILTS" SUBMITTAL- JUNE 2, 2014

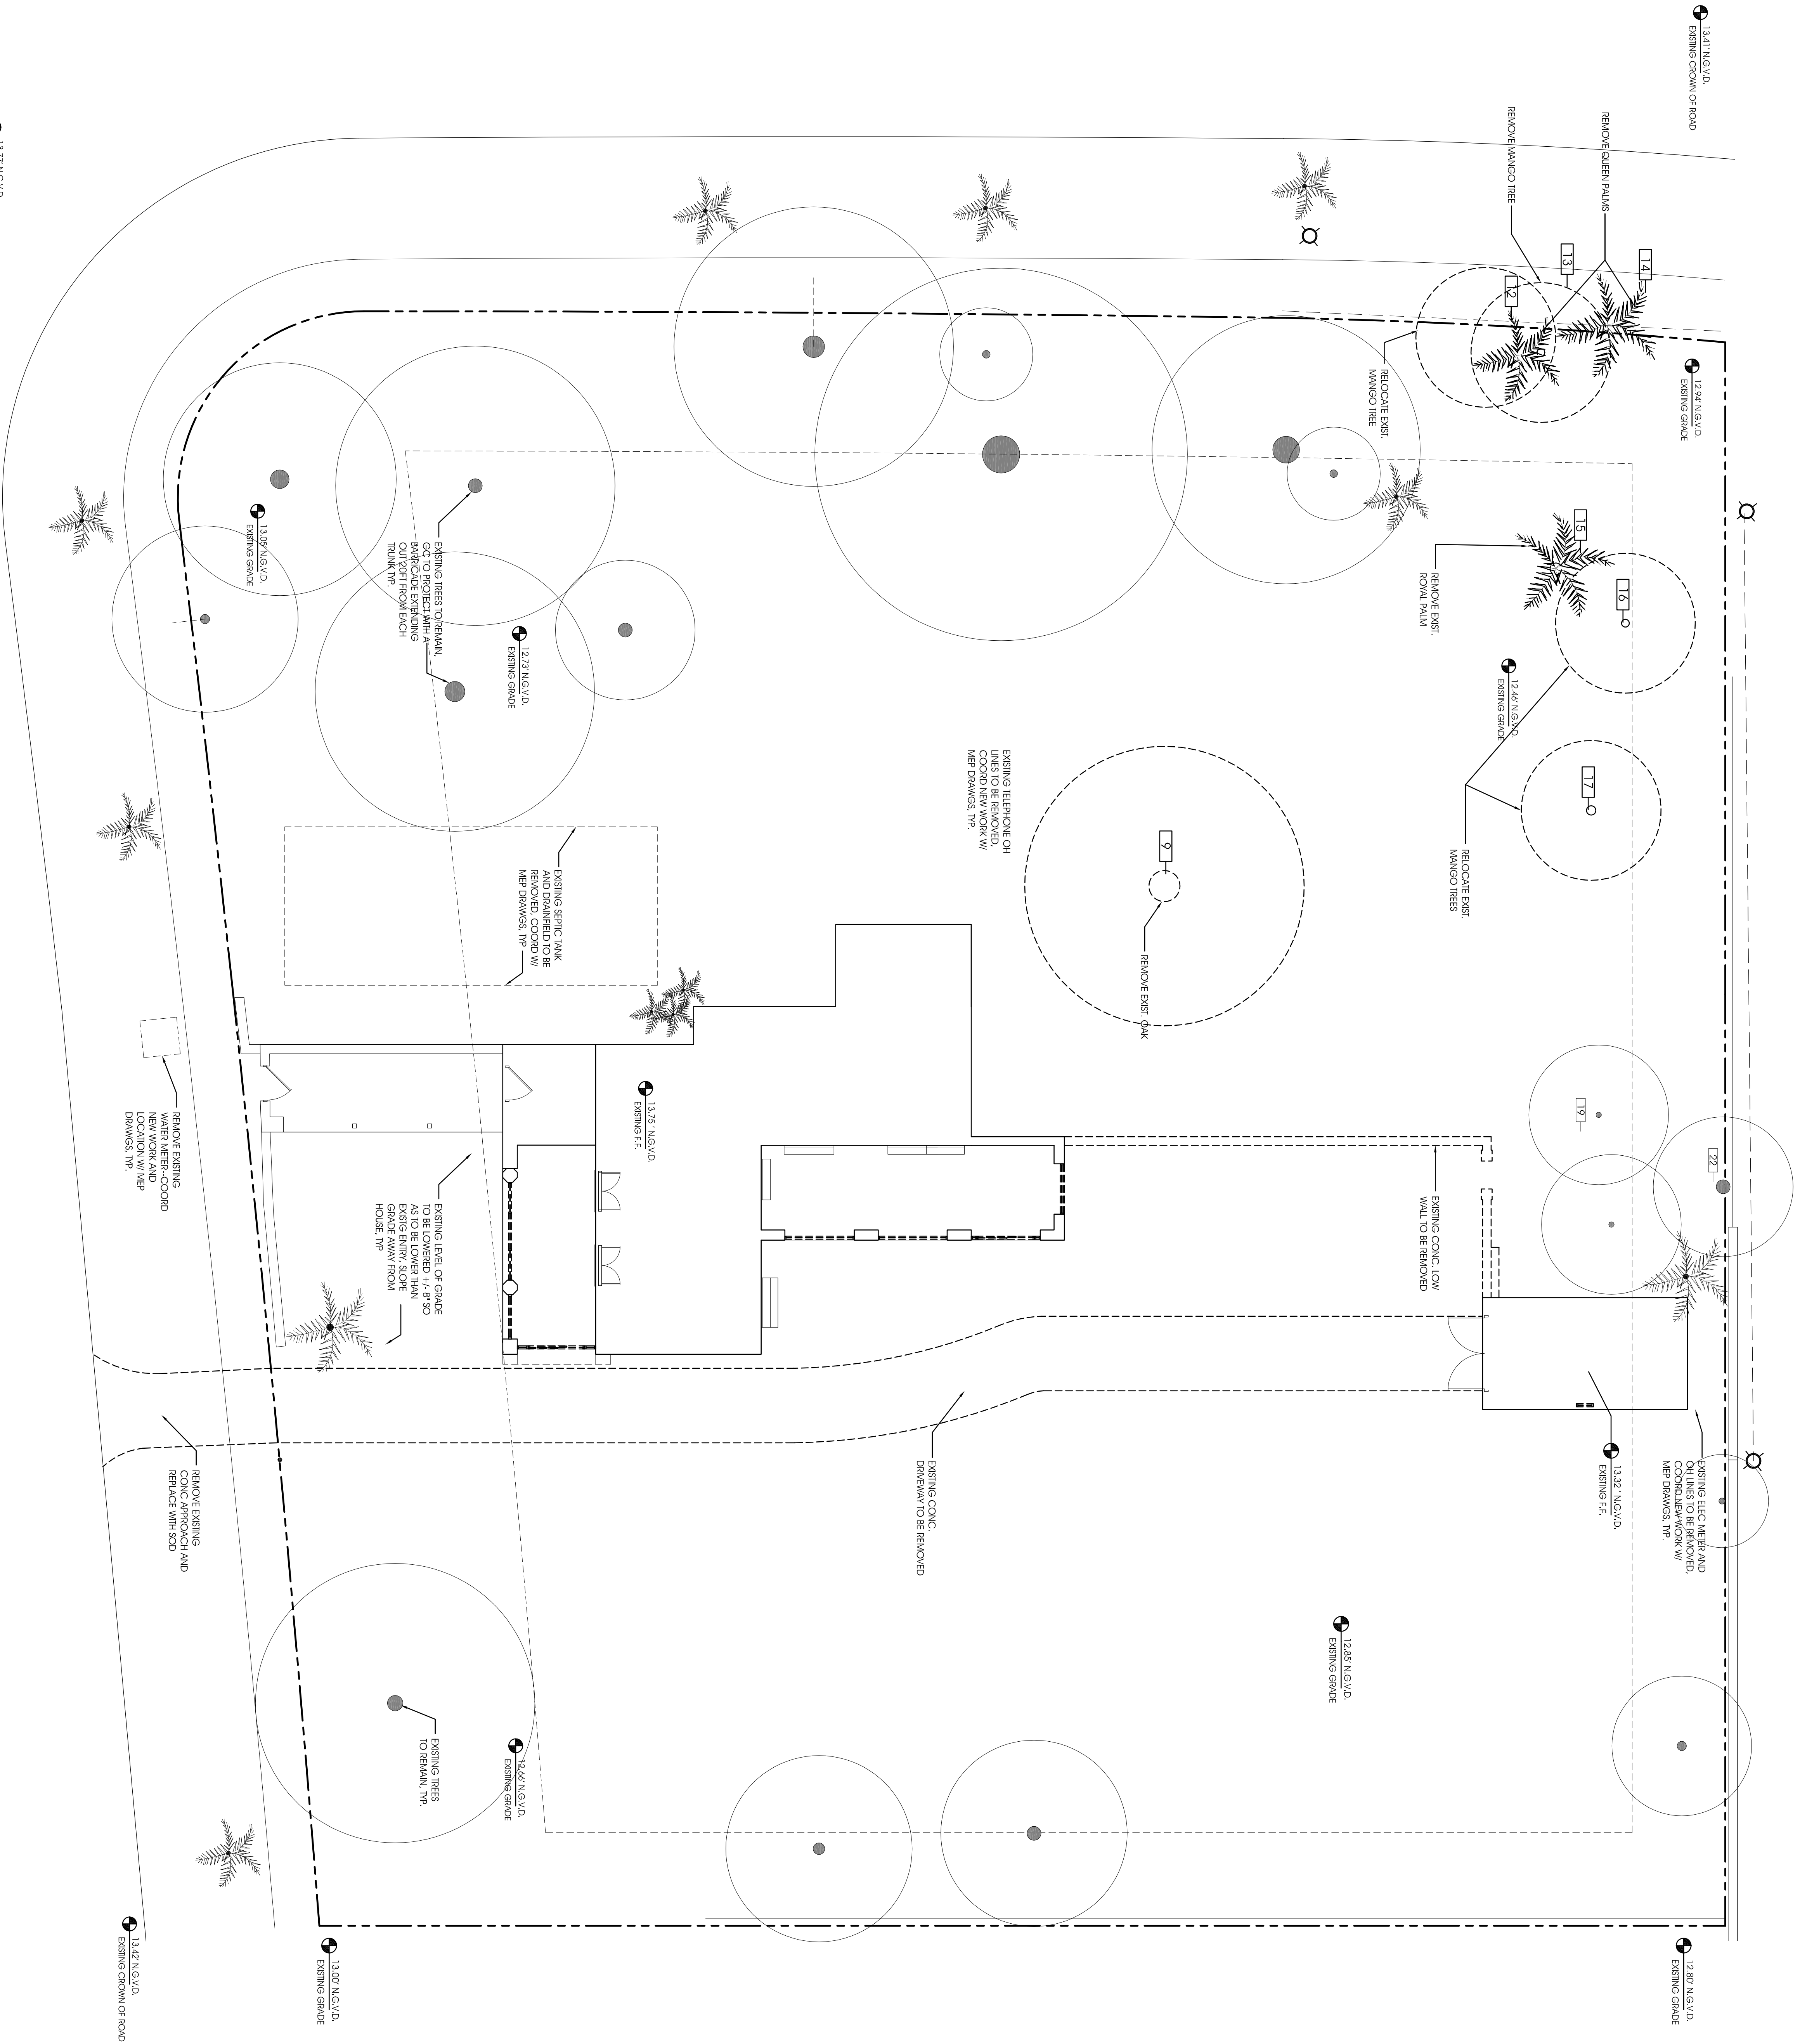

LOCUS ARCHITECTURE
1500 N. 10th St., Suite 307
Coral Gables, FL 33146
Tel: (305) 740-0120
Fax: (305) 740-0120
Email: info@locusarch.com
License No. AA000733

CONSULTANT

NO.	REVISION/ISSUANCE	DATE
01	OWNER REVIEW	04/19/2012
02	REVISION: OWNER REVIEW	05/02/2012
03	REVISION: OWNER REVIEW	05/24/2012
04	REVISION: OWNER REVIEW	07/12/2012
05	REVISION: OWNER REVIEW	07/20/2012
06	REVISION: OWNER REVIEW	08/01/2013
07	REVISION: OWNER REVIEW	08/02/2014

PROJECT
Oliveira Residence
Remodeling & Additions

441 S.W. 14th St., Suite 307
Coral Gables, Florida 33134

DRAWING
Site Demolition Plan

SCALE
1/8" = 1'-0"

DRAWN
ML

REVIEWED
ME


DATE
06/22/2014

PROJECT NO.
AR 13957

SHEET NO.
A-02

SITE DEMOLITION PLAN

SCALE: 1/8" = 1'-0"

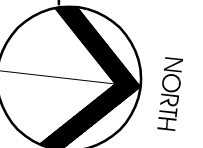

EXISTING WINDOW
TO BE REPLACED WITH
NEW IMPACT RATED, TP.

BUILDING
REPAIR ANY DAMAGED
WOOD RAFTERS
PATCH AND REPAIR
CONC SLAB AS NEEDED

REPAIR EXISTING WOOD
DOORS, RESTORE TO
FUNCTIONAL CONDITION

[25]

EXISTING CONC. LOW WALL TO BE REMOVED

EXISTING CONC.
DRIVEWAY TO BE REMOVED



Locus
ARCHITECTURE

Corral Gables, FL 33146
Tel (305) 740-0120
Fax (305) 740-0520
License No. AA0002733

CONSULTANT(S)

NO.	REVISION/SUBMISSION	DATE
	OWNER REVIEW	04/19/2012
	PERMITS REVIEW	05/02/2012
	REVISION SUBMITTAL	05/02/2012
	TREE PROTECTION AGREEMENT	05/24/2012
	CONTRACTOR ASSIGNMENT	07/12/2012
	8.O.A. REVIEWER'S SUBMITTAL	07/20/2012
	HISTORICAL RESOURCES STUDY	07/20/2012
	PERMITS SUBMITTAL	09/20/2012
	PERMITS REZONING	06/01/2013
	"AS-BUILT"	04/01/2013

**Olivera Residence
Remodeling & Additions**

641 San Lorenzo Avenue
Coral Gables, Florida 33134

DRAWING

**First & Second Floor
Demolition Plan**

DRAWN	NELSON DE LEON AR 13937
BG	
REVIEWED	PROJ. NO. 166.0
NEL	

A-03



DEMOLITION PLAN LEGEND

ELECTRICAL DEMOLITION NOTES

1. CONTRACTOR IS TO VERIFY WITH OWNER AND DESIGN ALL EXISTING AND EXPOSED UTILITIES TO BE REMOVED PRIOR TO REMEDIATION. WATER, GAS, LIQUIDS, COMBUSTIBLES, ETC. NOT TO BE BROUGHT WITHIN REACH OF REMEDIAL SPRAY OR CONTAINMENT.
2. LOCATIONS OF ALL EXISTING UTILITIES TO BE IDENTIFIED AND MARKED BY THE CONTRACTOR. ALL EXISTING PIPING, APPROPRIATELY SIZED, SHALL BE PROTECTED BY THE CONTRACTOR. ALL EXISTING CABLES, TV CABLES, MICROPLASTIC DATA SYSTEM WIRING, POWER CONDUITS, COUPLING ELECTRICAL BOXES, RACEWAYS AND OTHER ELECTRICAL SYSTEM COMPONENTS SHALL BE IDENTIFIED AND MARKED BY THE CONTRACTOR PRIOR TO REMEDIATION.
3. ALL EXISTING UTILITIES SHALL BE PROTECTED BY THE CONTRACTOR PRIOR TO REMEDIATION AND SHALL BE CUT FLUSH, PLUGGED AND ABANDONED AFTER ALL CONNECTIONS ARE REMOVED. NO WIRING SHALL BE LEFT ABANDONED AFTER WORK IS COMPLETED.
- SEE ELECTRICAL SHEETS FOR DETAILS.


PLUMBING DEMOLITION NOTES

1. CONTRACTOR SHALL VERIFY WITH OWNER PRIOR TO DEMOLISHING ALL EXISTING SHIMS AND W/C TO BE REMOVED OR RELOCATED.
2. UNLESS OTHERWISE NOTED AS EXISTING TO REMAIN OR TO BE RELOCATED, ALL PLUMBING FIXTURES LOCATED IN THE AREAS SHOWN AS BEING DEMOLISHED, AND NOT IDENTIFIED AS EXISTING TO REMAIN OR TO BE RELOCATED, SHALL BE CUT OFF, FLUSH, PLUGGED AND ABANDONED AFTER FIXTURES ARE REMOVED.
3. SEE PLUMBING SHEETS FOR DETAILS.

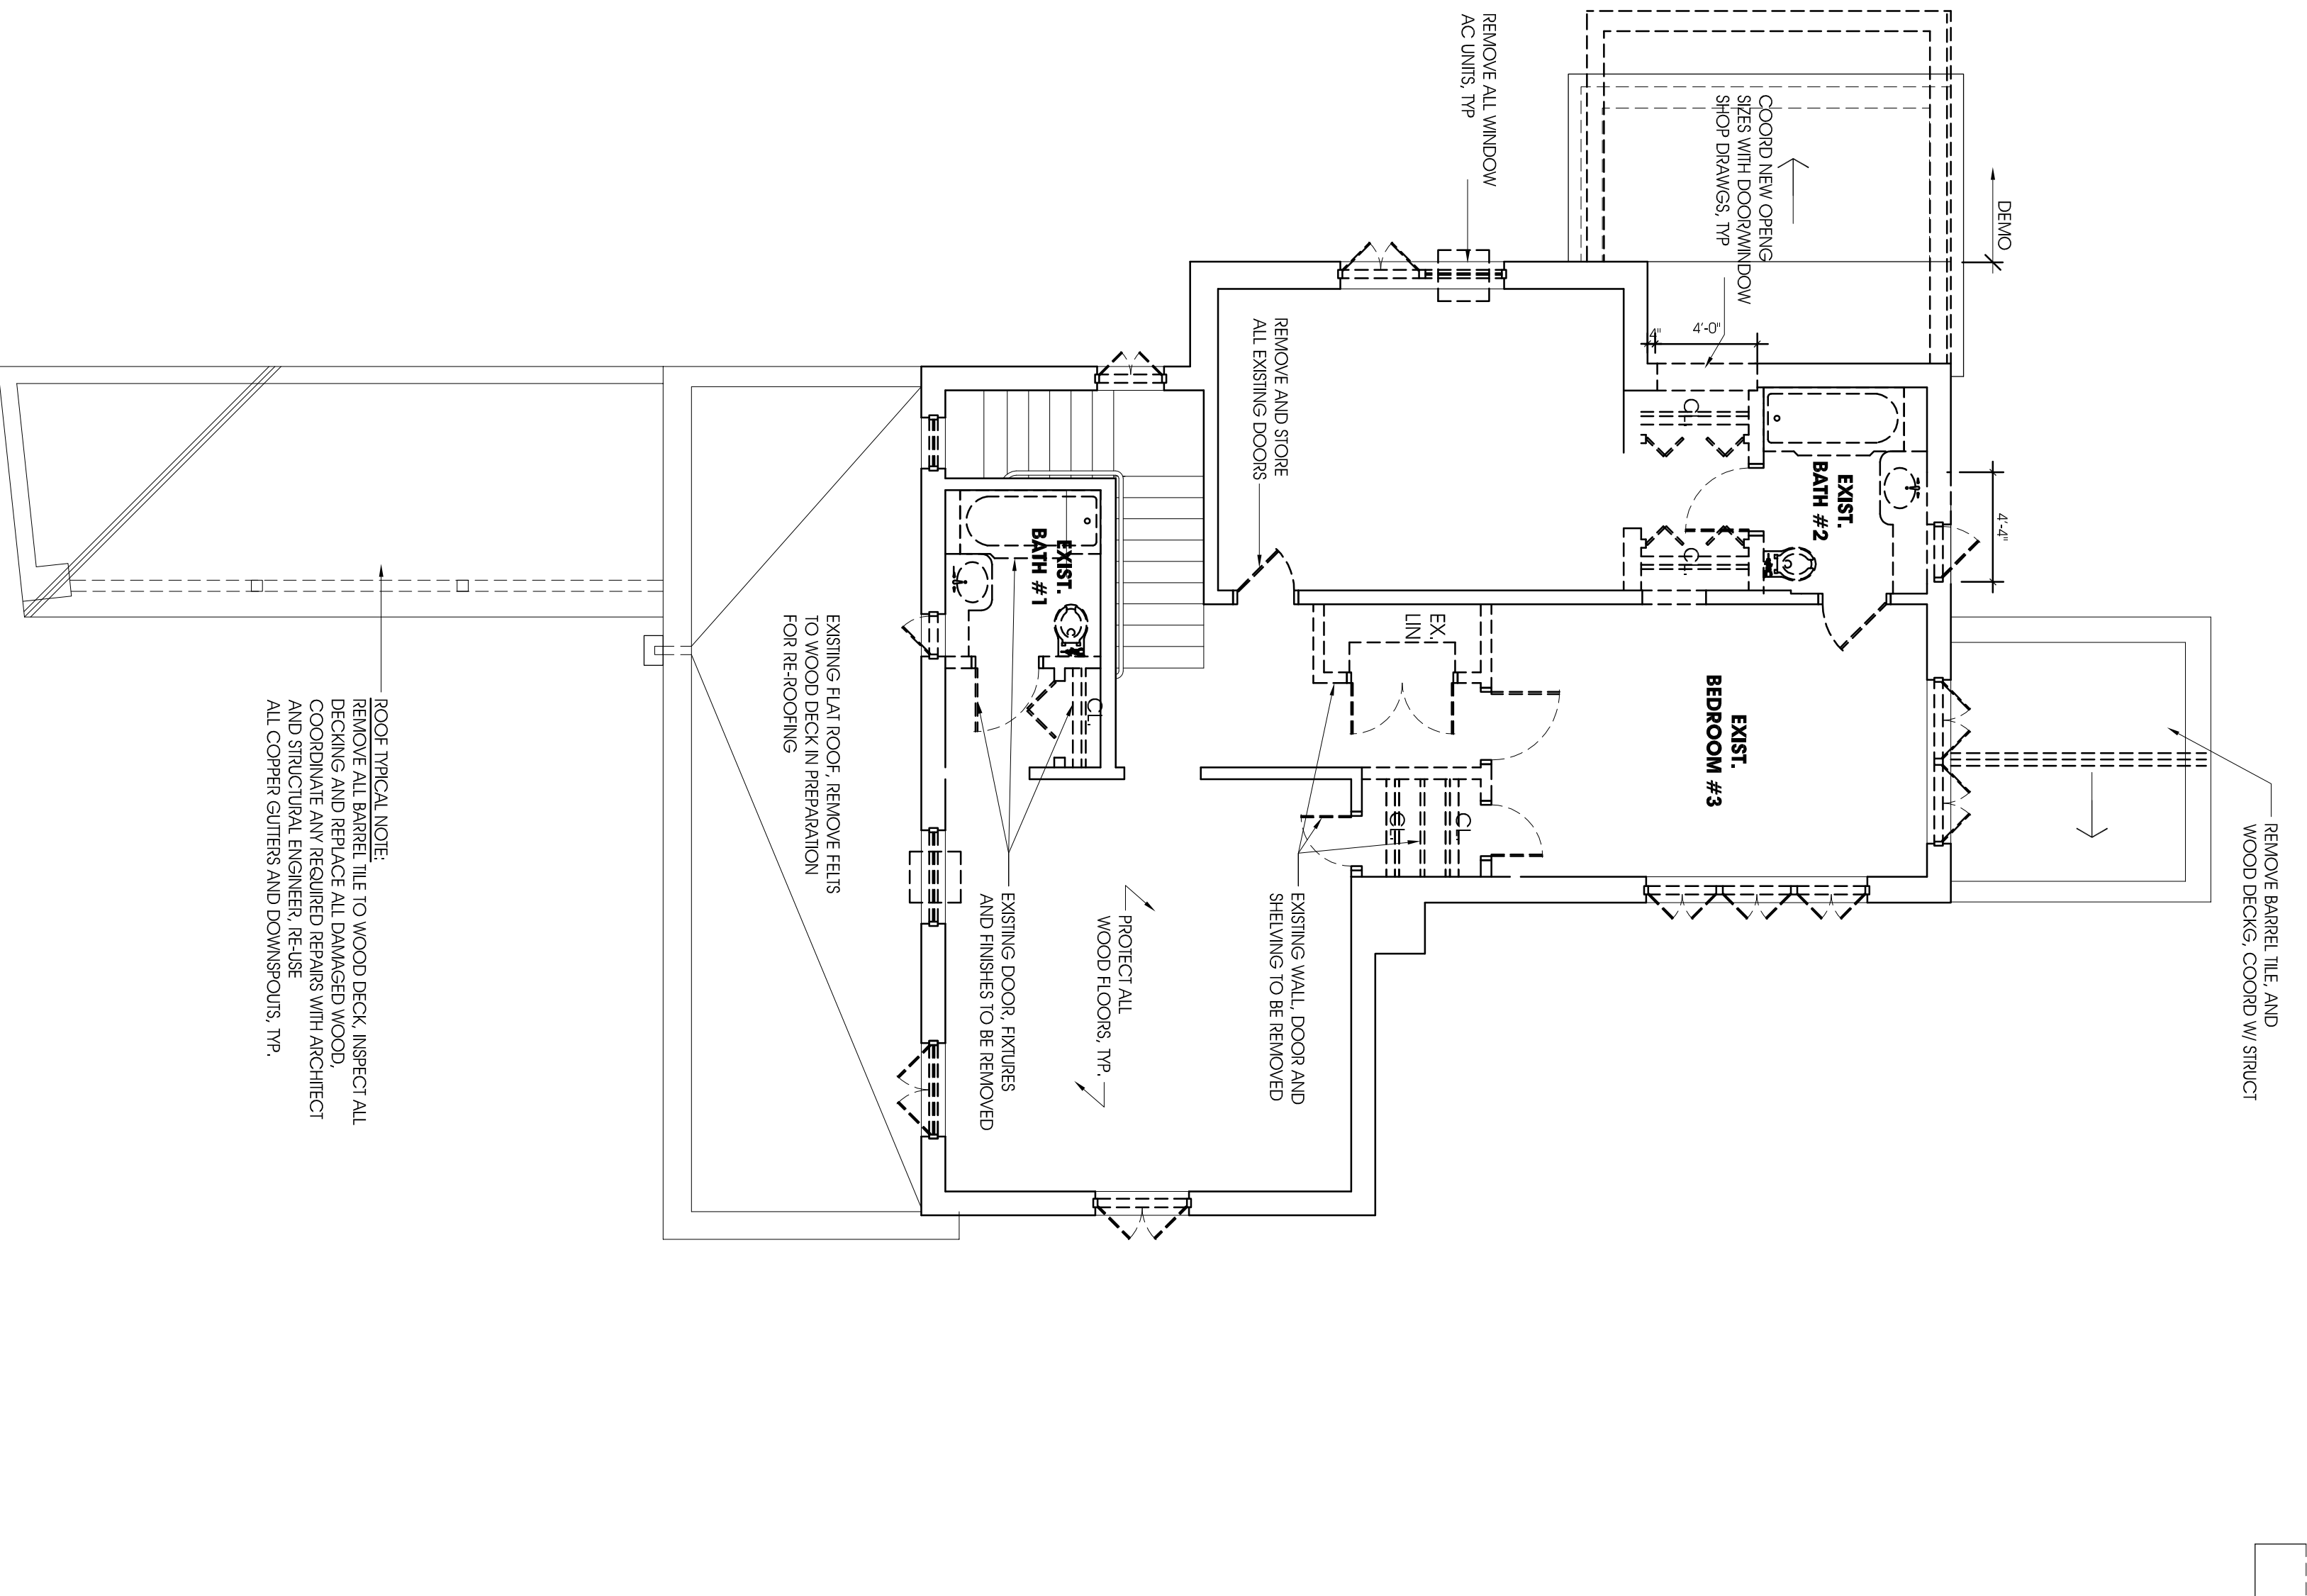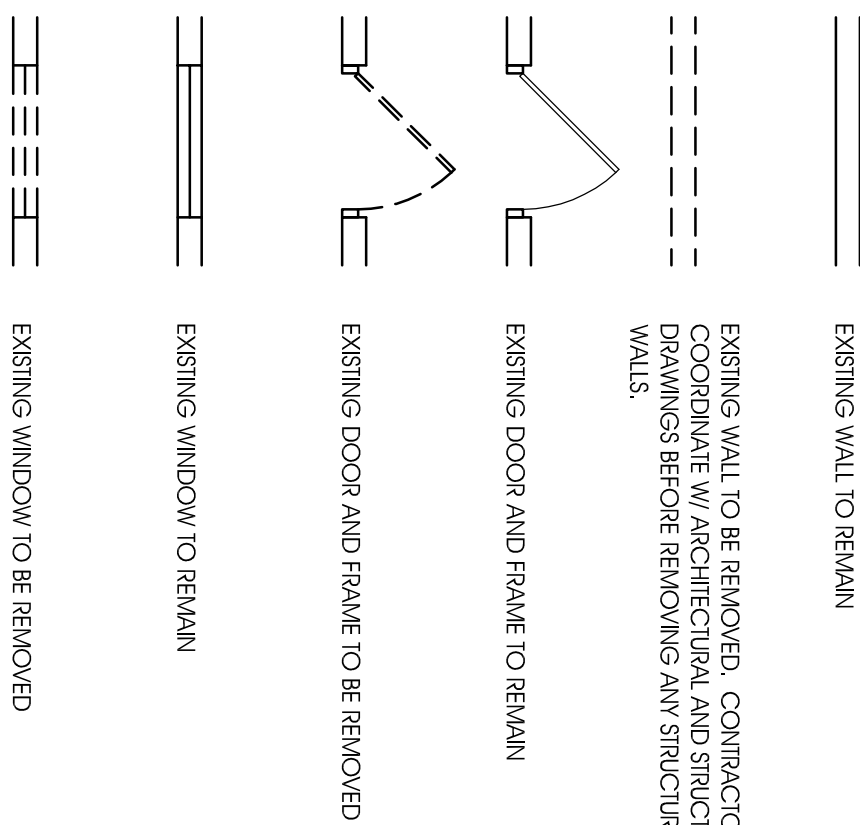


SECOND FLOOR DEMOLITION PLAN

SCALE: 3/16" = 1'-0"

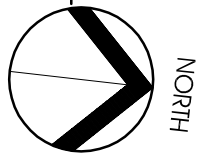


FIRST FLOOR DEMOLITION PLAN

SCALE: 3/16" = 1'-0"

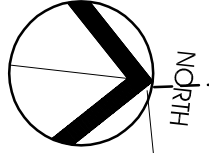

NOTE: ① ALL MATERIAL FINISH TO REMAIN

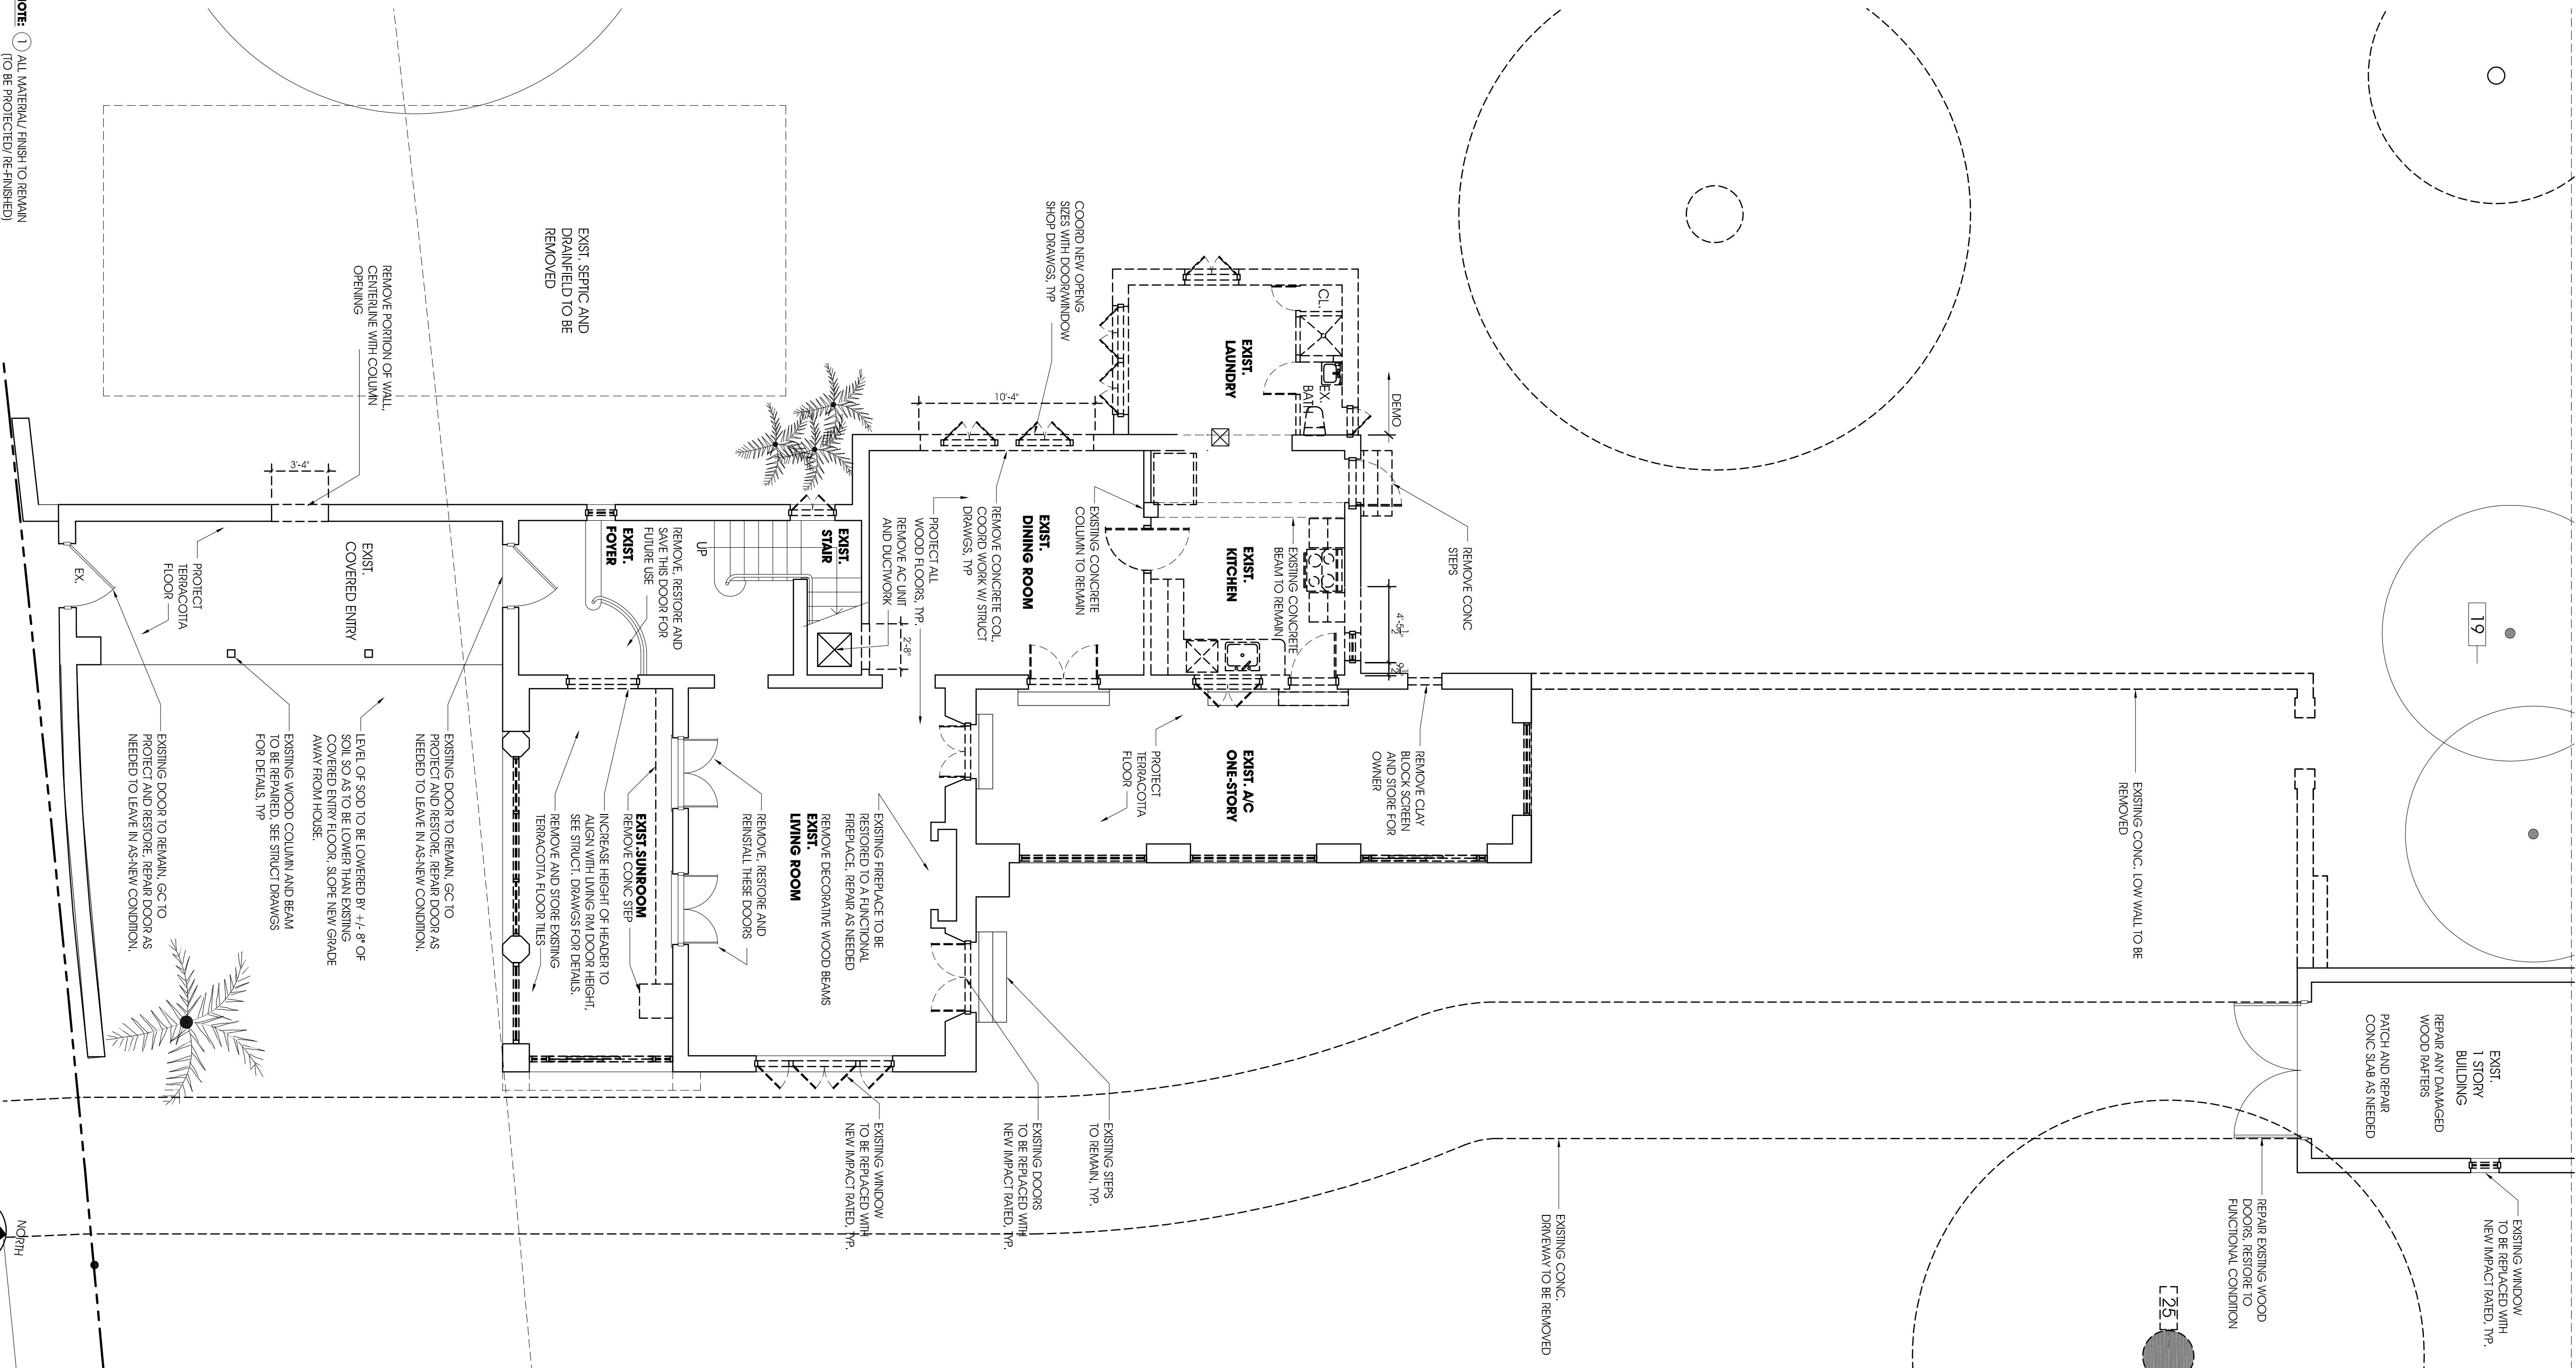

 **Locus**
ARCHITECTURE
INCORPORATED

500 South Dixie Highway, Suite 307
Coral Gables, FL 33146
Tel (305) 740-0120
Fax (305) 740-0520
License No. AA0002733

CONSULTANTS


NO.	RESPONSE/SUBMISSION	DATE
	OWNER REVIEW	01/10/2012
	PLANS WORKSHEET	03/07/2012
	REMARKS SUBMITTAL	05/24/2012
	REMARKS SUBMITTAL	05/24/2012
	COMMITTEE DISCUSSION	07/12/2012
	B.O.A. PRELIMINARY SUBMITTAL	07/23/2012
	HISTORICAL RECORDS SIGN	09/20/2012
	FINAL SUBMITTAL	09/20/2012
	PREPARE REMARKS	09/21/2013
	REMARKS	06/03/2014

PROJECT

**Olivera Residence
Remodeling & Additions**


641 San Lorenzo Avenue
Coral Gables, Florida 33134

DEWMING	SCALE
First Floor Proposed Plan	3/16" = 1'-0"
SEAL	DEWMING
	RG
	RETURNING
	NEL
Nelson de Leon ME 19757	PROJ. NO.
	166.0

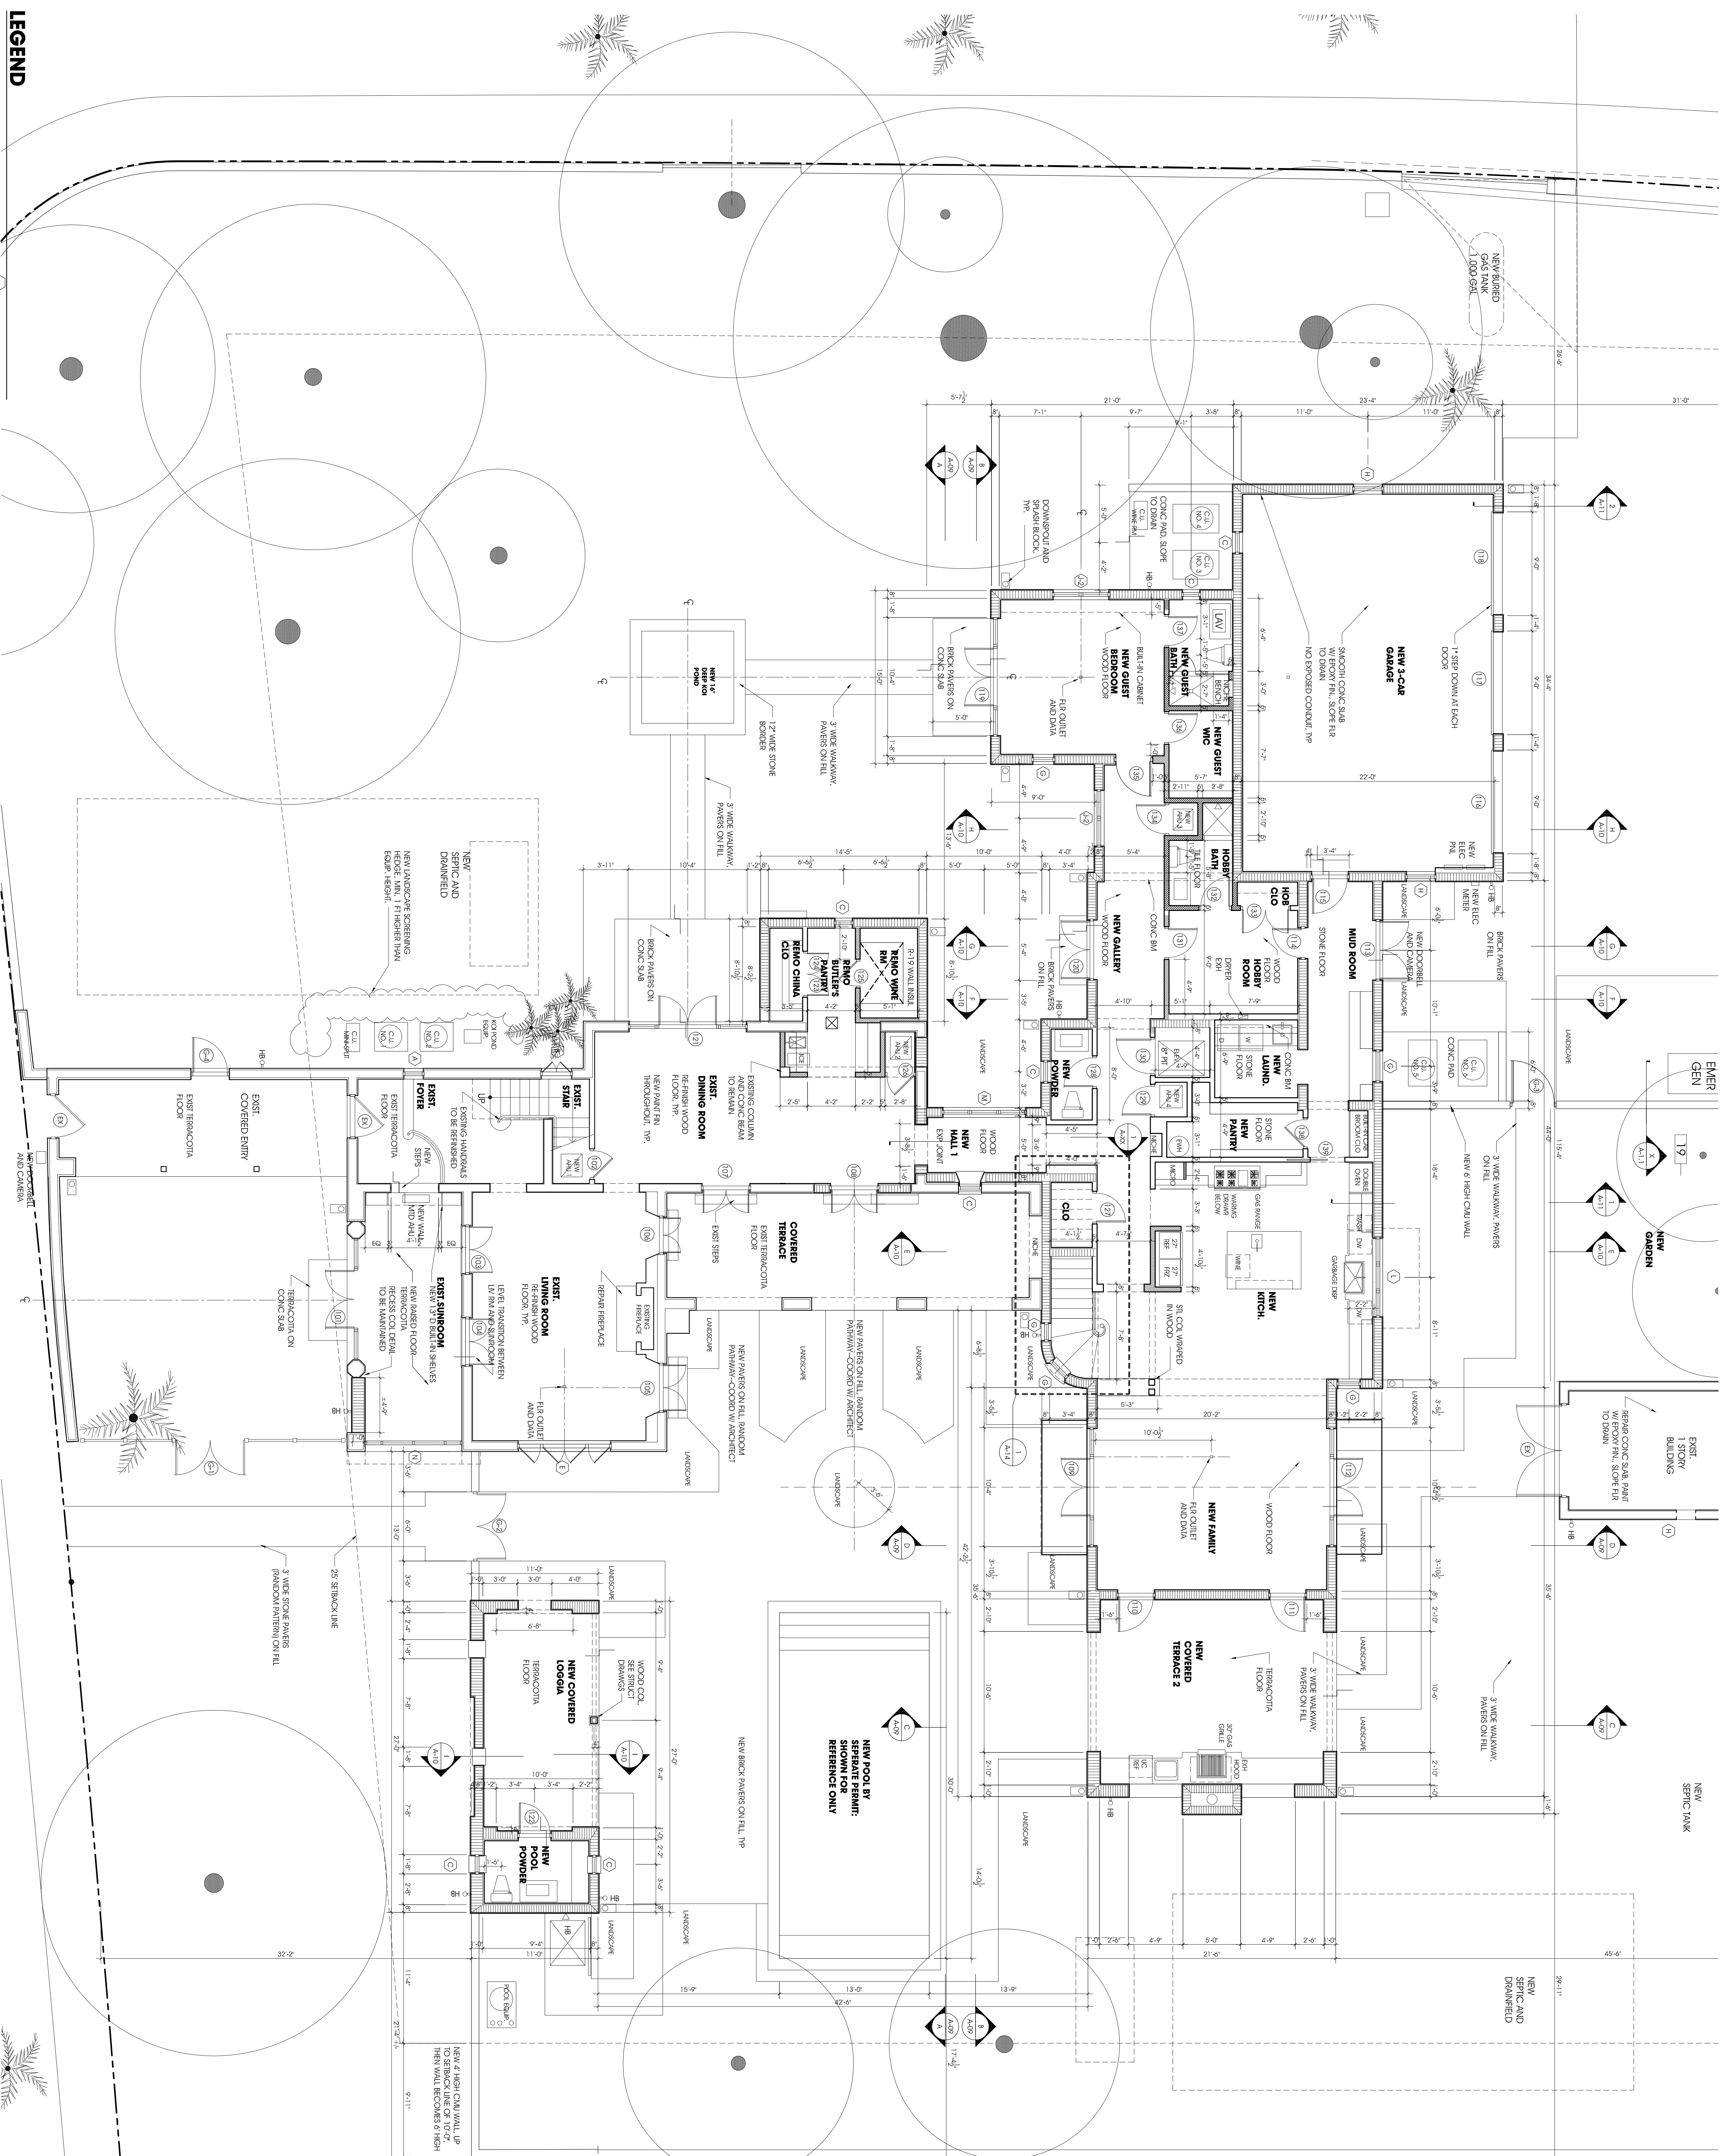


FIRST FLOOR PROPOSED PLAN

SCALE: 3/16" = 1'-0"

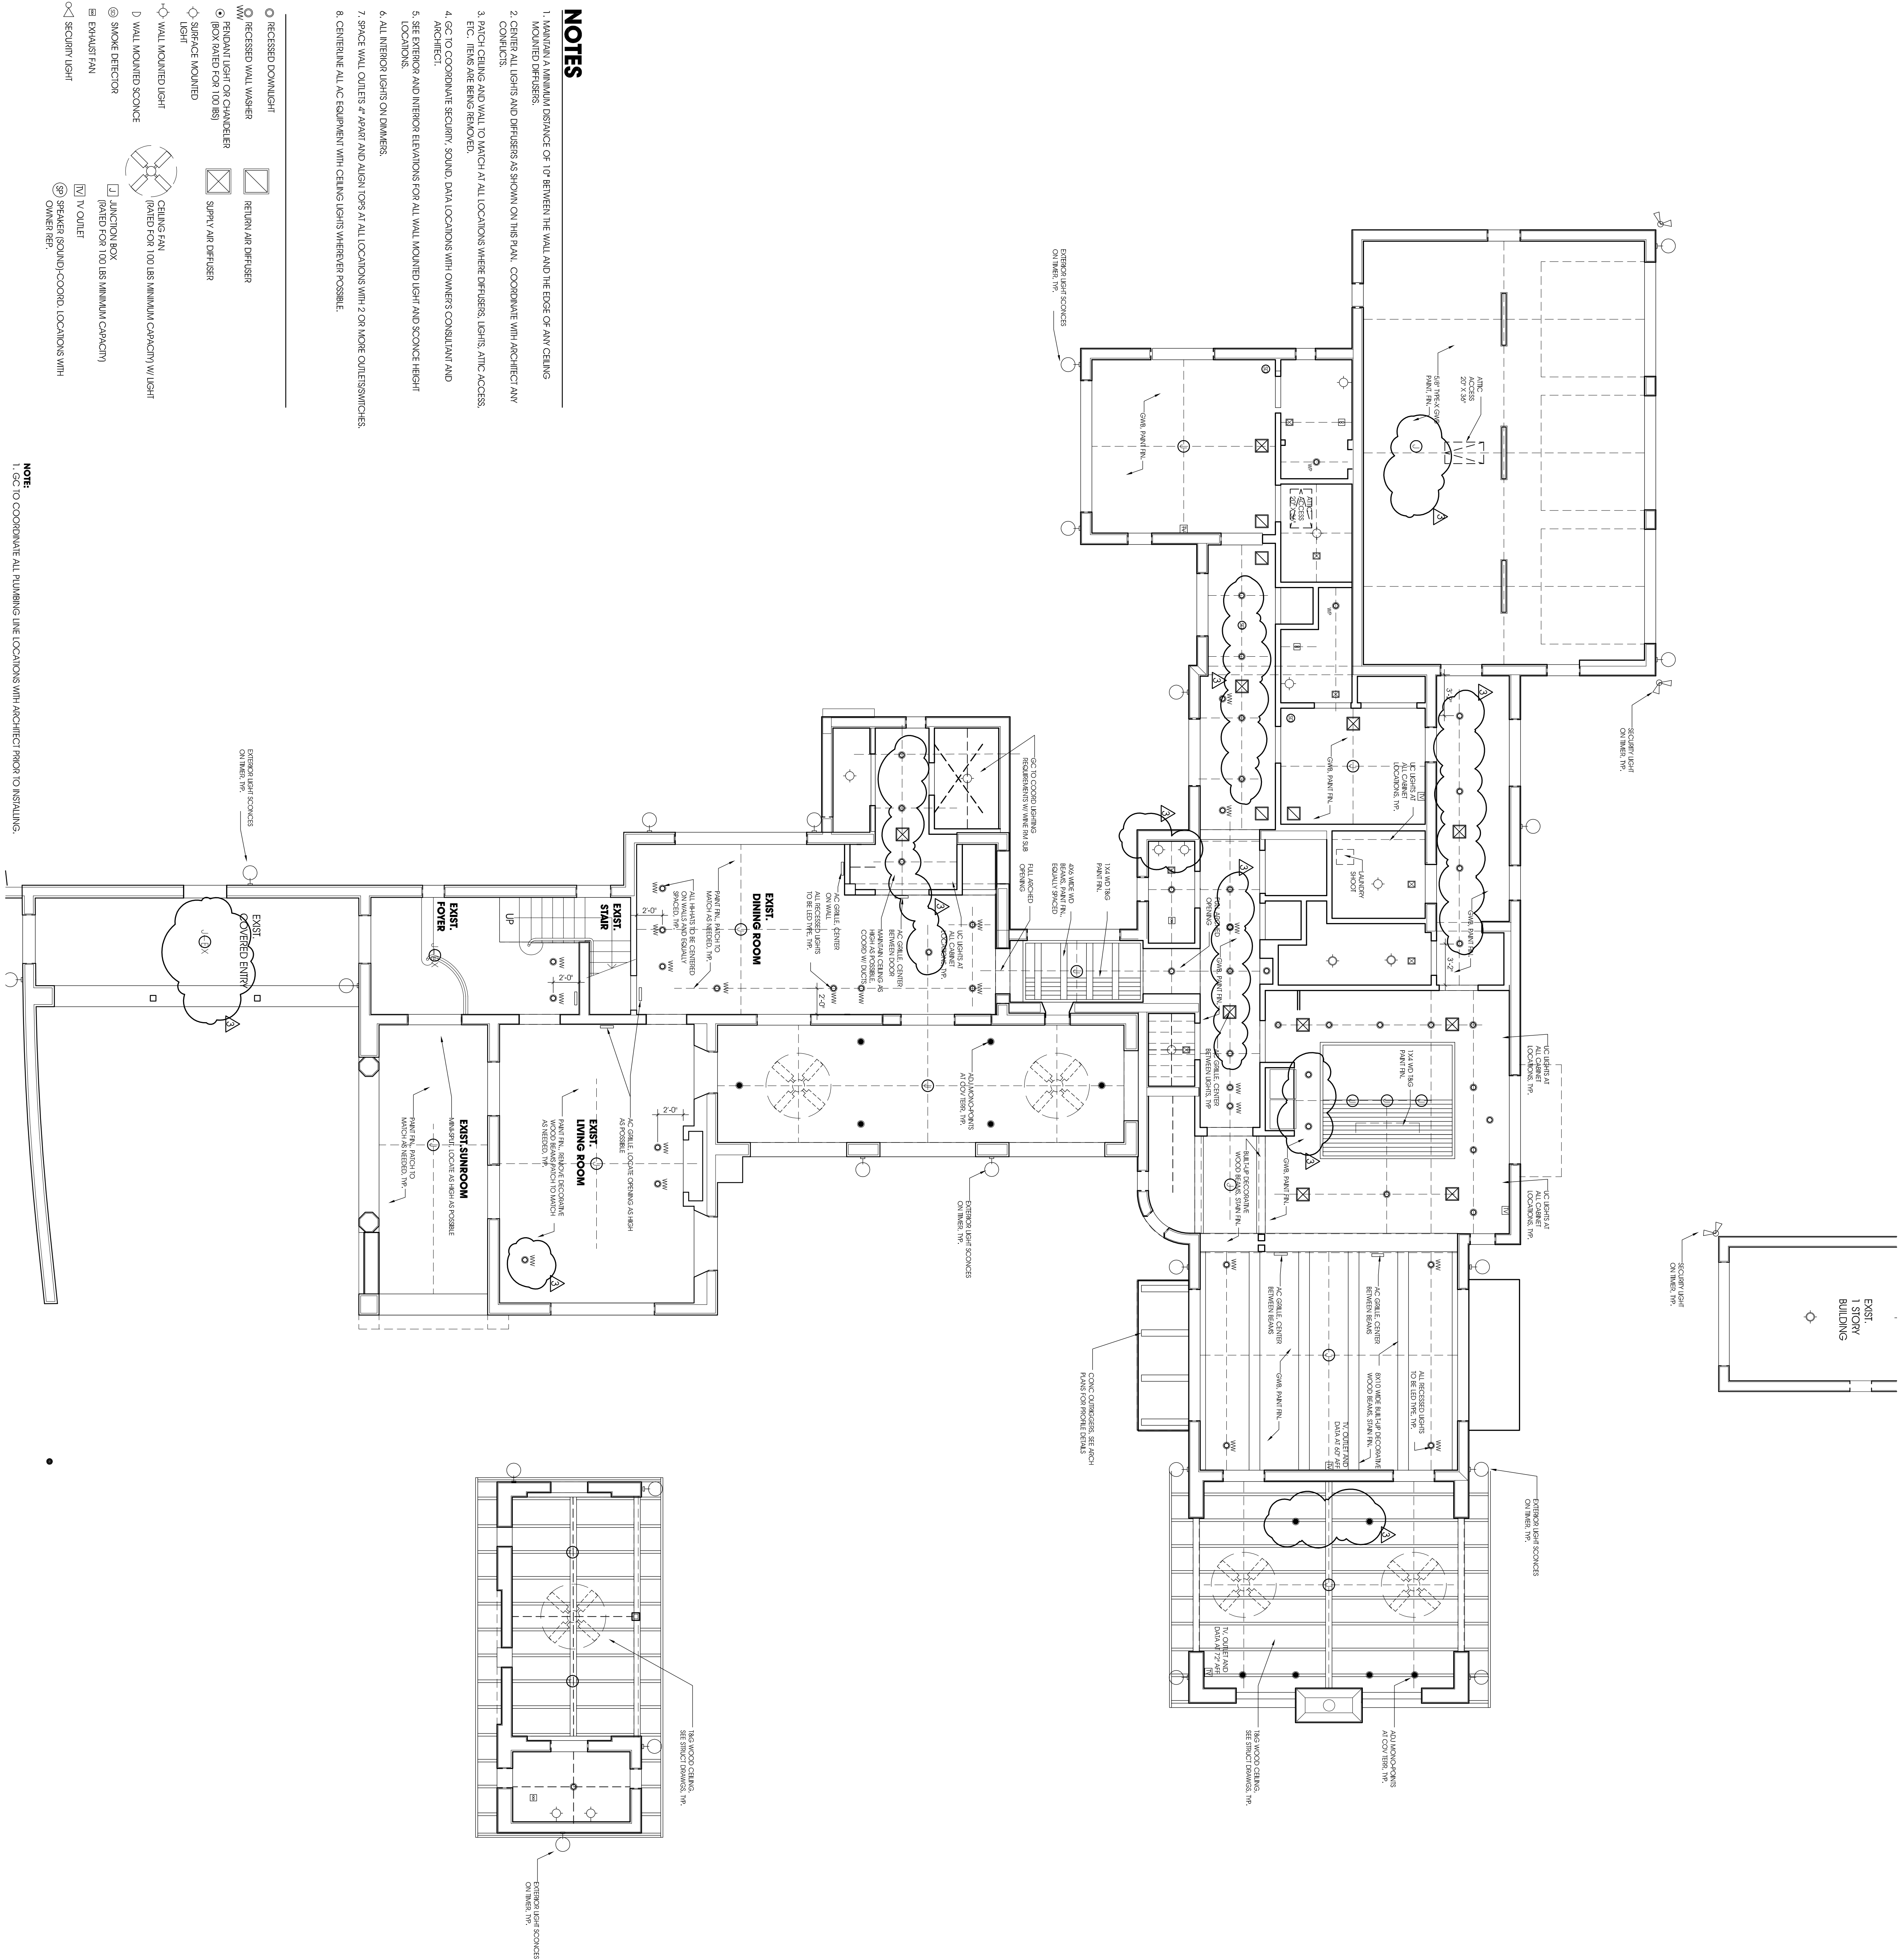[illegible]


NO.	PURPOSE/SUBMISSION	DATE
	COVER REVIEW	06/17/2012
	BASIC WORKSHEET	08/02/2012
	PROFESSIONAL APPRAISAL	09/24/2012
	COMPLAINT APPLICATION	05/24/2012
	E.O.A. PRELIMINARY SUBMITTAL	07/17/2012
	HISTORICAL RESOURCES SURVEY	07/20/2012
	PRELIM SUBMITTAL	09/20/2012
	FINAL REVISIONS	06/01/2013
	"YES-QUALITY"	06/20/2014

 **Locus**
ARCHITECTURE
INCORPORATED

500 South Dale Highway, Suite 307
Coral Gables, FL 33146
Tel. (305) 740-0120
Fax. (305) 740-0520
License No. A44000233

CONSULTANTS

<p>DRAWING</p> <p>Second Floor Proposed Plan</p>	<p>SCALE</p>
<p>SCALE</p> <p>3/16" = 1'-0"</p>	<p>DRAWN</p> <p>TM</p> <p>REVIEWED</p> <p>NEL</p> <p>PROJ. NO.</p> <p>166.0</p>

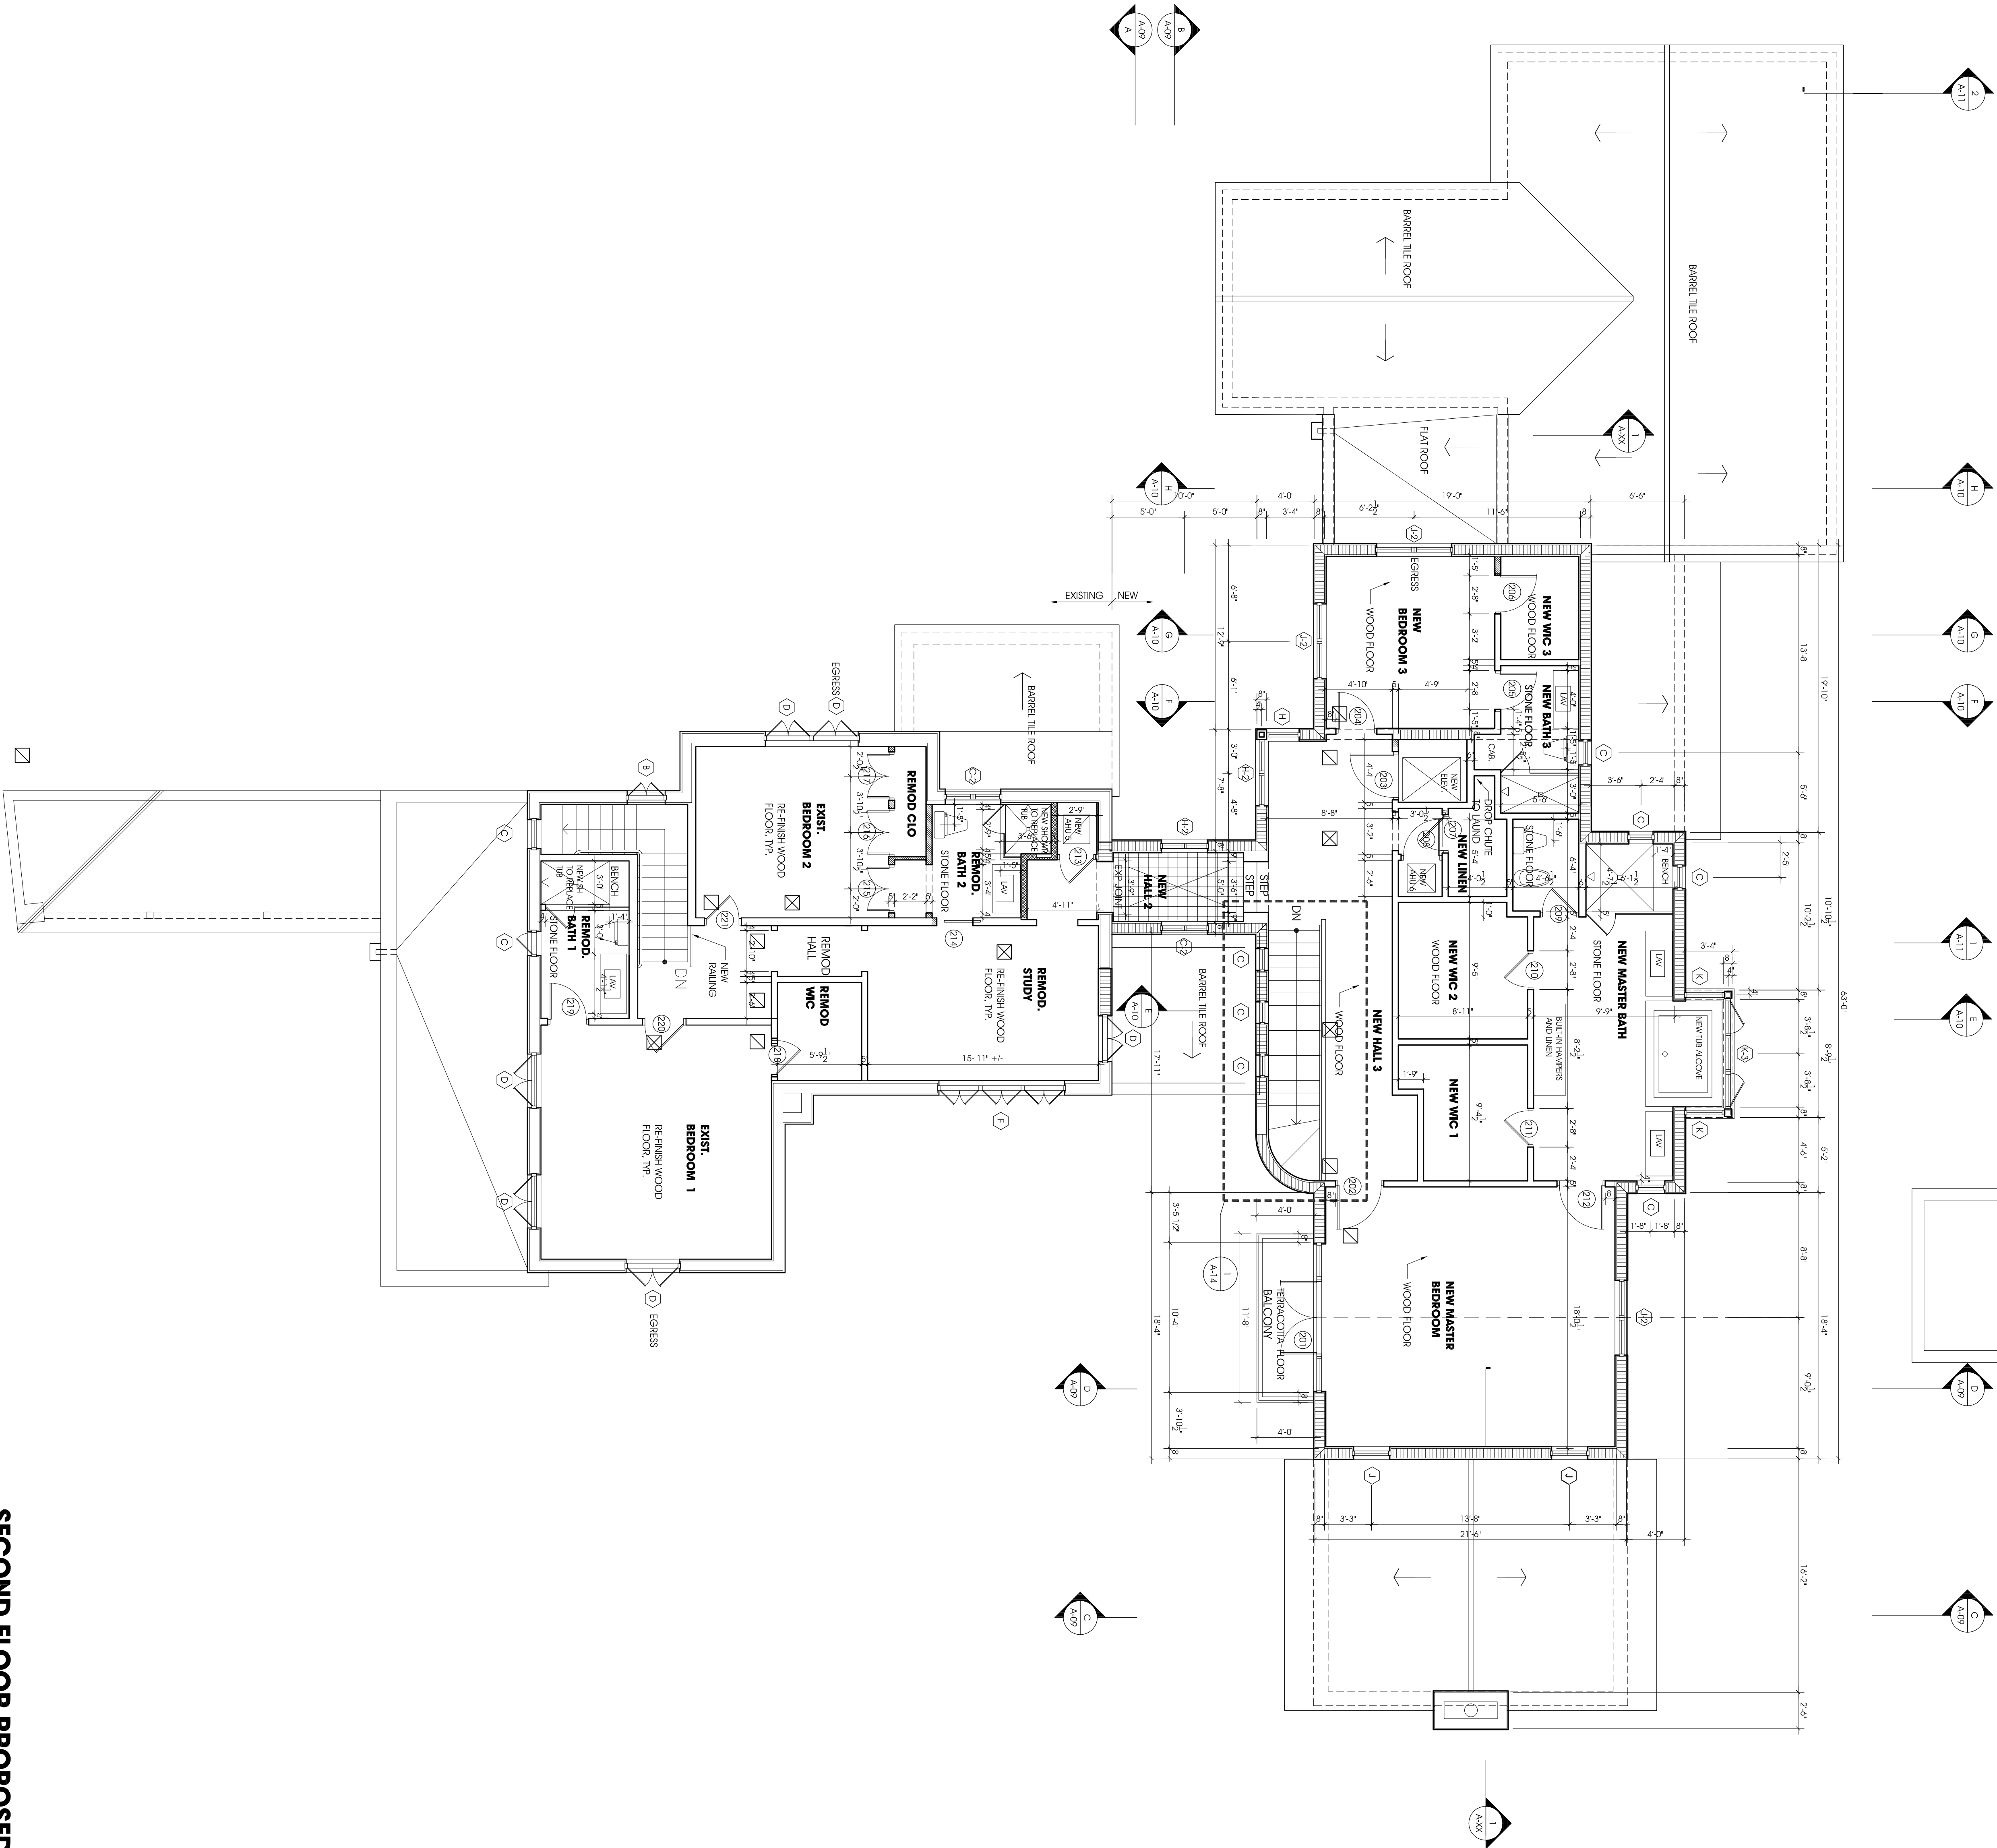

NO.	REVISION/SUBMISSION	DATE
01	OWNER REVIEW	04/10/2012
02	OWNER REVIEW	05/02/2012
03	REVISIONAL SUBMITTAL	05/24/2012
04	REVISIONAL SUBMITTAL	06/24/2012
05	R.O.A. PRELIMINARY SUBMITTAL	07/11/2012
06	REVISIONAL SUBMITTAL	07/20/2012
07	FINAL SUBMITTAL	09/20/2012
08	OWNER REVIEW	09/20/2012
09	REVISIONAL SUBMITTAL	09/20/2012
10	REVISIONAL SUBMITTAL	09/20/2012

PROJECT	


Olivera Residence
Remodeling & Additions

4441 Spadina Avenue
Toronto, Ontario, Canada M6S 1V4

DRAWING
Second Floor Proposed
Ceiling Plan





SCALE	SCALE
3/16" = 1'-0"	
DRAWN	TKL/HL
CHECKED	HL
DESIGNED	HL
DATE	06/20/12

PROJECT NO.	133937
SHEET NO.	A-05.1

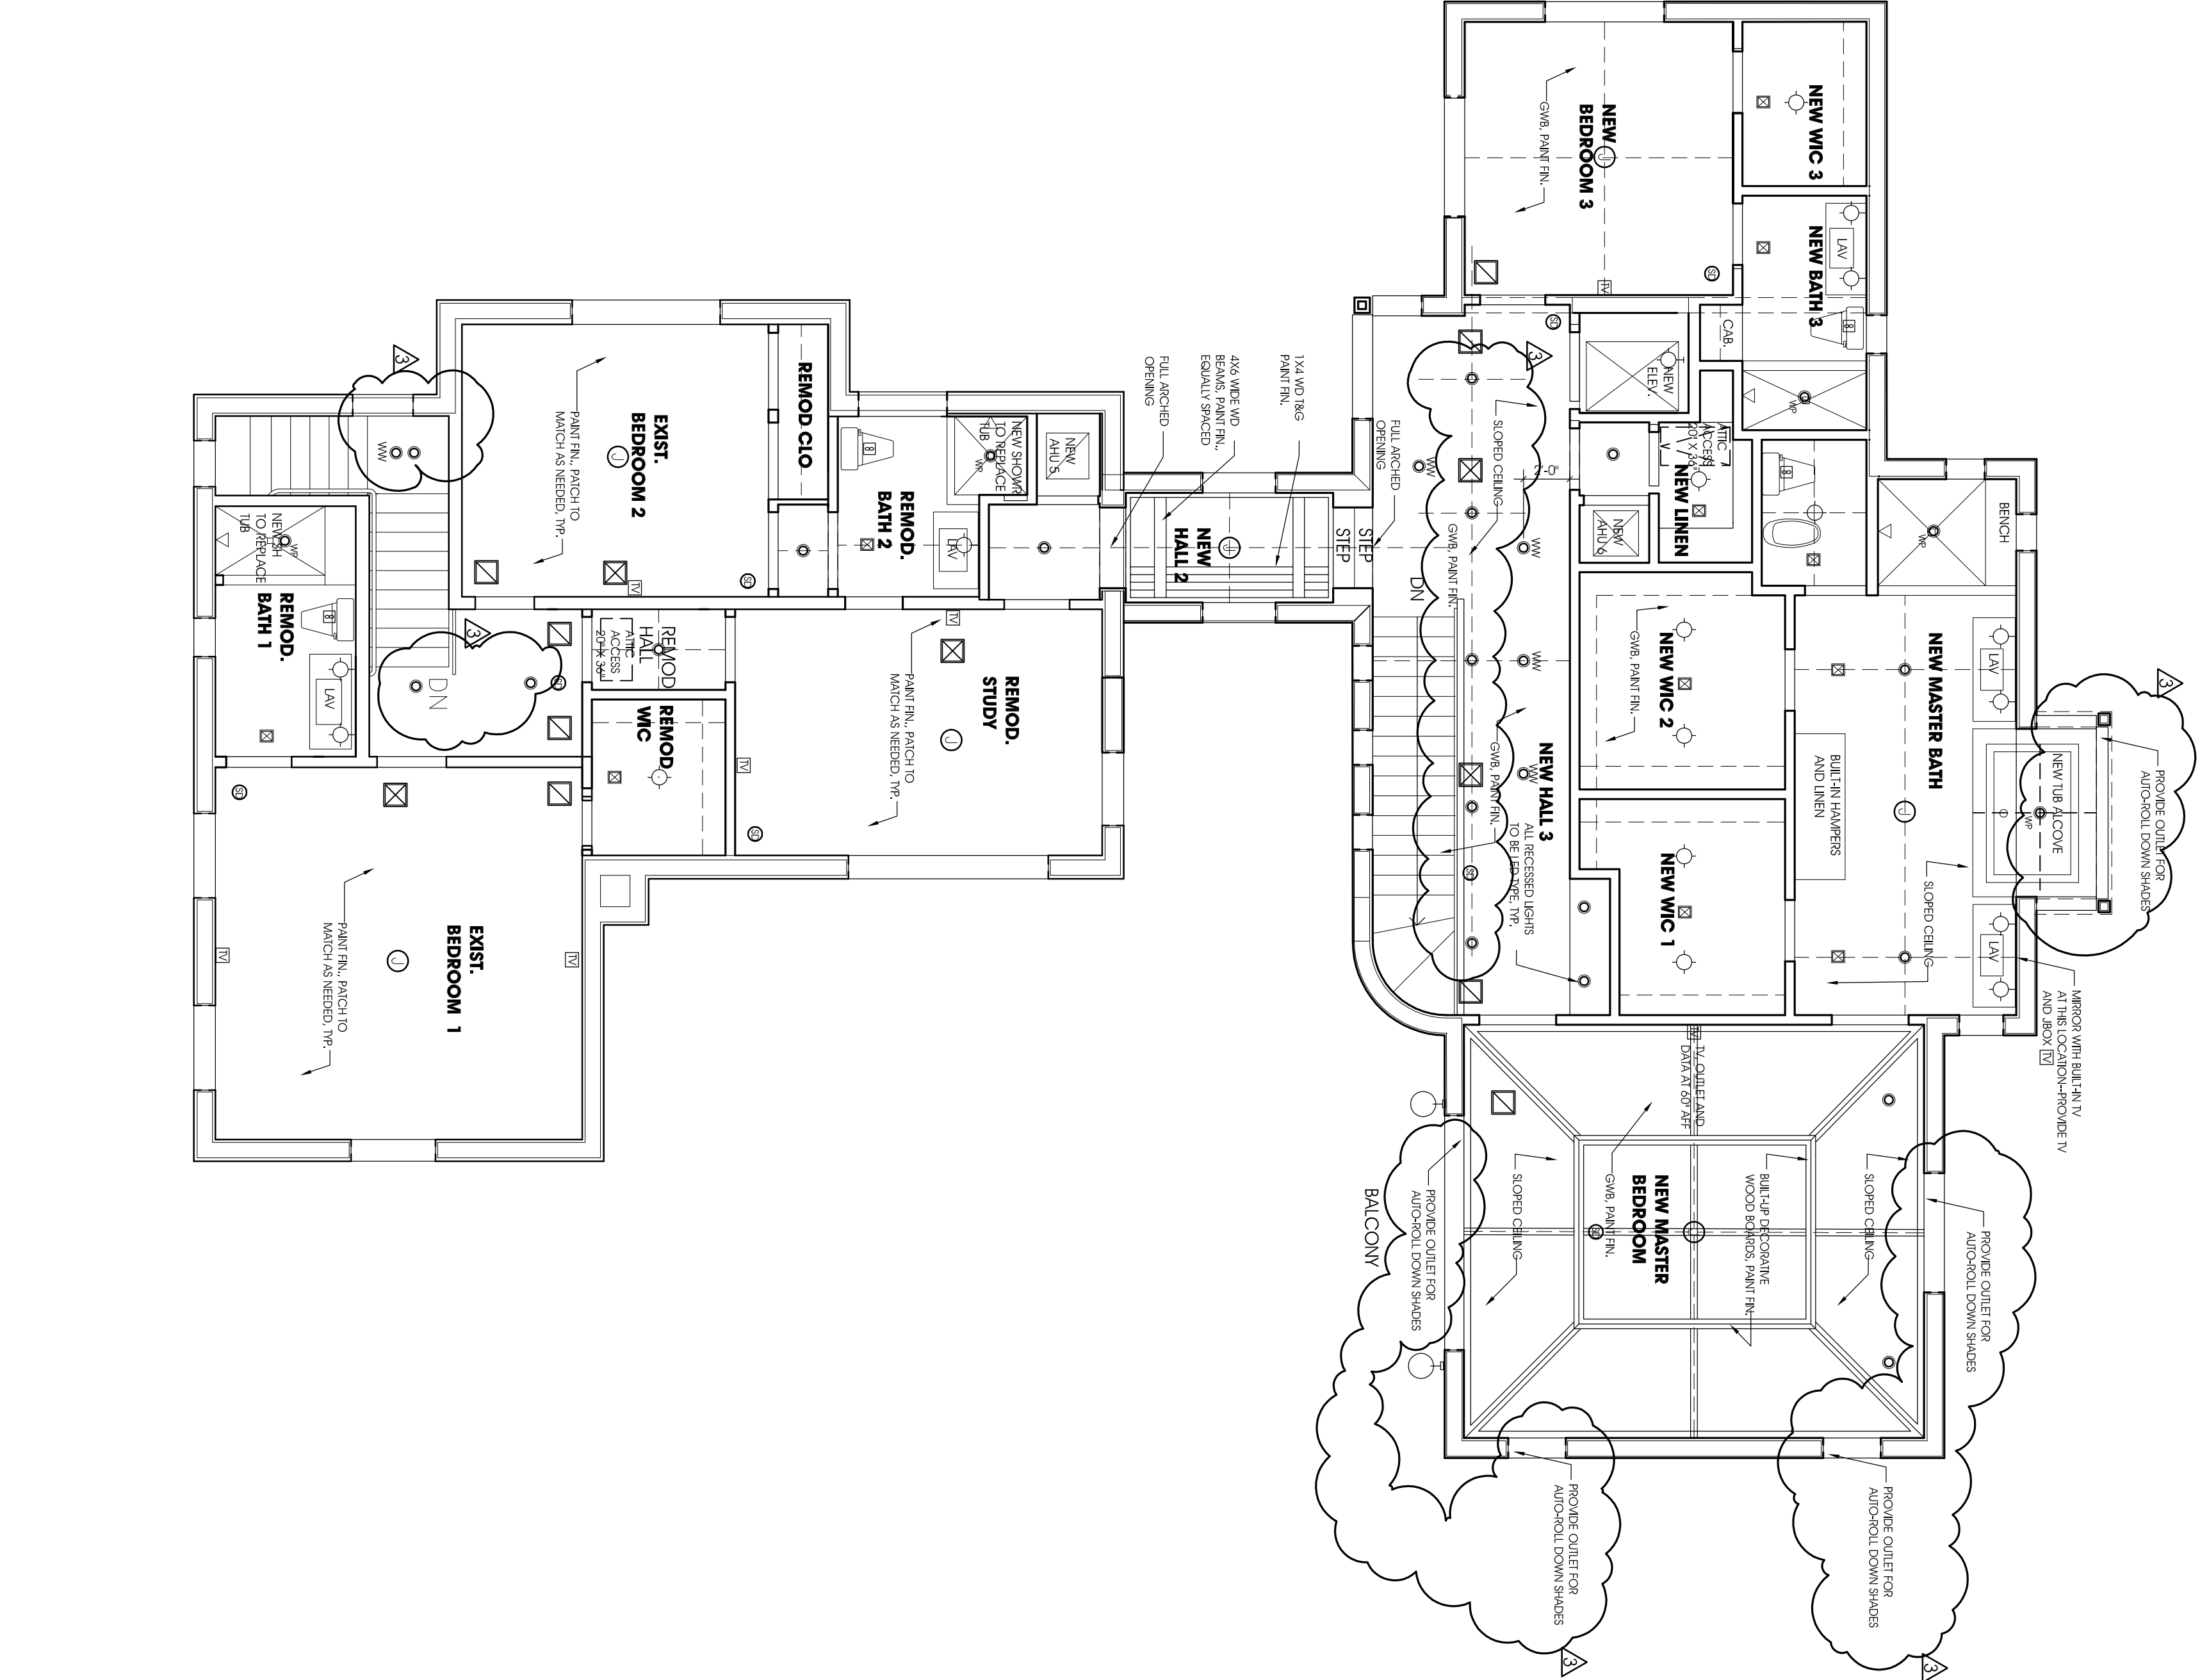

LEGEND

- RECESSED DOWNLIGHT
- RECESSED WALL WASHER
- PENDANT LIGHT FOR CHANDELER
- BOX RATED FOR 100 BS
- SURFACE MOUNTED LIGHT
- WALL MOUNTED LIGHT
- WALL MOUNTED SCONCE
- SMOKE DETECTOR
- EXHAUST FAN
- SECURITY LIGHT
- RETURN AIR DIFFUSER
- BOX RATED FOR 100 BS
- SUPPLY AIR DIFFUSER
- CEILING FAN
- RATED FOR 100 BS MINIMUM CAPACITY W/ LIGHT
- LUNARION BOX
- RATED FOR 100 BS MINIMUM CAPACITY
- TV CLOSET
- SPEAKER (SOUND-COORD. LOCATIONS WITH OWNER)

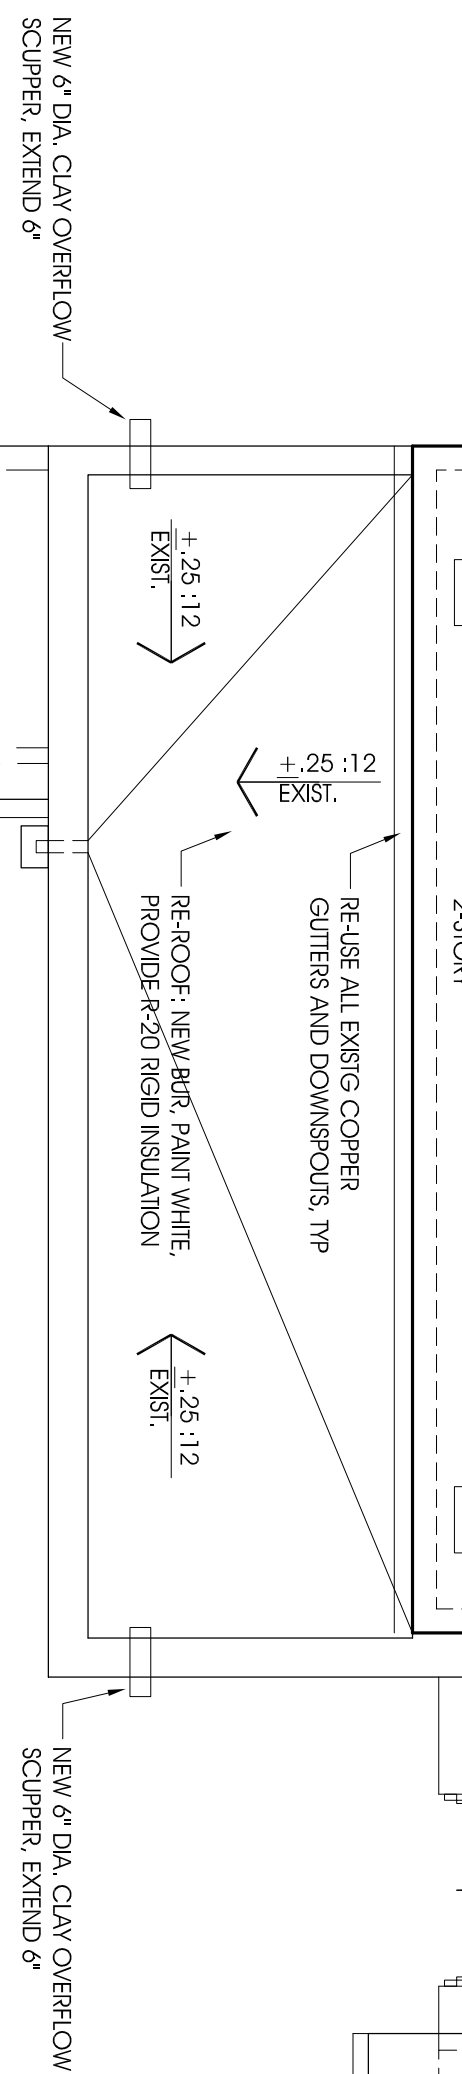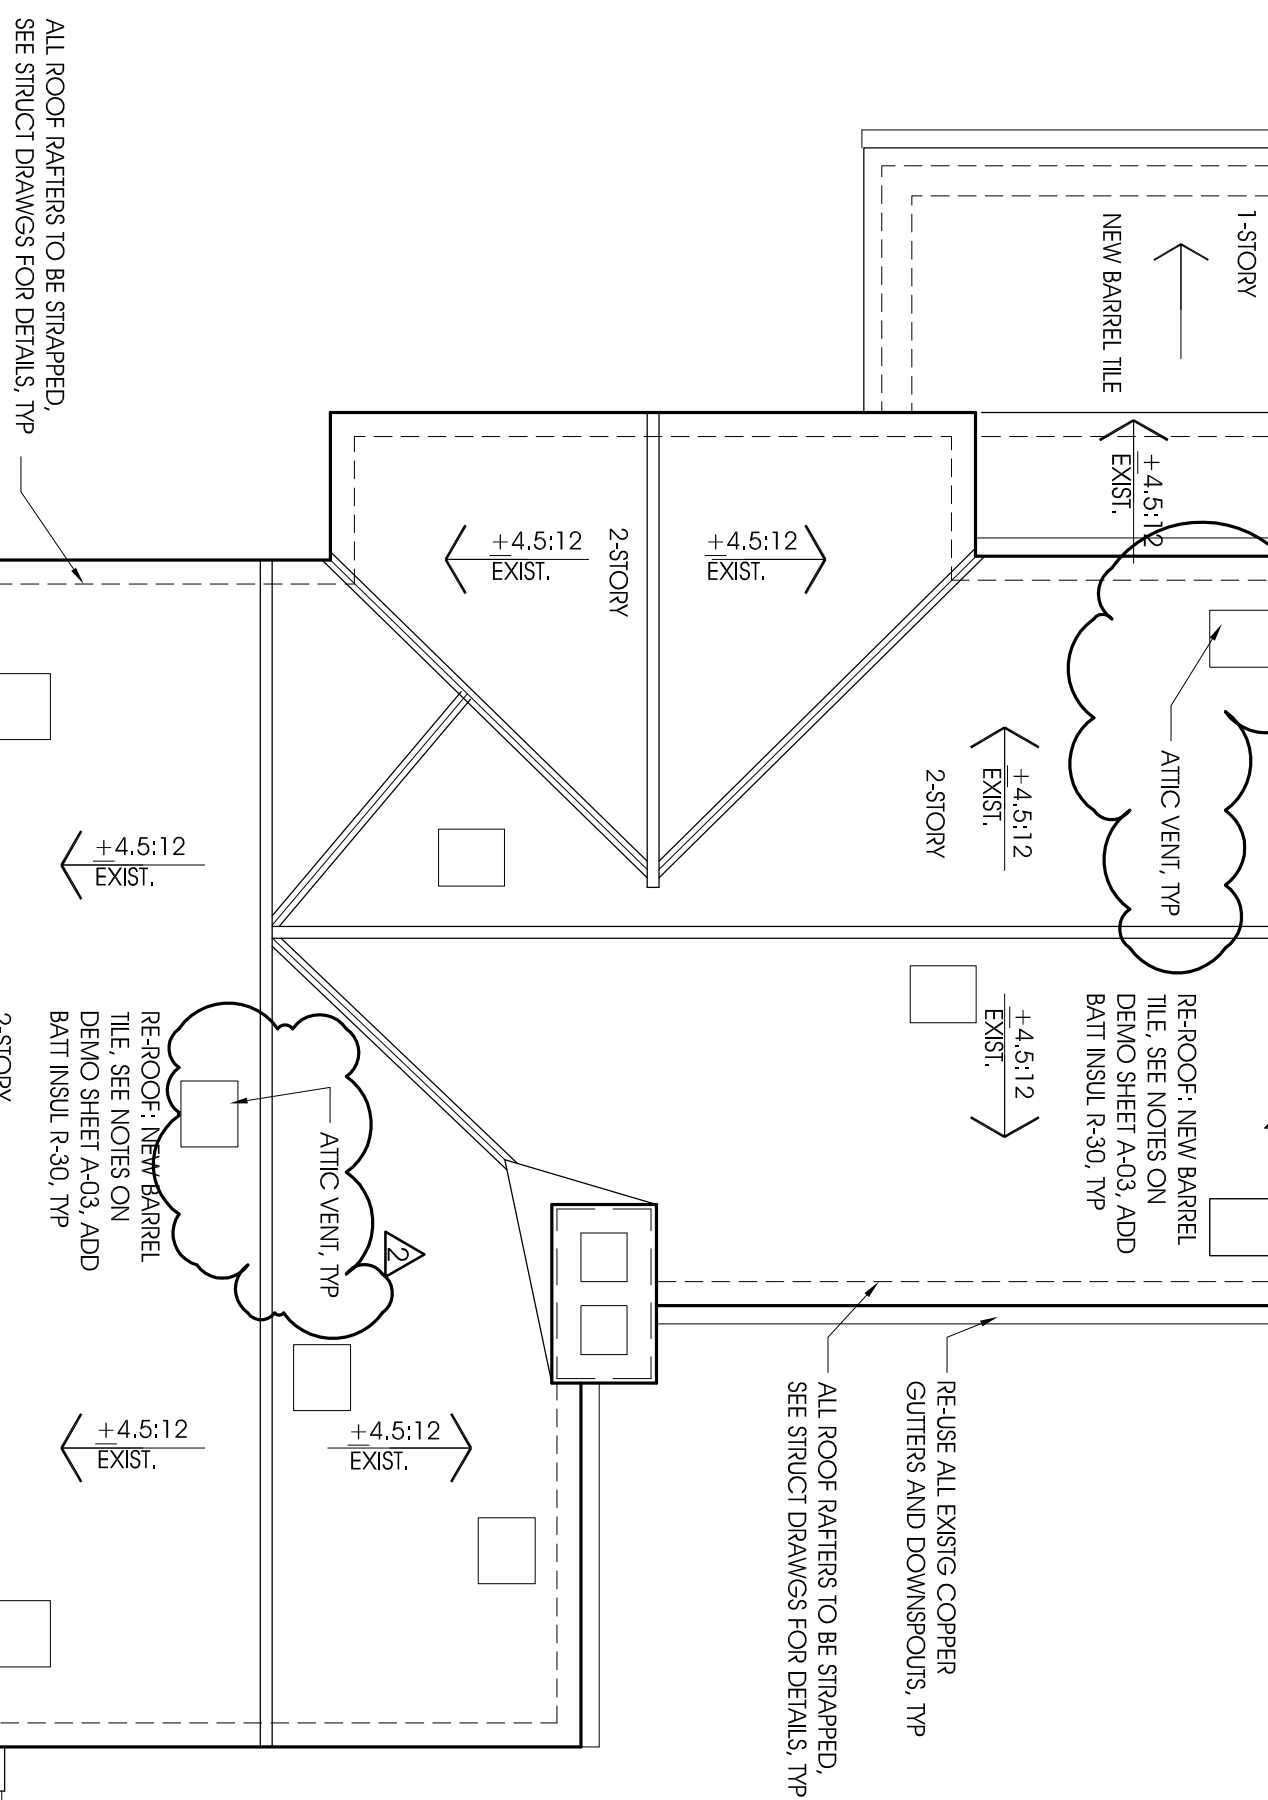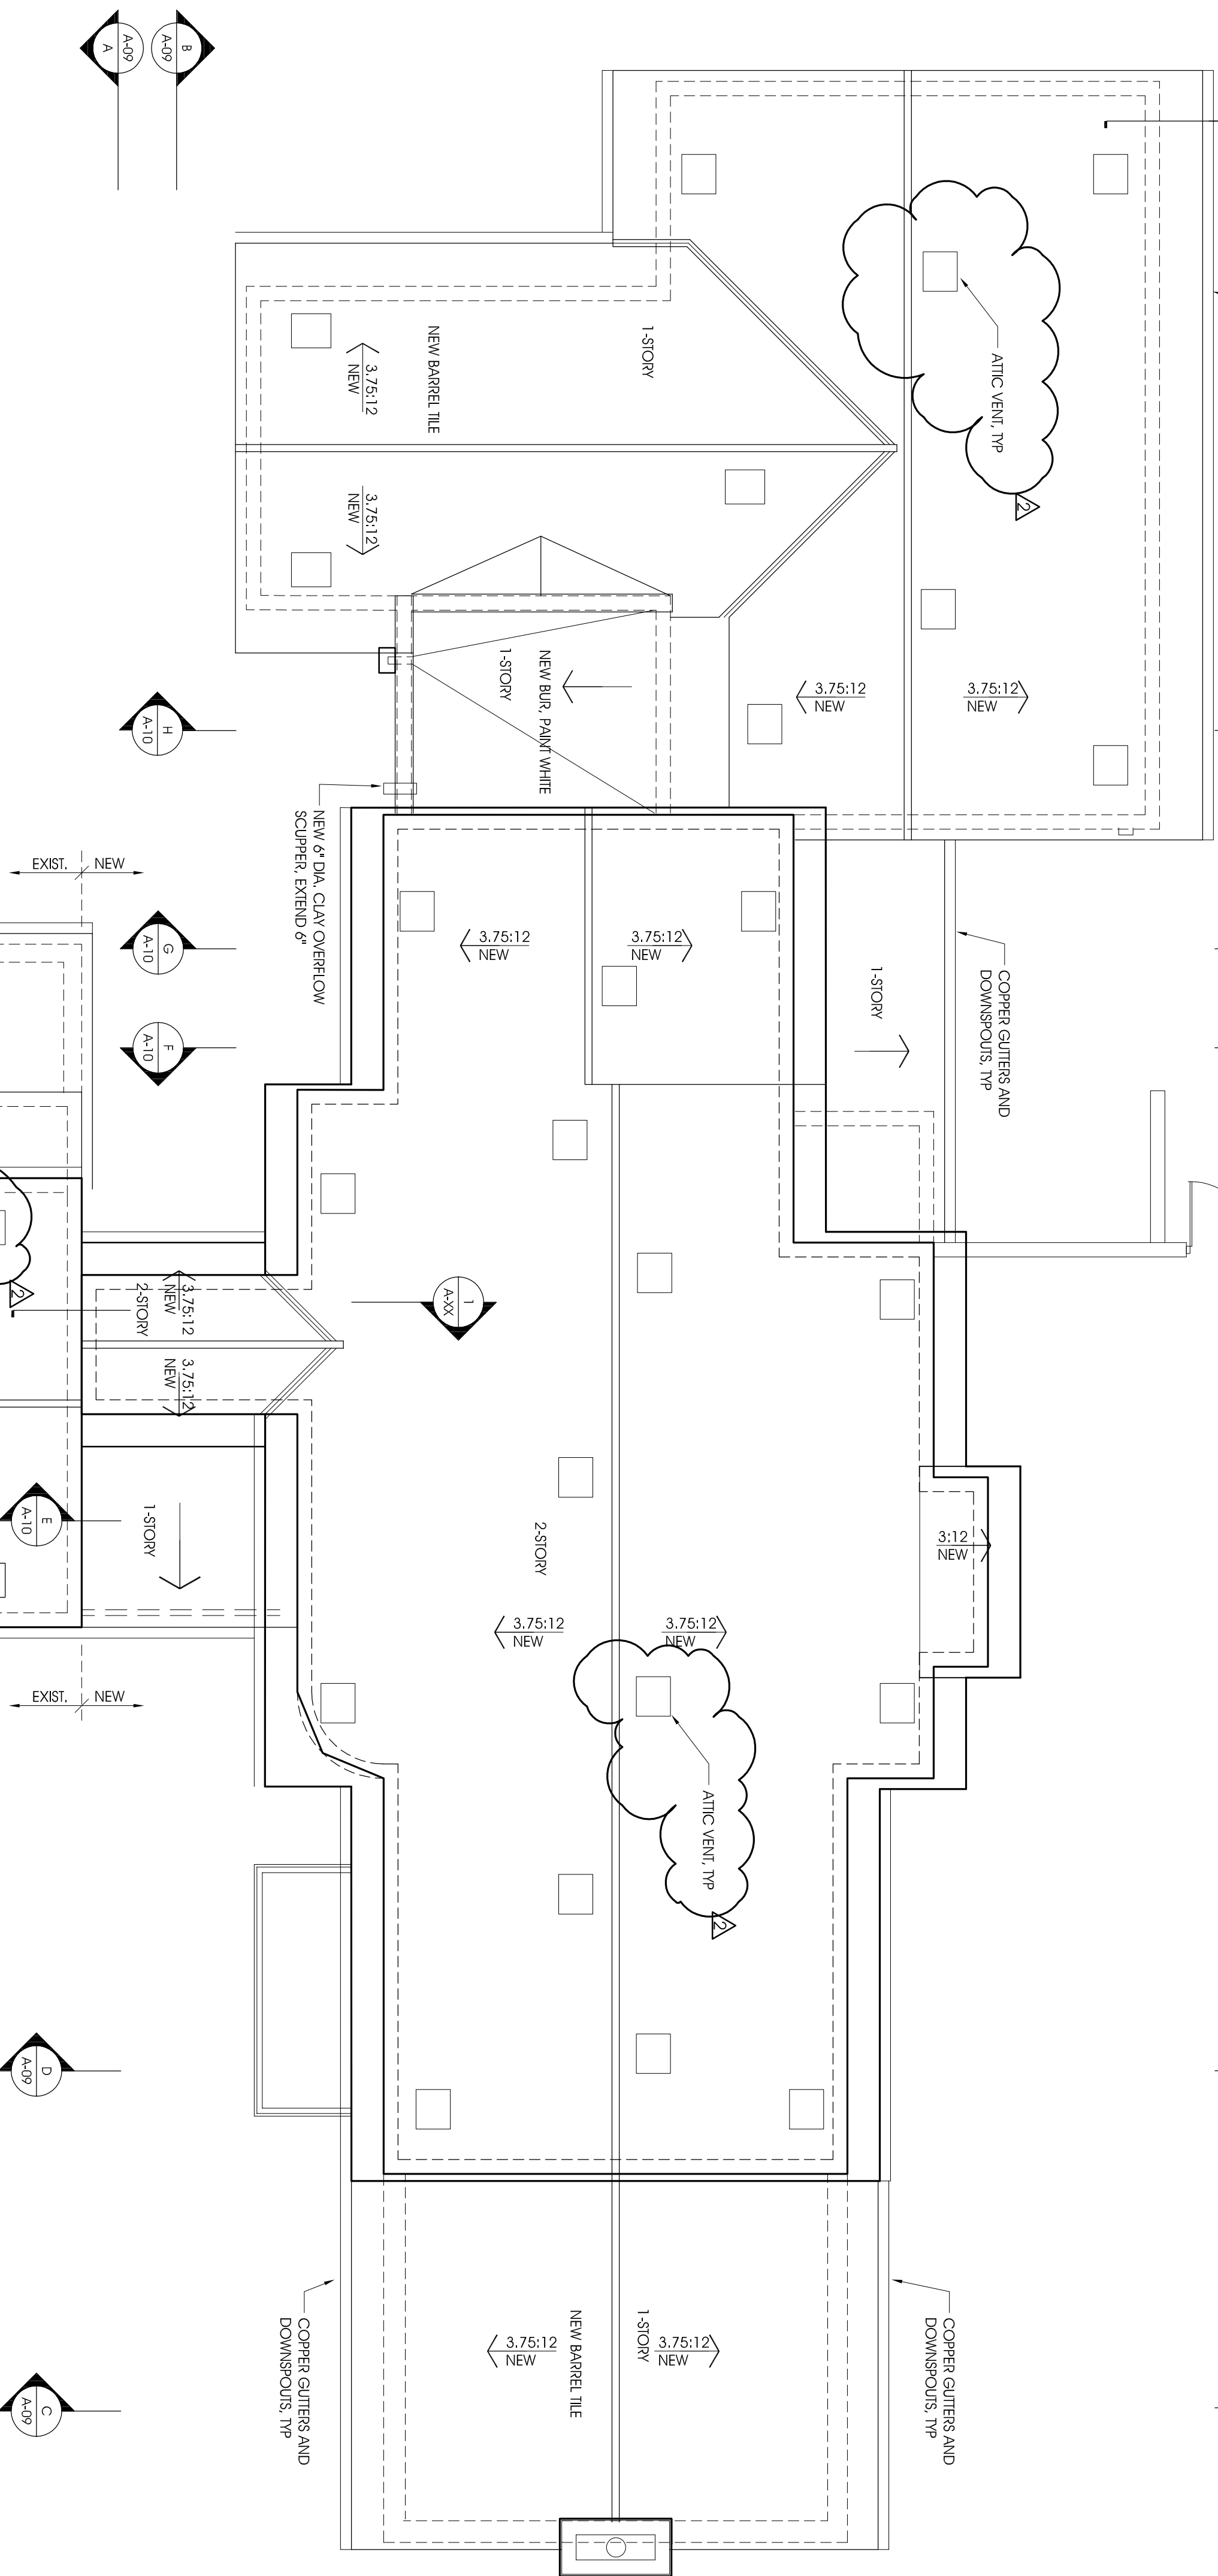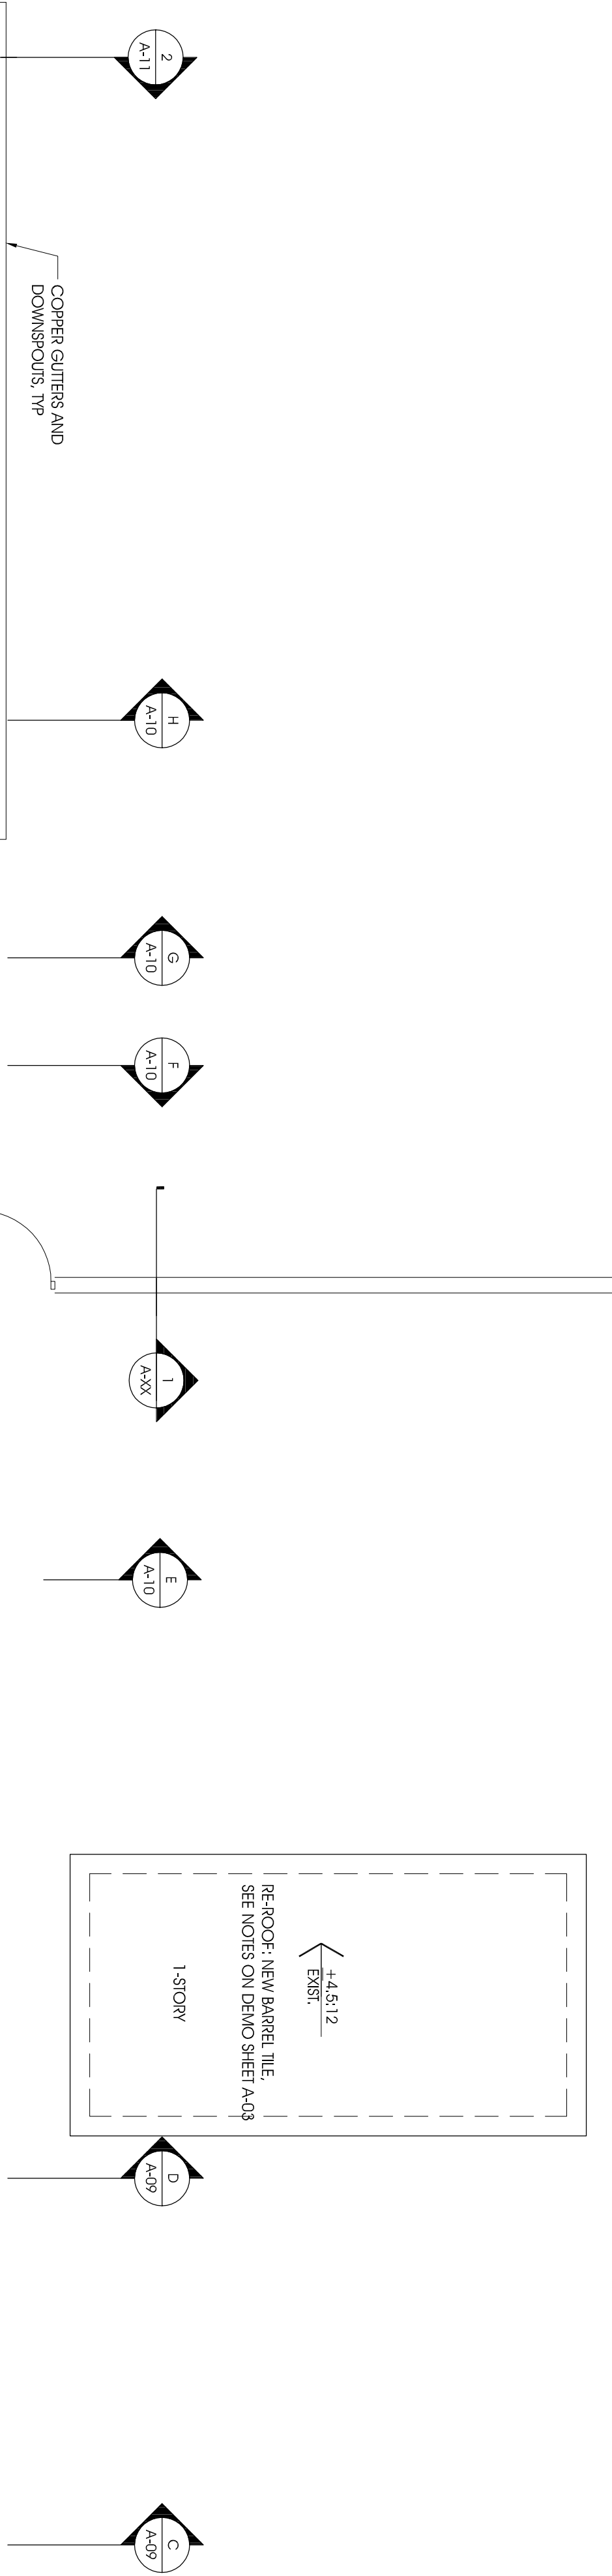



ATTIC VENTILATION : FBC 2007 SECTION 1203

REQUIRED	CALCULATION	PROPOSED
1. EXISTING HOUSE:	1,115 SQ.FT./1.50 = 7.43 SQ.FT. X 1.44 = 1.070 SQ.IN./97.5 = 10.97	EXISTING CLAY VENTS: (12) 6\"/>
2. NEW 1-STORY ADDITION:	1,085 SQ.FT./1.50 = 7.23 SQ.FT. X 1.44 = 1.041 SQ.IN./97.5 = 10.67	PROPOSED CLAY VENTS: (9) 6\"/>
3. NEW 2-STORY ADDITION:	1,414 SQ.FT./1.50 = 10.94 SQ.FT. X 1.44 = 1.575 SQ.IN./97.5 = 16.15	PROPOSED CLAY VENTS: (6) 6\"/>

ROOF PROPOSED PLAN

SCALE: 3/16\"/>

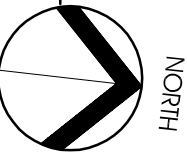

**Locus**
ARCHITECTURE
INCORPORATED

500 South Duke Highway, Suite 307
Fort Lauderdale, FL 33304
Tel: (954) 740-0120
Fax: (954) 740-0773
Email: info@locusarch.com

CONSULTANTS

NO.	REVISION/SUBMISSION	DATE
01	OWNER REVIEW	04/19/2012
02	FINAL DESIGN REVIEW	05/02/2012
03	FINAL DESIGN REVIEW	05/04/2012
04	FINAL DESIGN REVIEW	07/11/2012
05	FINAL DESIGN REVIEW	07/20/2012
06	FINAL DESIGN REVIEW	07/20/2012
07	FINAL DESIGN REVIEW	07/20/2012
08	FINAL DESIGN REVIEW	07/20/2012
09	FINAL DESIGN REVIEW	07/20/2012
10	FINAL DESIGN REVIEW	07/20/2012
11	FINAL DESIGN REVIEW	07/20/2012
12	FINAL DESIGN REVIEW	07/20/2012
13	FINAL DESIGN REVIEW	07/20/2012
14	FINAL DESIGN REVIEW	07/20/2012

Olivera Residence
Remodeling & Additions

2411 San Lorenzo Avenue
Coral Gables, Florida 33134


Roof Proposed Plan

SCALE
3/16\"/>

DESIGNER
Nelson de Leon

PROJECT NO.
A-06

SHEET NO.
166.0

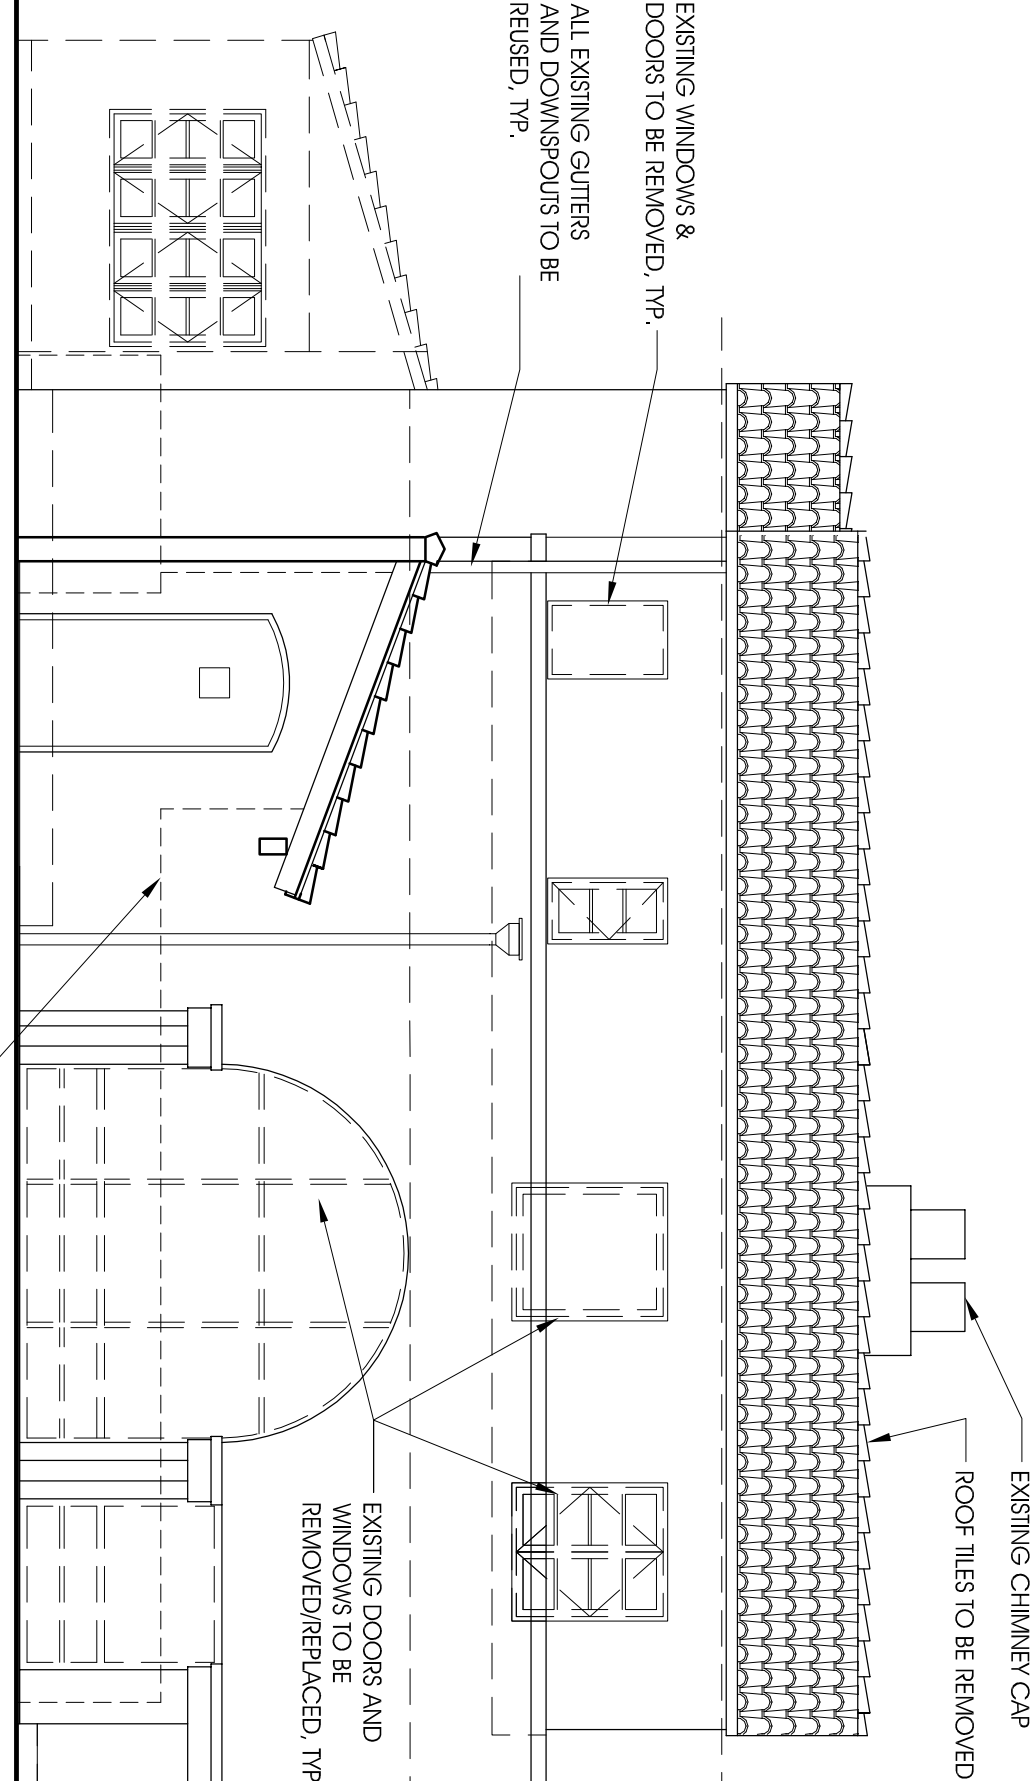

ELEV. ± 18'-7"
TOP OF CONCRETE BEAM (EXIST.)


ELEV. ± 9'-11"
TOP OF SECOND FLOOR

ELEV. ± 1'-0" (12.75' N.G.V.D.)
TOP OF 1ST GRADE

ELEV. ± 0'-0" (13.75' N.G.V.D.)
TOP OF FIN. FLOOR (EXIST.)

SOUTH - EXISTING ELEVATION

SCALE: 3/16" = 1'-0"

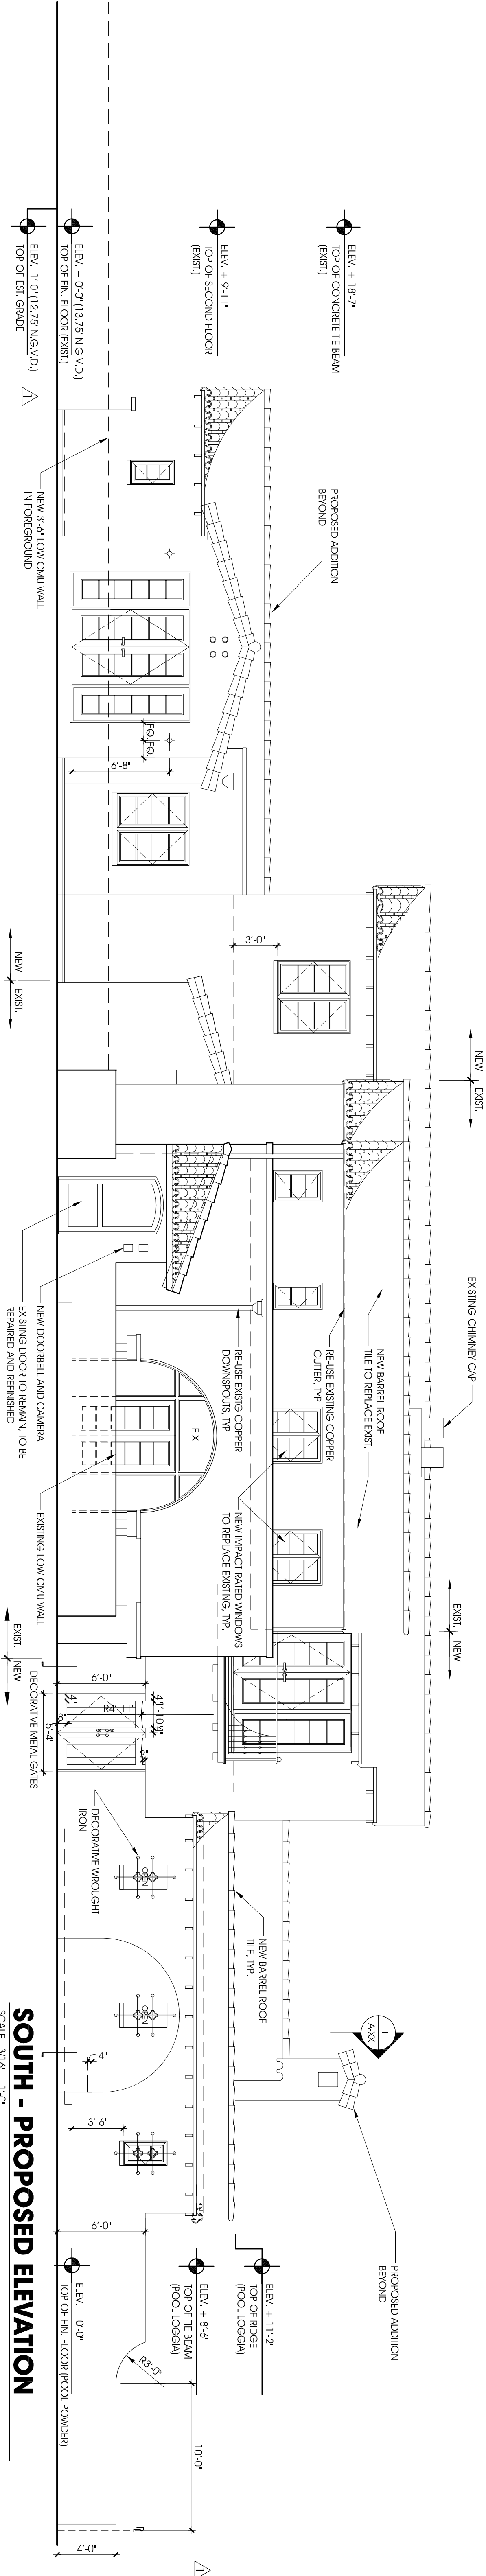

ELEV. ± 18'-7"
TOP OF CONCRETE BEAM (EXIST.)

ELEV. ± 9'-11"
SECOND FLOOR (EXIST.)

ELEV. ± 1'-0" (12.75' N.G.V.D.)
TOP OF 1ST GRADE

ELEV. ± 0'-0" (13.75' N.G.V.D.)
TOP OF FIN. FLOOR (EXIST.)


ELEV. ± 11'-2"
TOP OF ROOF (POOL LOSING)

ELEV. ± 8'-6"
TOP OF THE BEAM (POOL LOSING)

ELEV. ± 0'-0"
TOP OF FIN. FLOOR (POOL ROOMER)


SOUTH - PROPOSED ELEVATION

SCALE: 3/16" = 1'-0"

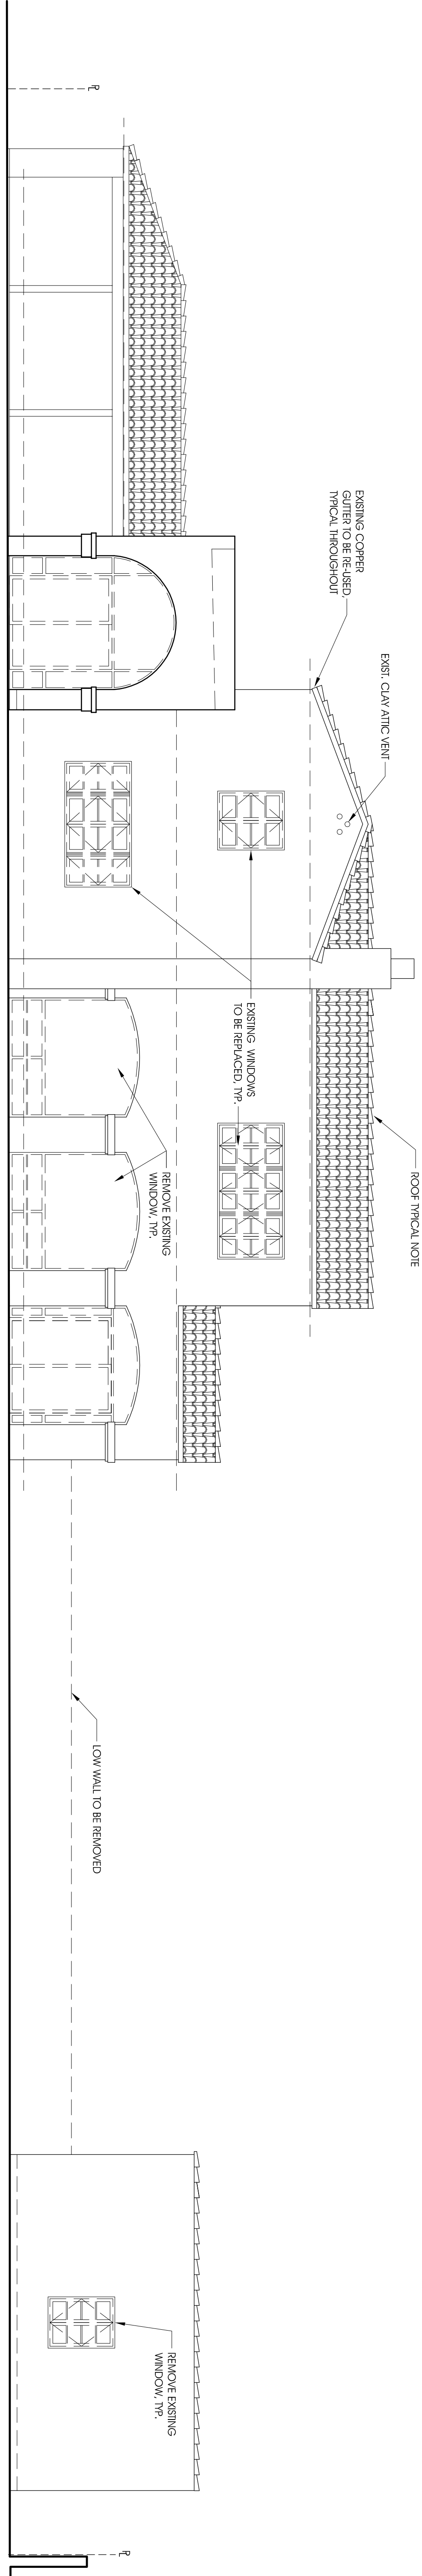


EAST - EXISTING ELEVATION

SCALE: 3/16" = 1'-0"

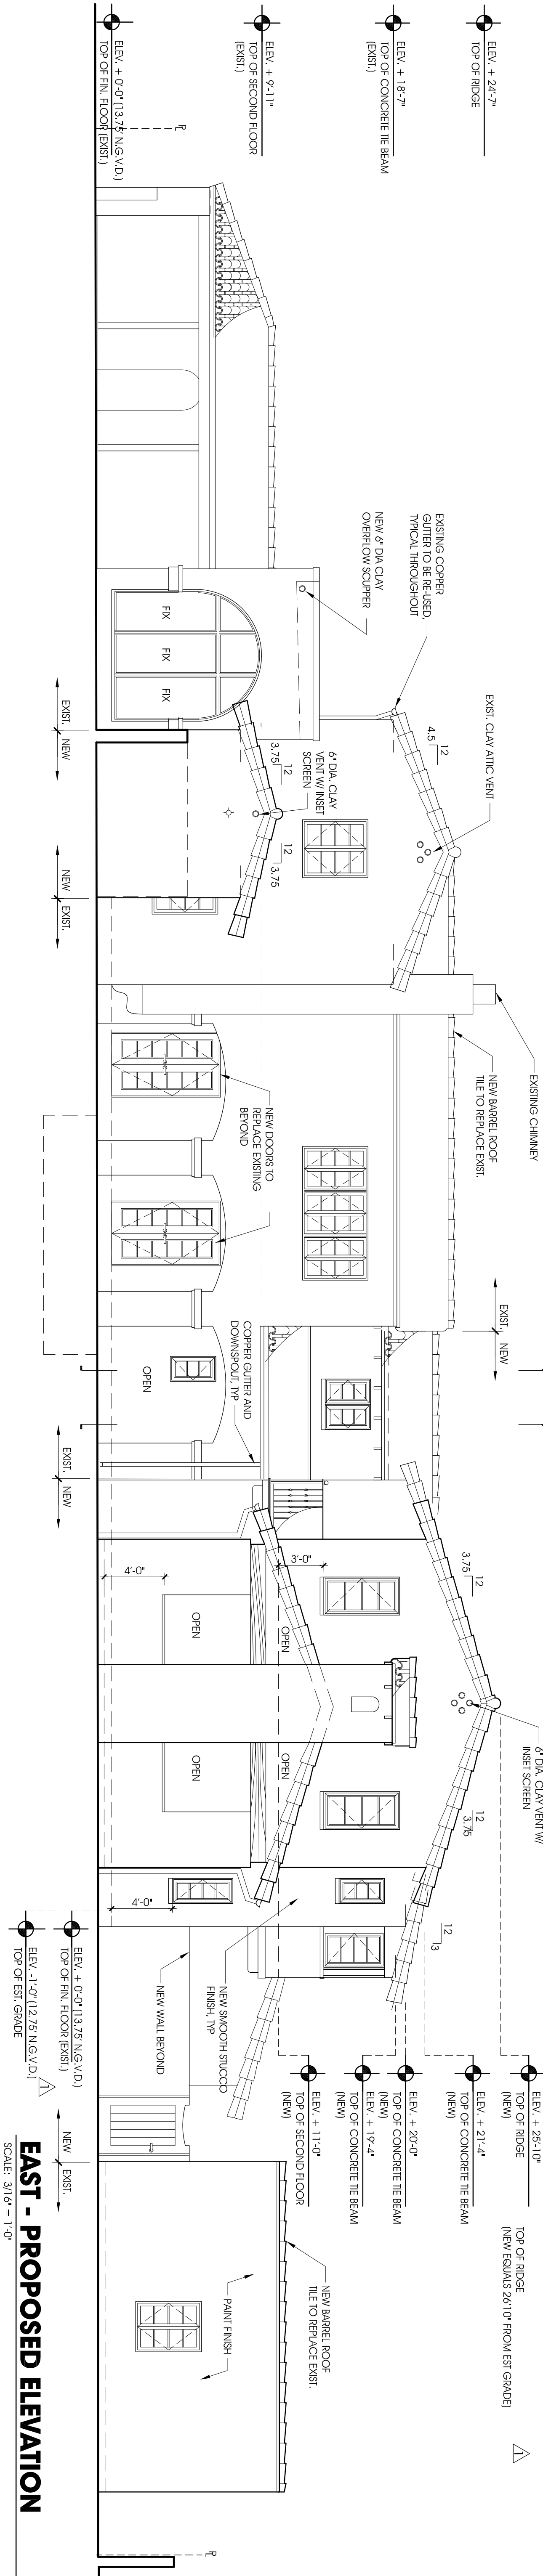

EAST - PROPOSED ELEVATION


SCALE: 3/16" = 1'-0"

<div> LOCUS ARCHITECTURE</div> <div>1400 RIVINGTON Rd. (800) 740-0120 Cedar Rapids, IA 52402 Iowa Reg. No. A4000733</div>		CONSULTANT	
NO.	REVISION/ISSUANCE	DATE	
01	OWNER RE-BID	04/19/2012	
02	REVISIONS	04/02/2012	
03	REVISIONS	05/04/2012	
04	REVISIONS	07/20/2012	
05	REVISIONS	07/20/2012	
06	REVISIONS	06/20/2014	
07	REVISIONS	06/21/2015	
PROJECT			
Onlira Residence Remodeling & Additions			
441 15th Avenue, Annapolis Coral Gables, Florida 33134			
DRAWING			
East and South Exterior View, Facing & Proposed			
SCALE	DATE	DRAWN	REVIEWED
1/8" = 1'-0"	1/4/17	TJA NEL	NEL
PROJECT NO.	PROJECT NO.	PROJECT NO.	PROJECT NO.
164.0	164.0	164.0	164.0
SHEET NO.	SHEET NO.	SHEET NO.	SHEET NO.
A-07	A-07	A-07	A-07



NORTH - EXISTING ELEVATION

SCALE: 3/16" = 1'-0"

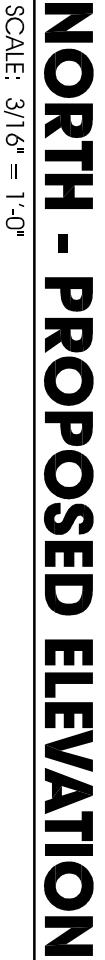

NORTH - PROPOSED ELEVATION

SCALE: 3/16" = 1'-0"




WEST - EXISTING ELEVATION


SCALE: 3/16" = 1'-0"

CONSULTANT(S)


SHEET NO.

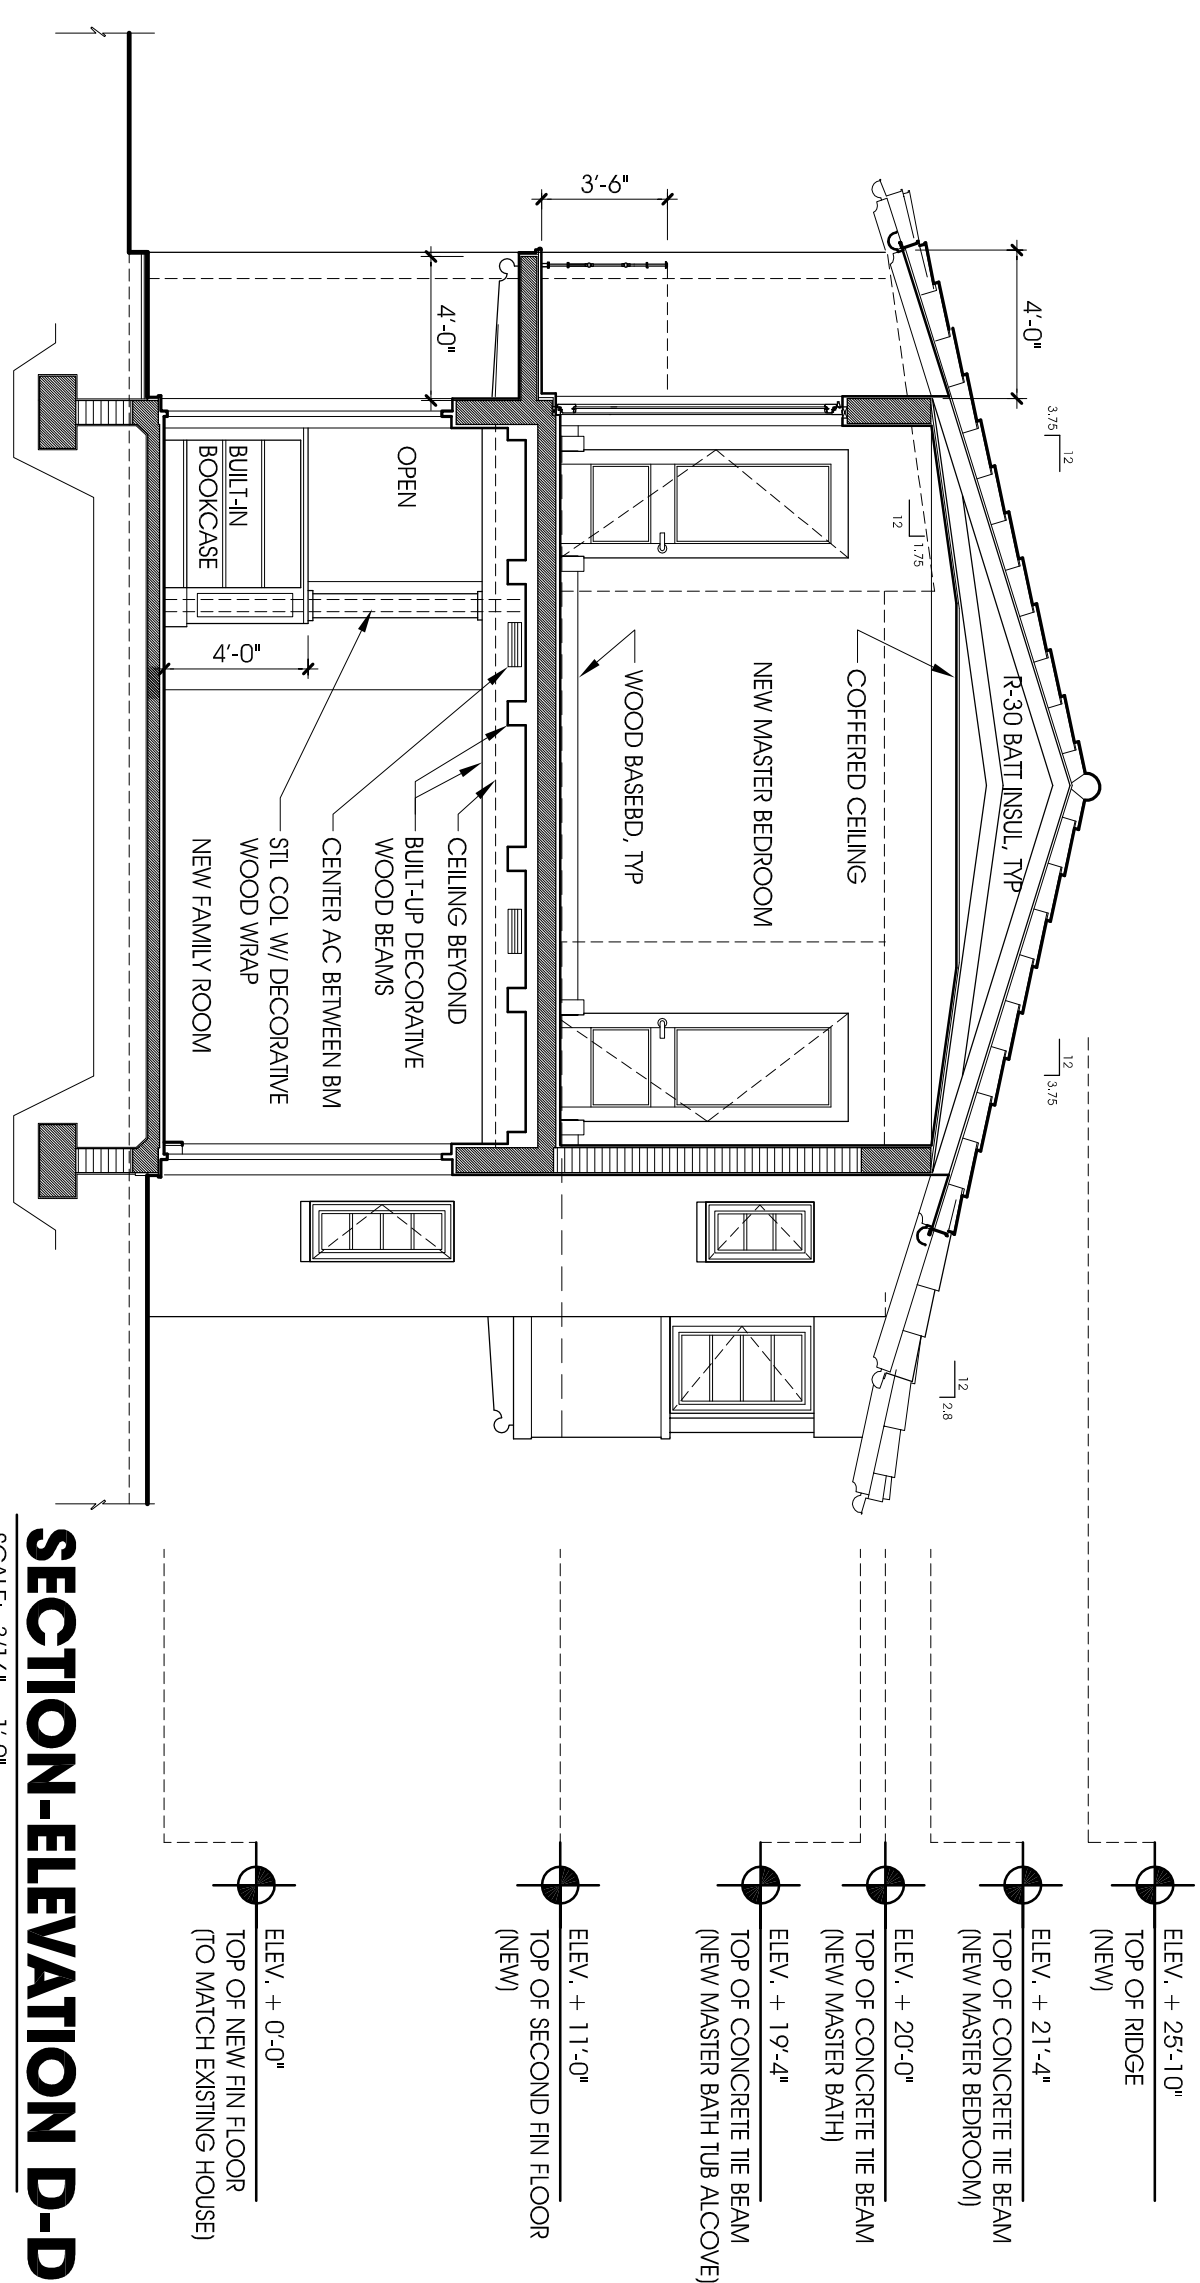


SECTION-ELEVATION D-D
SCALE: 3/16" = 1'-0"

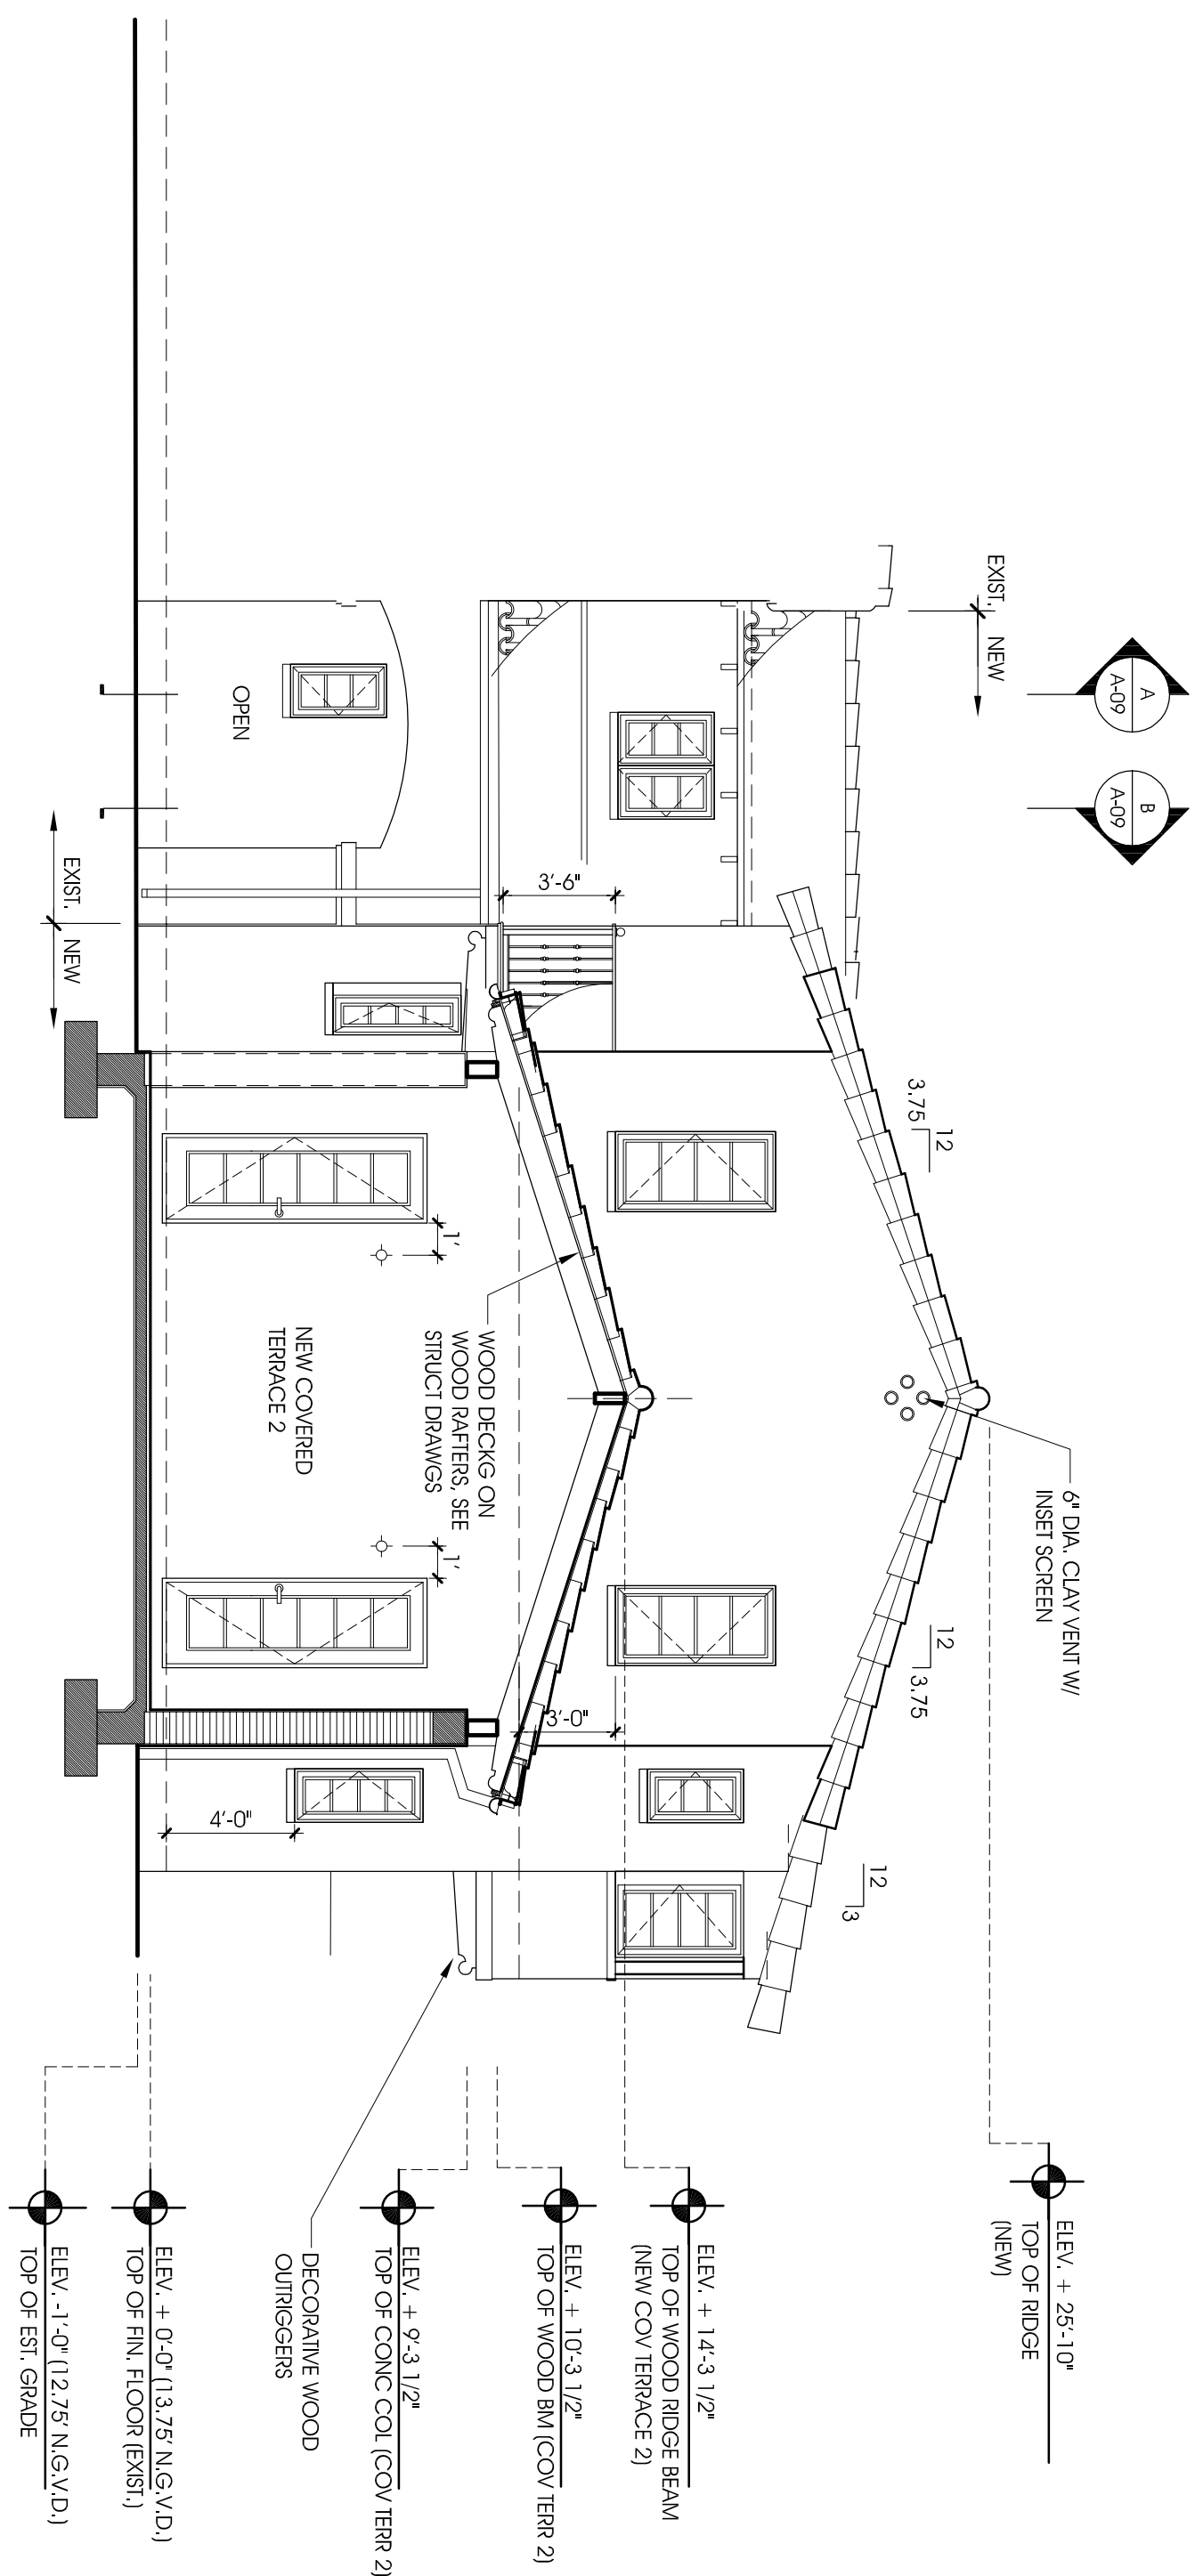

SECTION-ELEVATION C-C

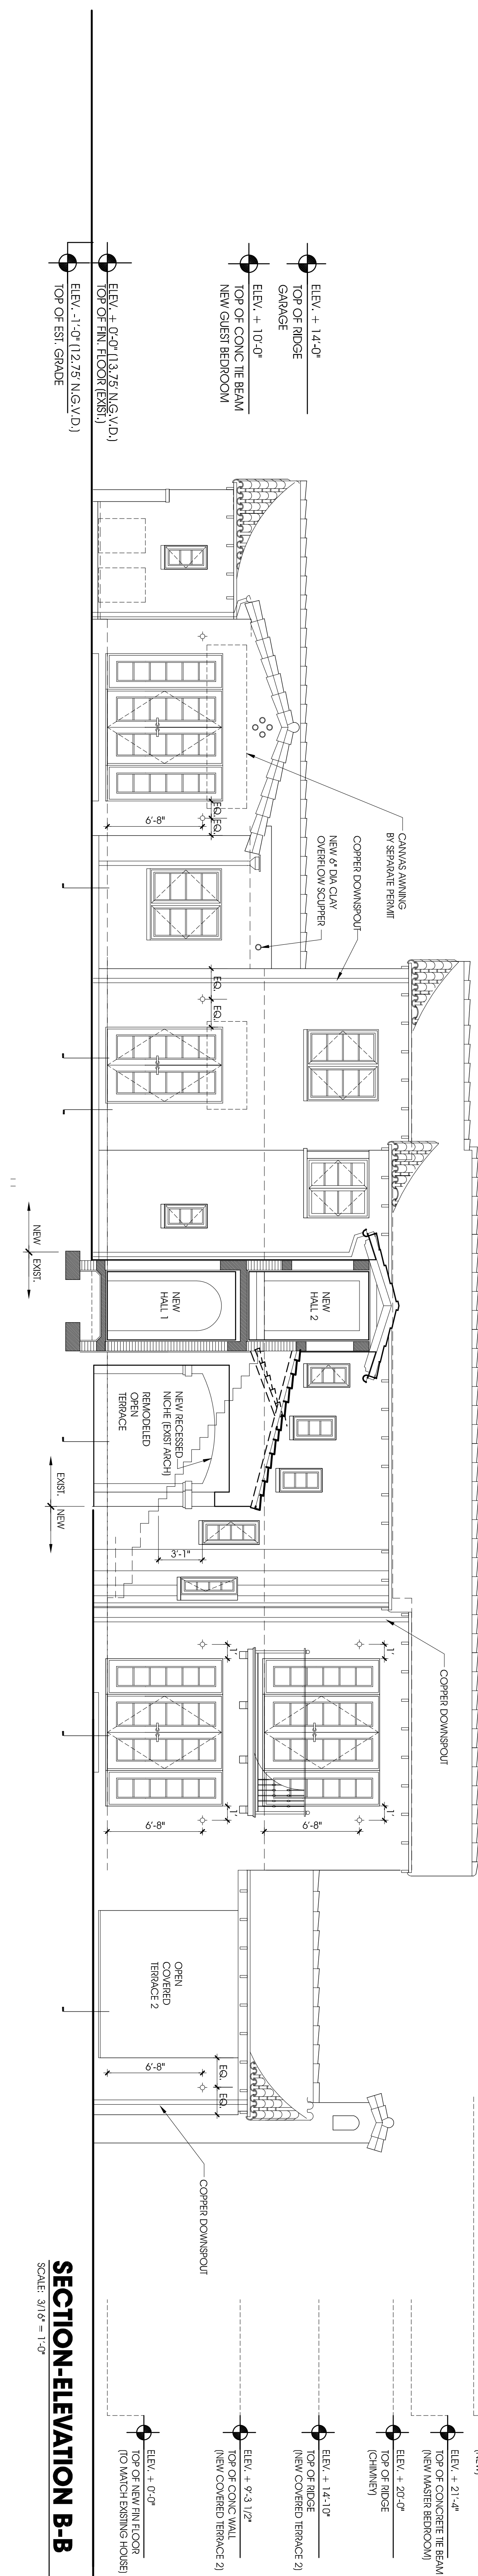


SECTION-ELEVATION B-B

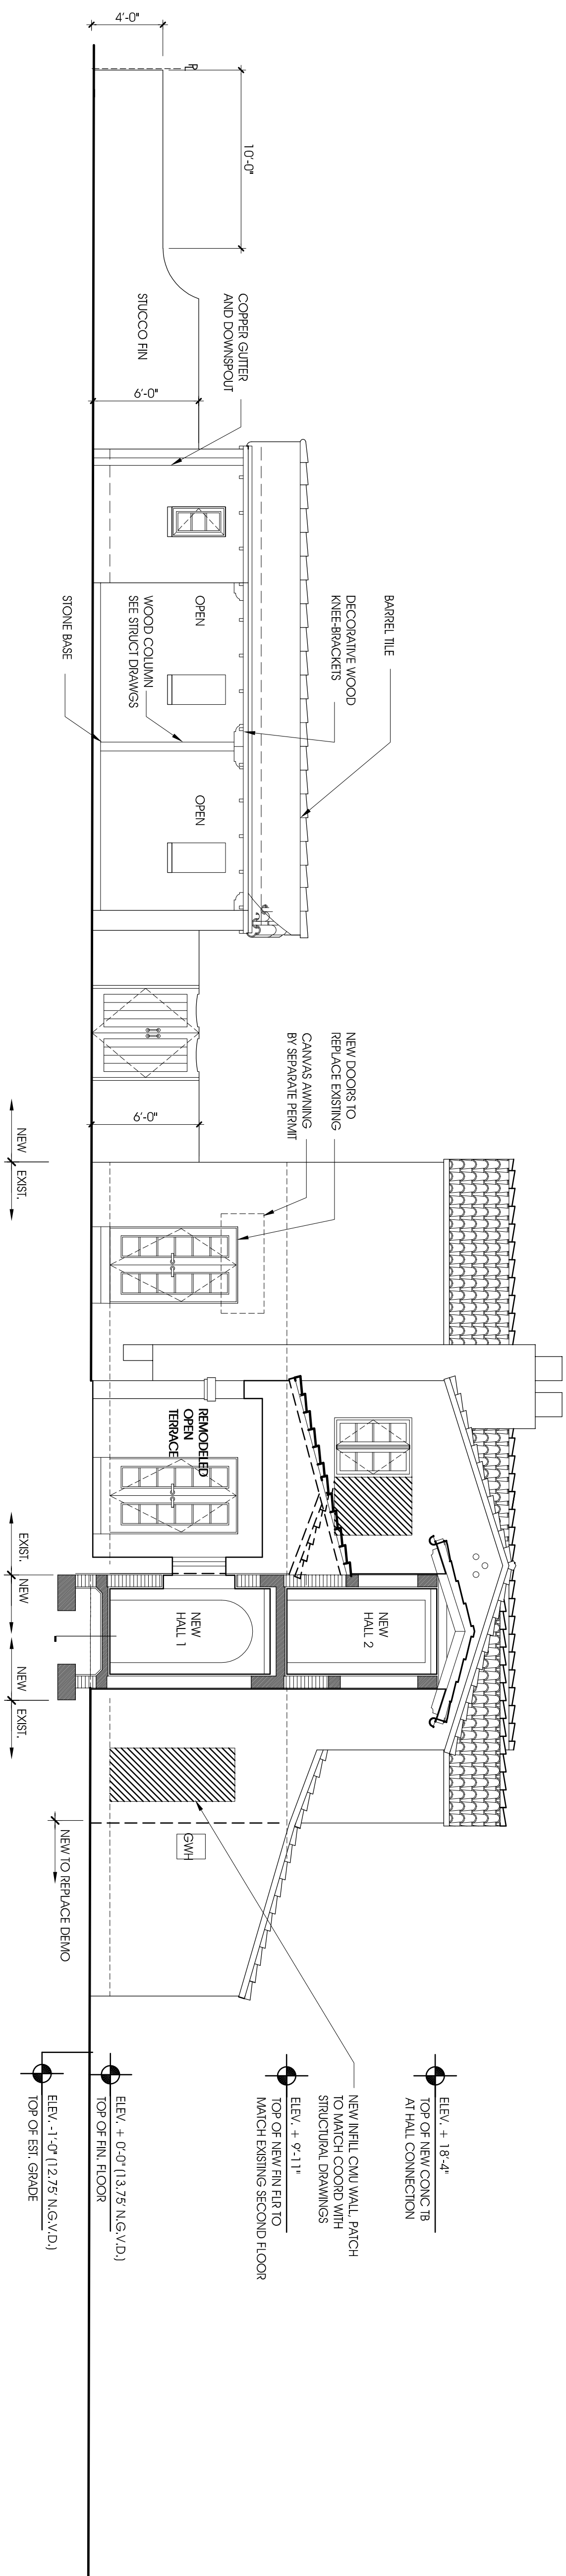


SECTION-ELEVATION A-A

[illegible]

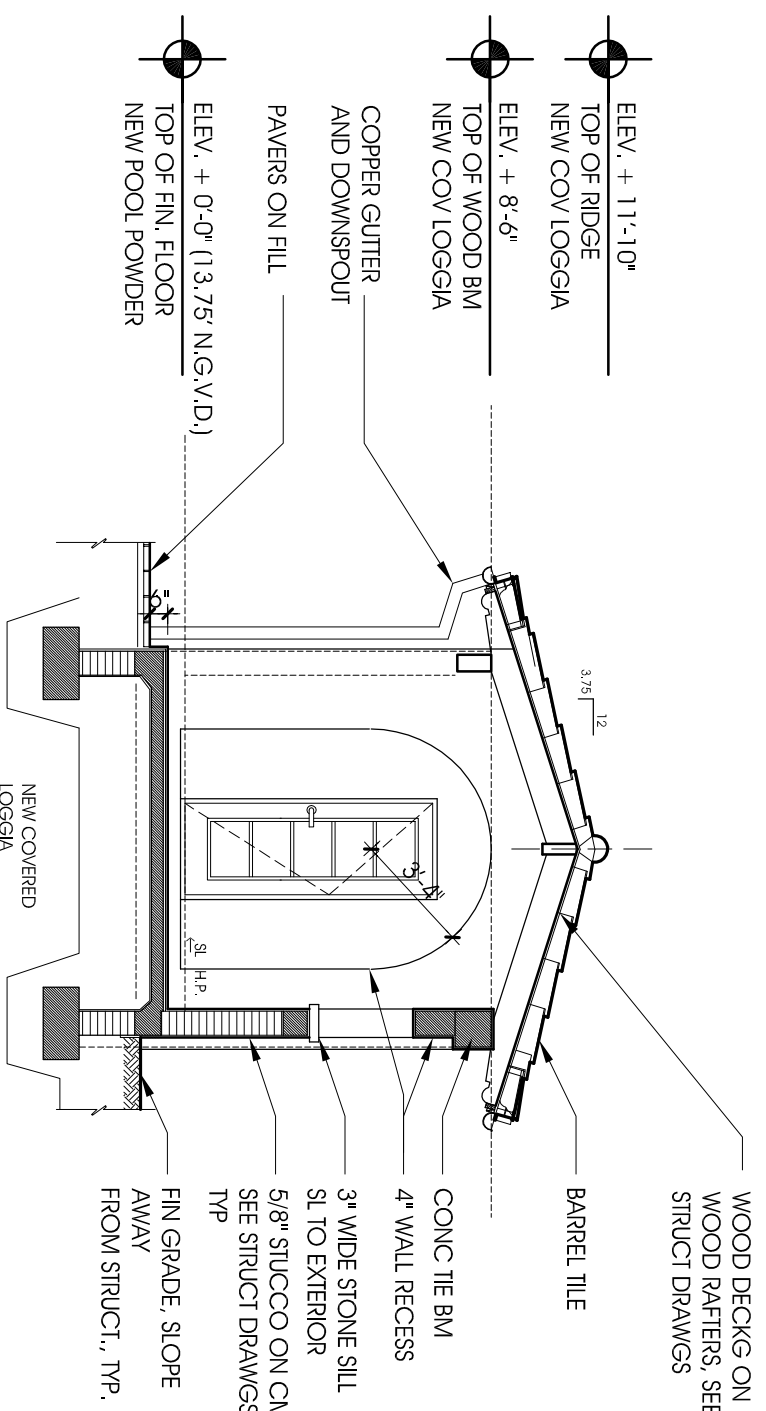


SECTION-ELEVATION I-I

SCALE: 3/16" = 1'-0"

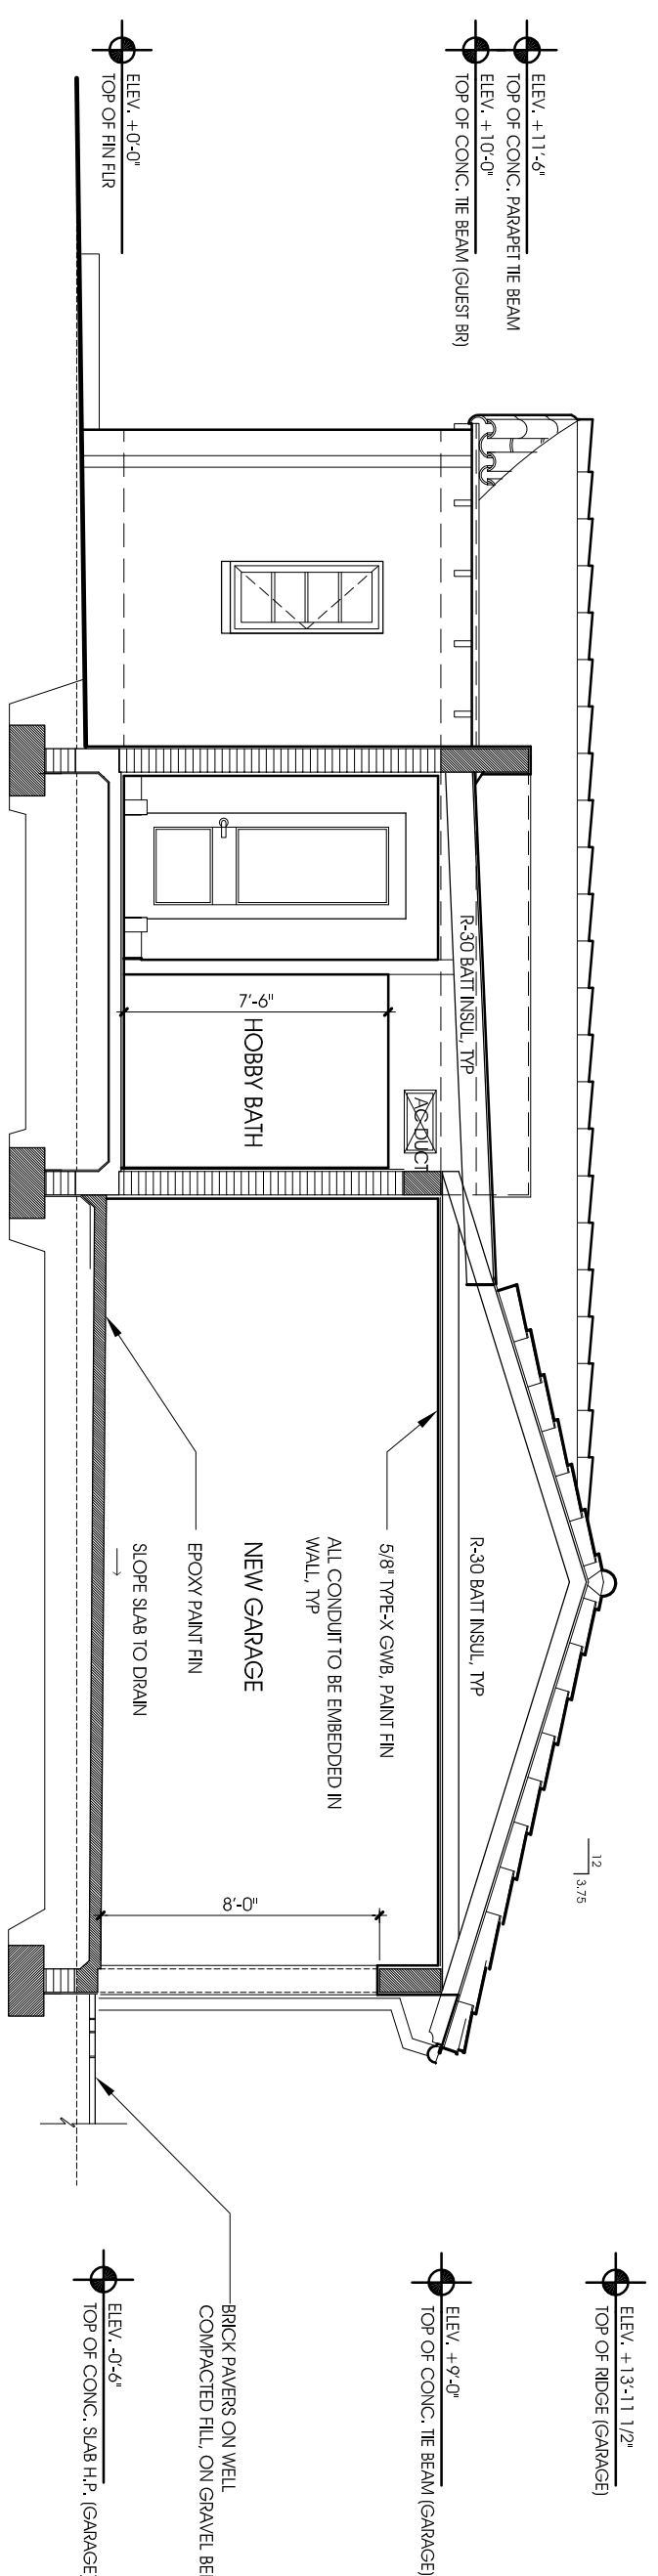


SECTION-ELEVATION H-H

SCALE: 3/16" = 1'-0"

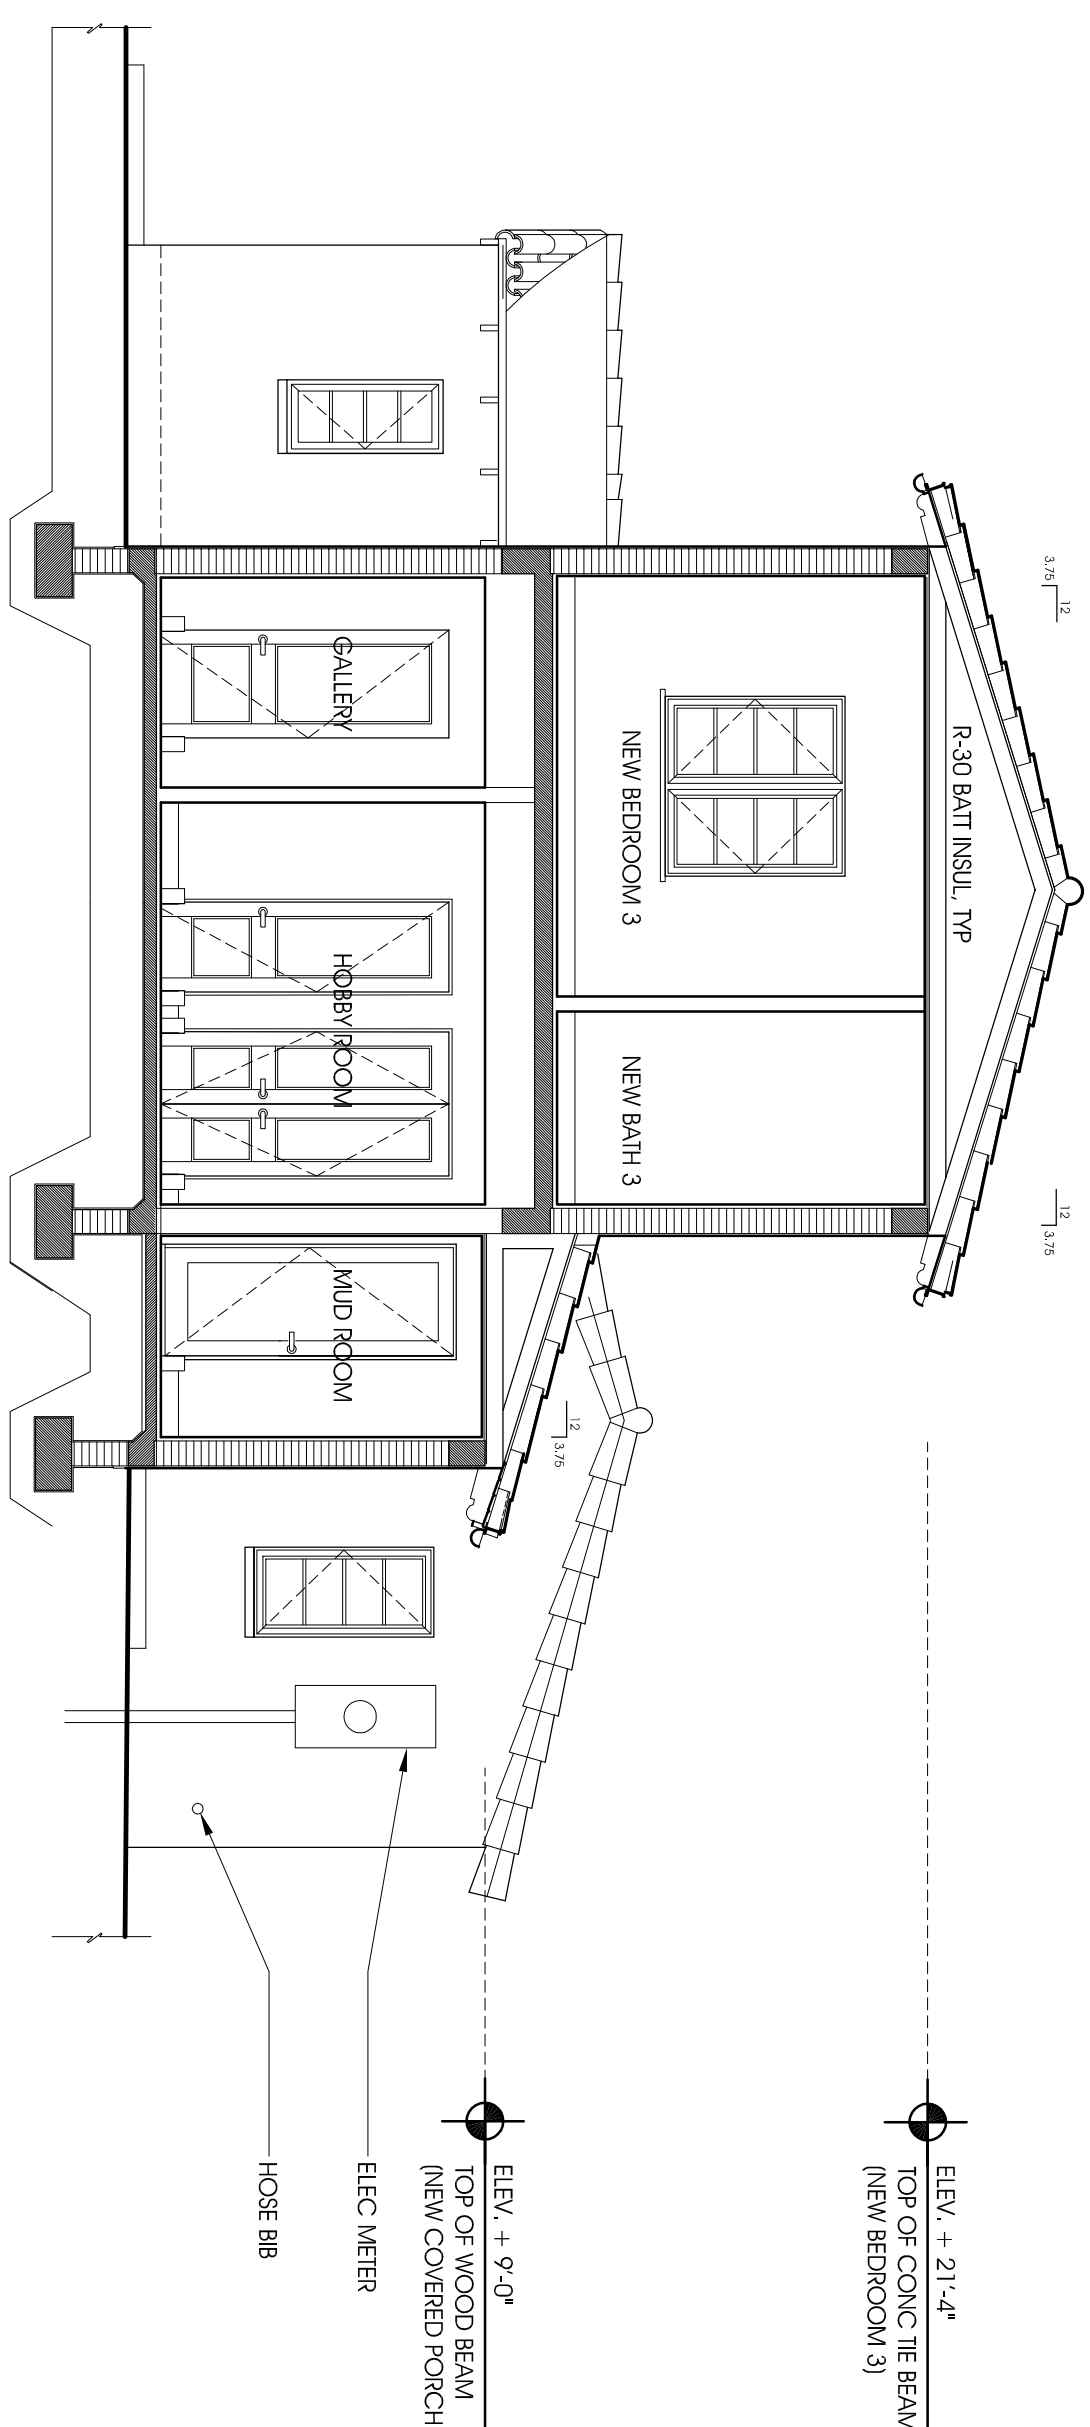


SECTION-ELEVATION G-G

SCALE: 3/16" = 1'-0"

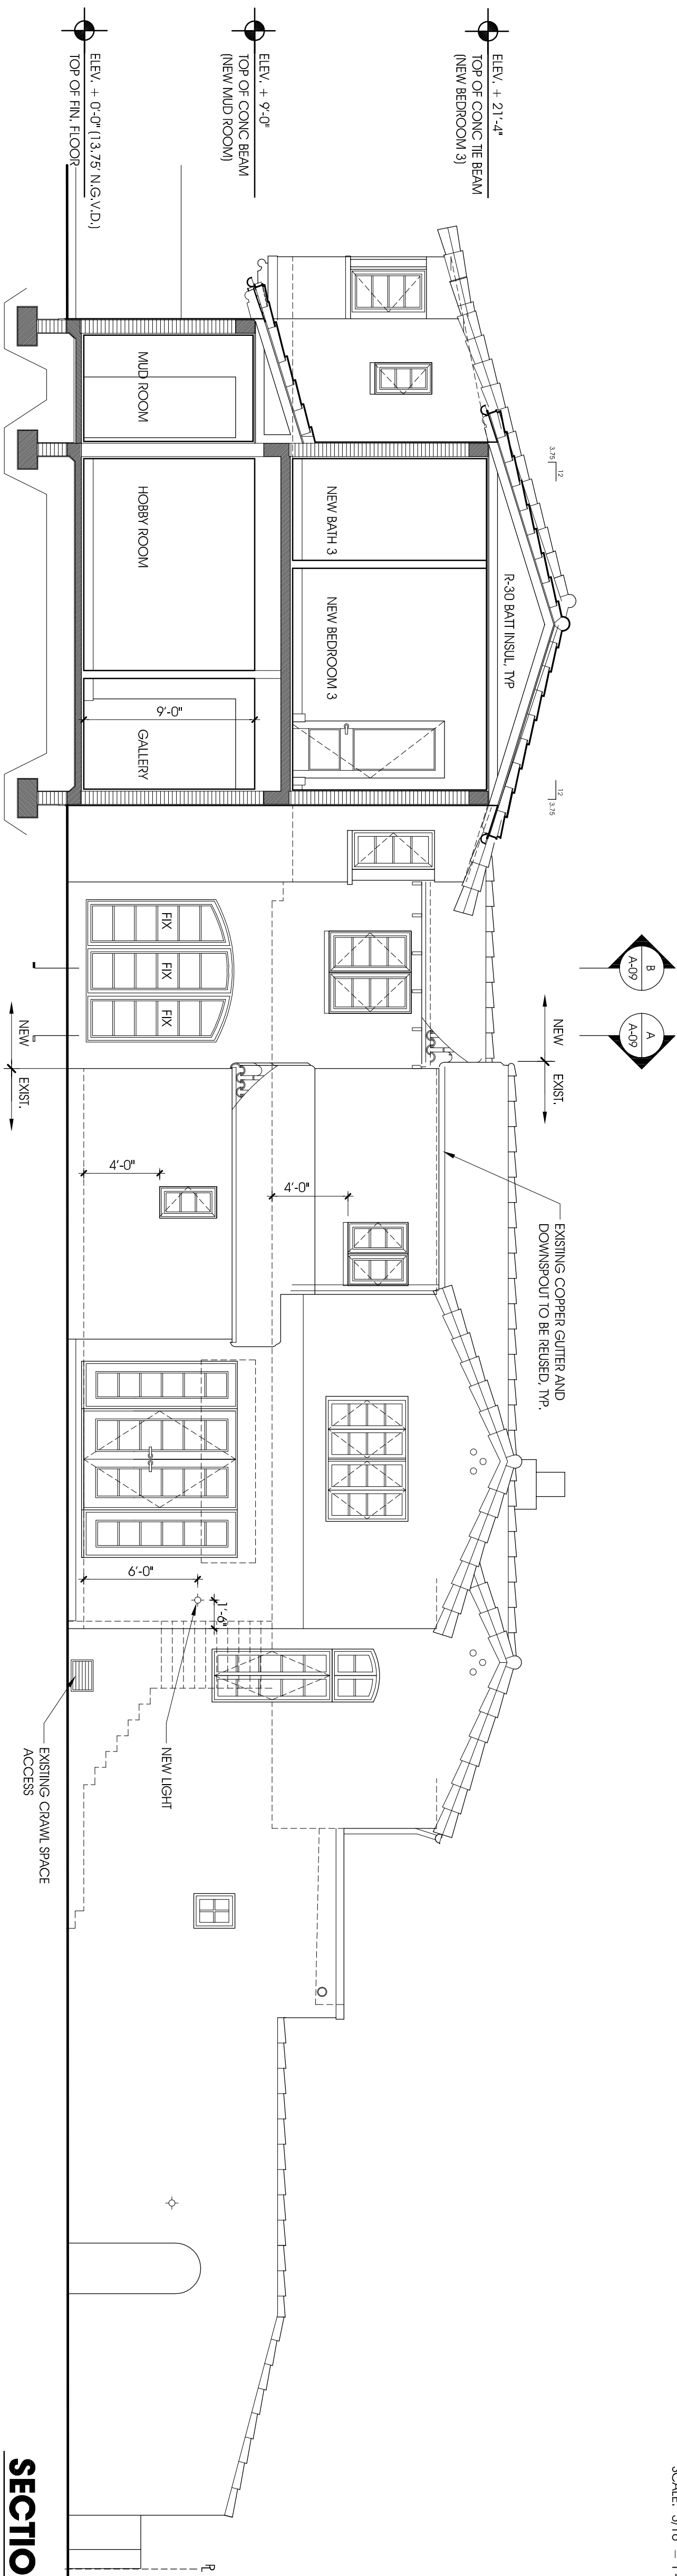


SECTION-ELEVATION F-F

SCALE: 3/16" = 1'-0"

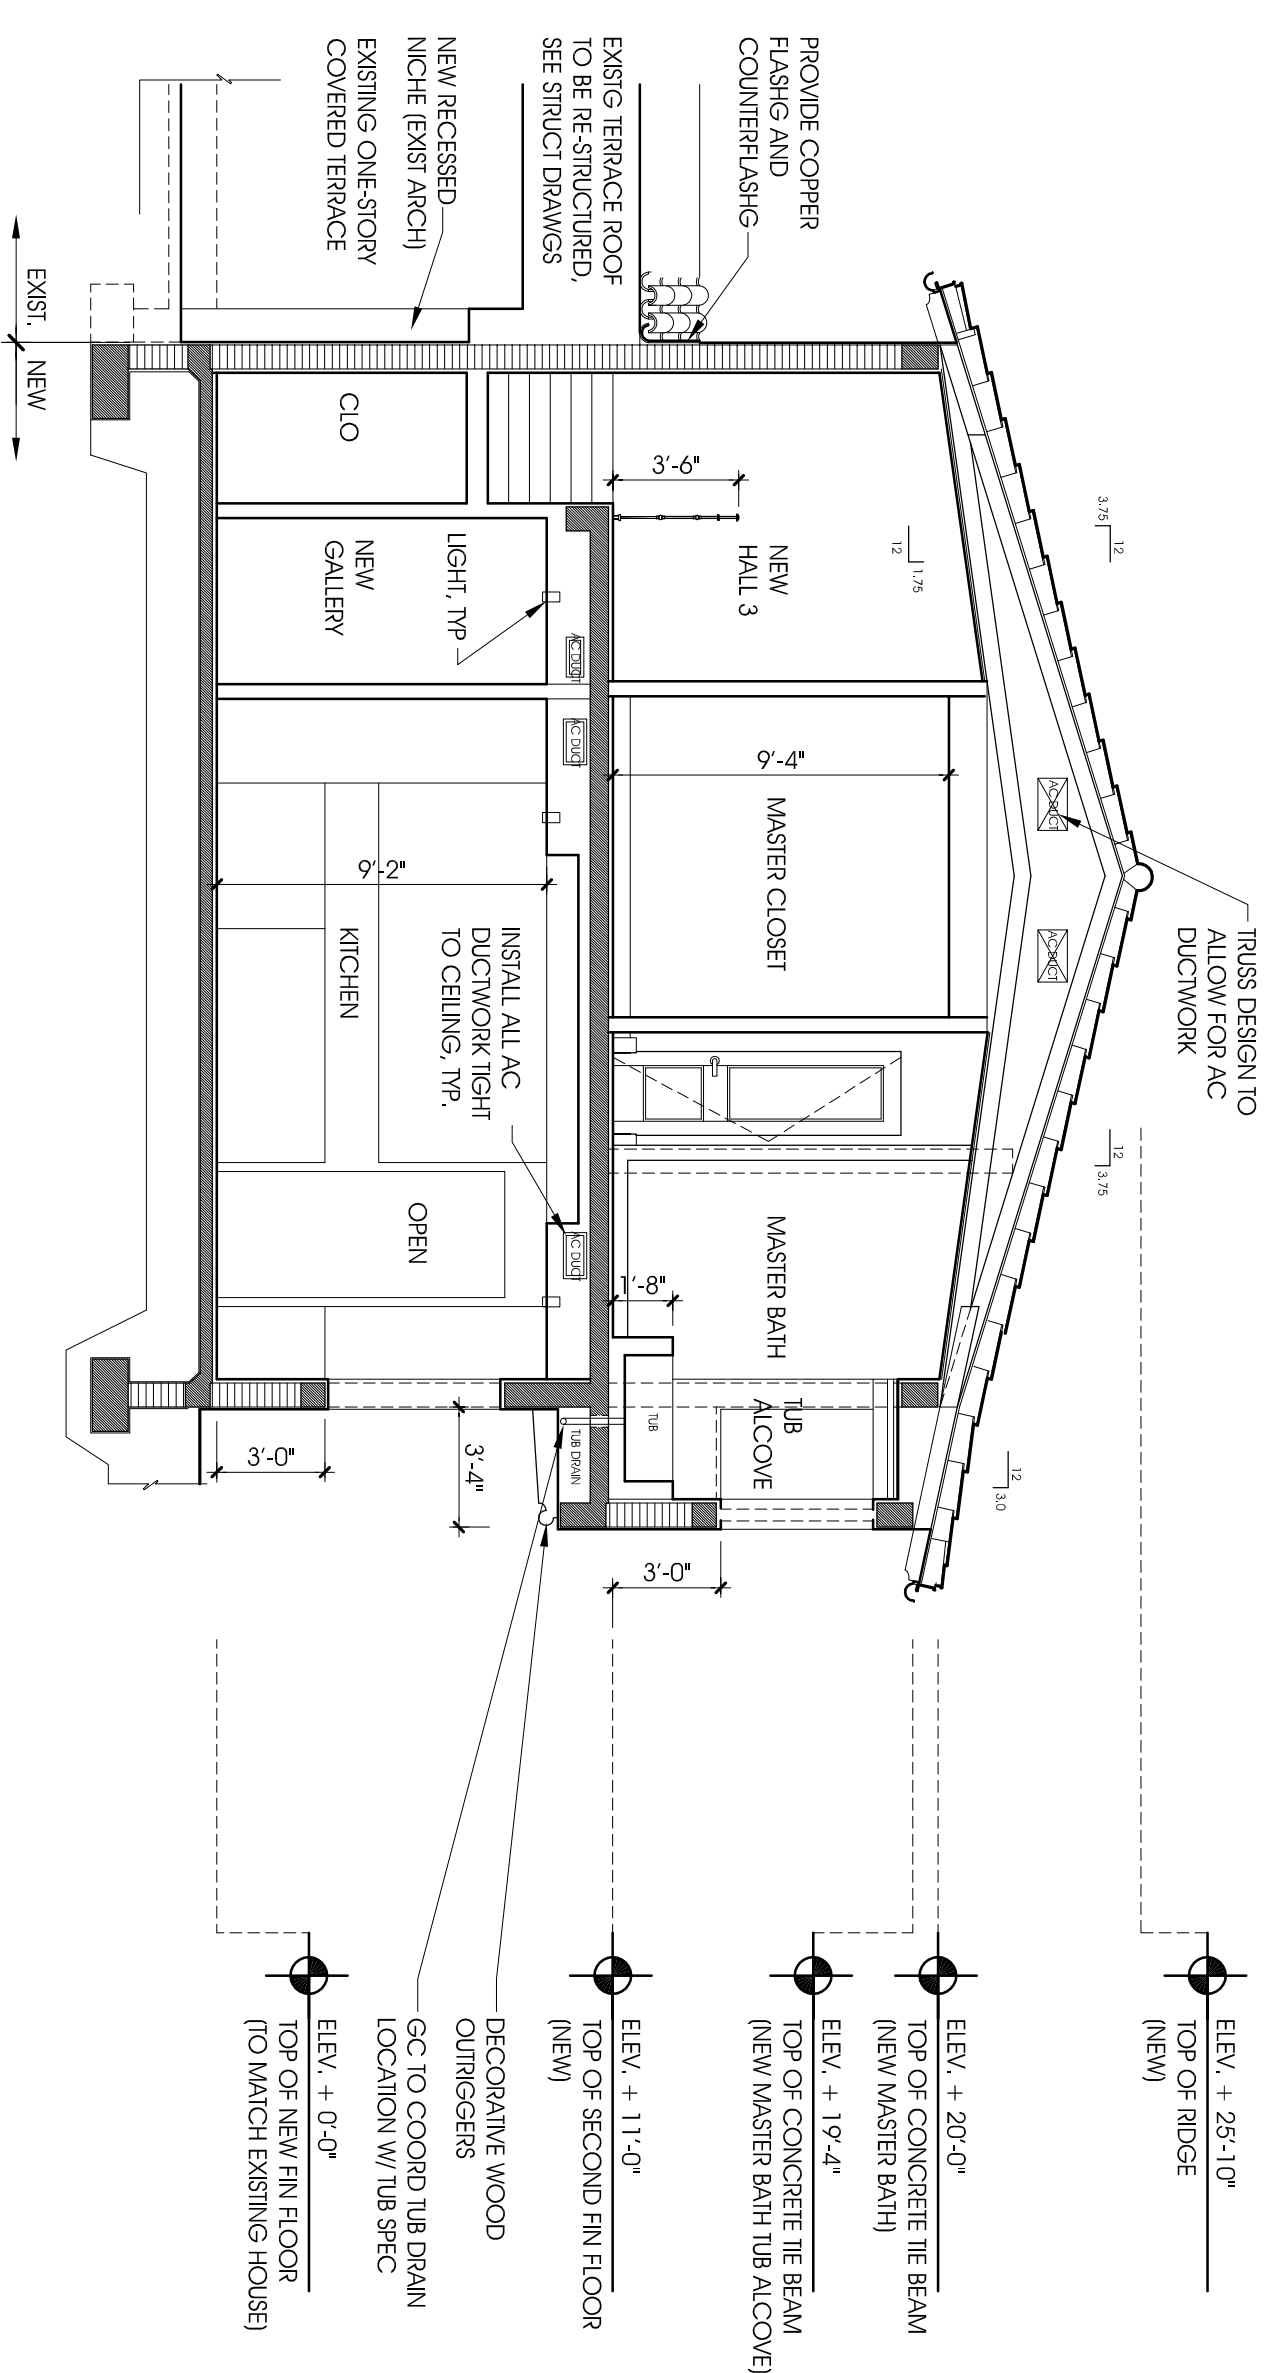

SECTION-ELEVATION F-F

SCALE: 3/16" = 1'-0"

 **LOCUS**
ARCHITECTURE
INCORPORATED



500 South Dale Highway, Suite 307
Coral Gables, FL 33146
Tel (305) 742-0120
Fax (305) 742-0520
License No. AA0002733

CONSULTANTS

NO.	REVISION/SUBMISSION	DATE
	OWNER REVIEW	04/01/2021
	PLACED WORKSHEET	05/07/2021
	THE POSITION APPRAIS	05/24/2021
	COMMITTEE APPLICATION	07/12/2021
	B.O.A. PRELIMINARY STATEMENT	07/20/2021
	HISTORICAL RESOURCES STATEMENT	09/20/2021
	FINAL STATEMENT	
	PREPARE MEMORANDUMS	05/01/2021
	NO. 5-1575	06/02/2021

PROJECT		Olivera Residence Remodeling & Additions 6411 Sevi Lorraine Avenue Coral Gables, Florida 33134	
DRAWING		SECTION-ELEVATIONS: E	
SCALE		DRAWING 1/8" = 1'-0" REVIEW NEL PROJ. 1/6/01	NELSON DE LUEN ARCHITECT 19357

SCALE: 3/16" = 1'-0"

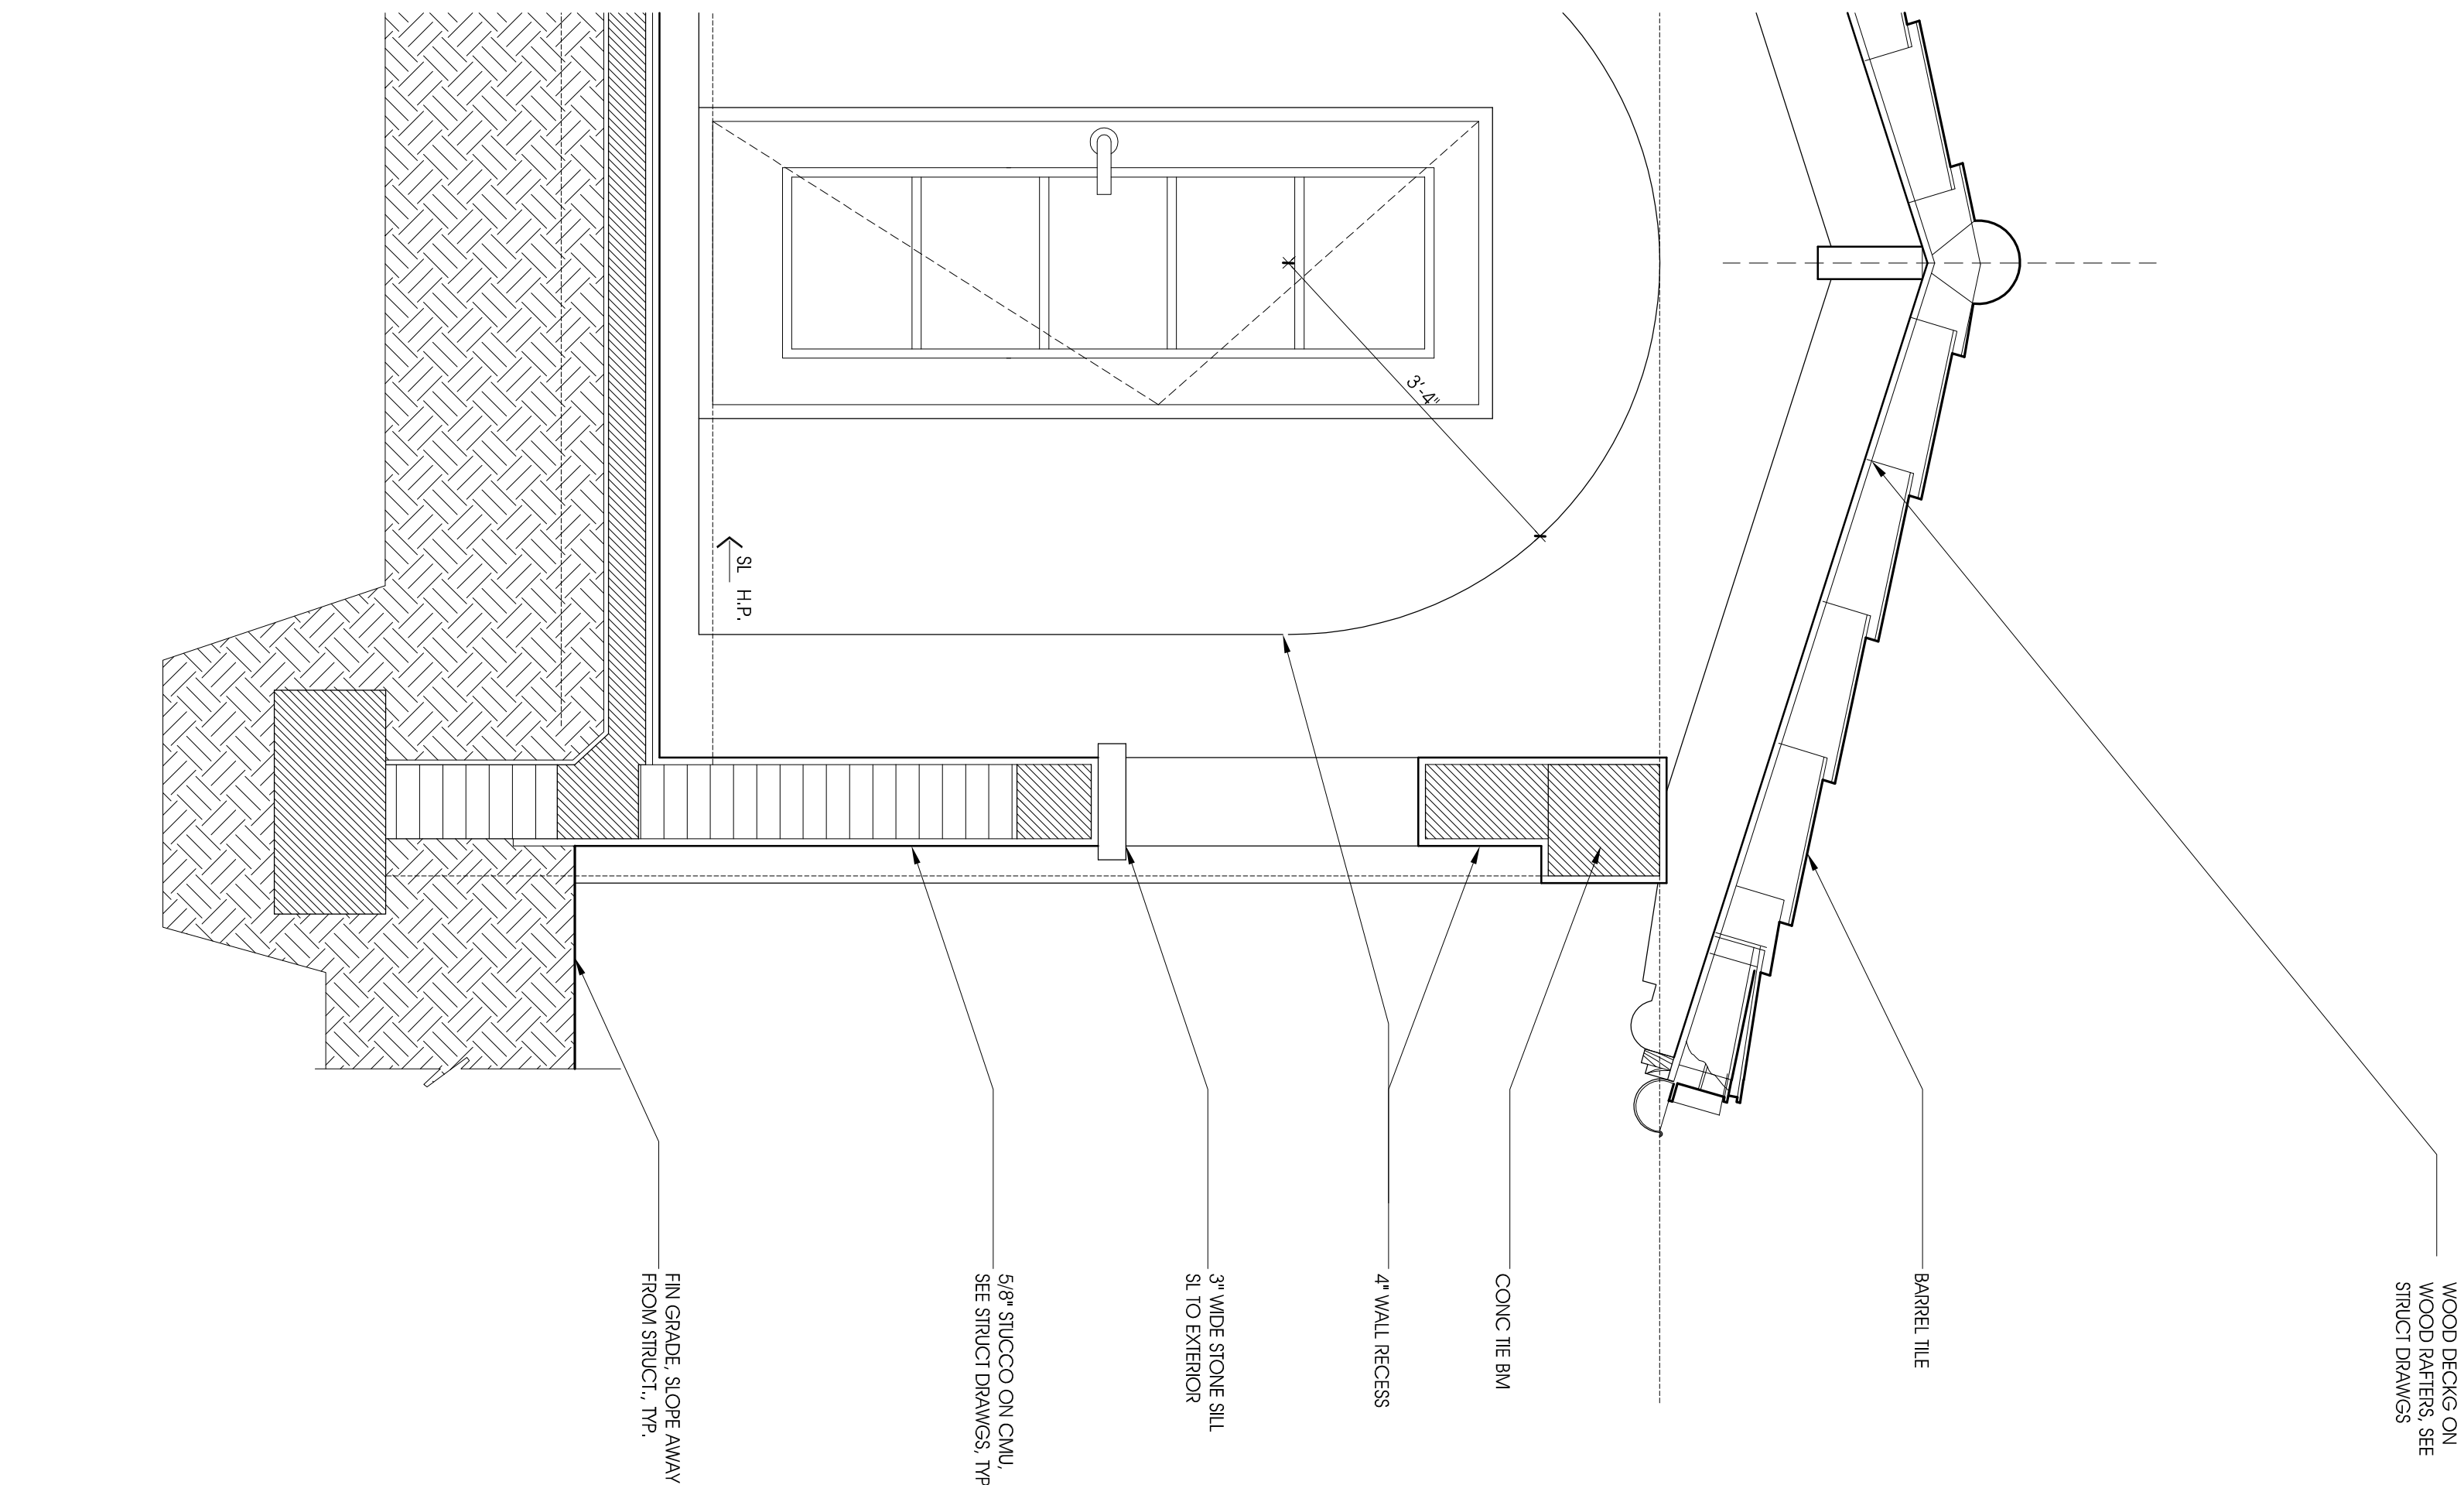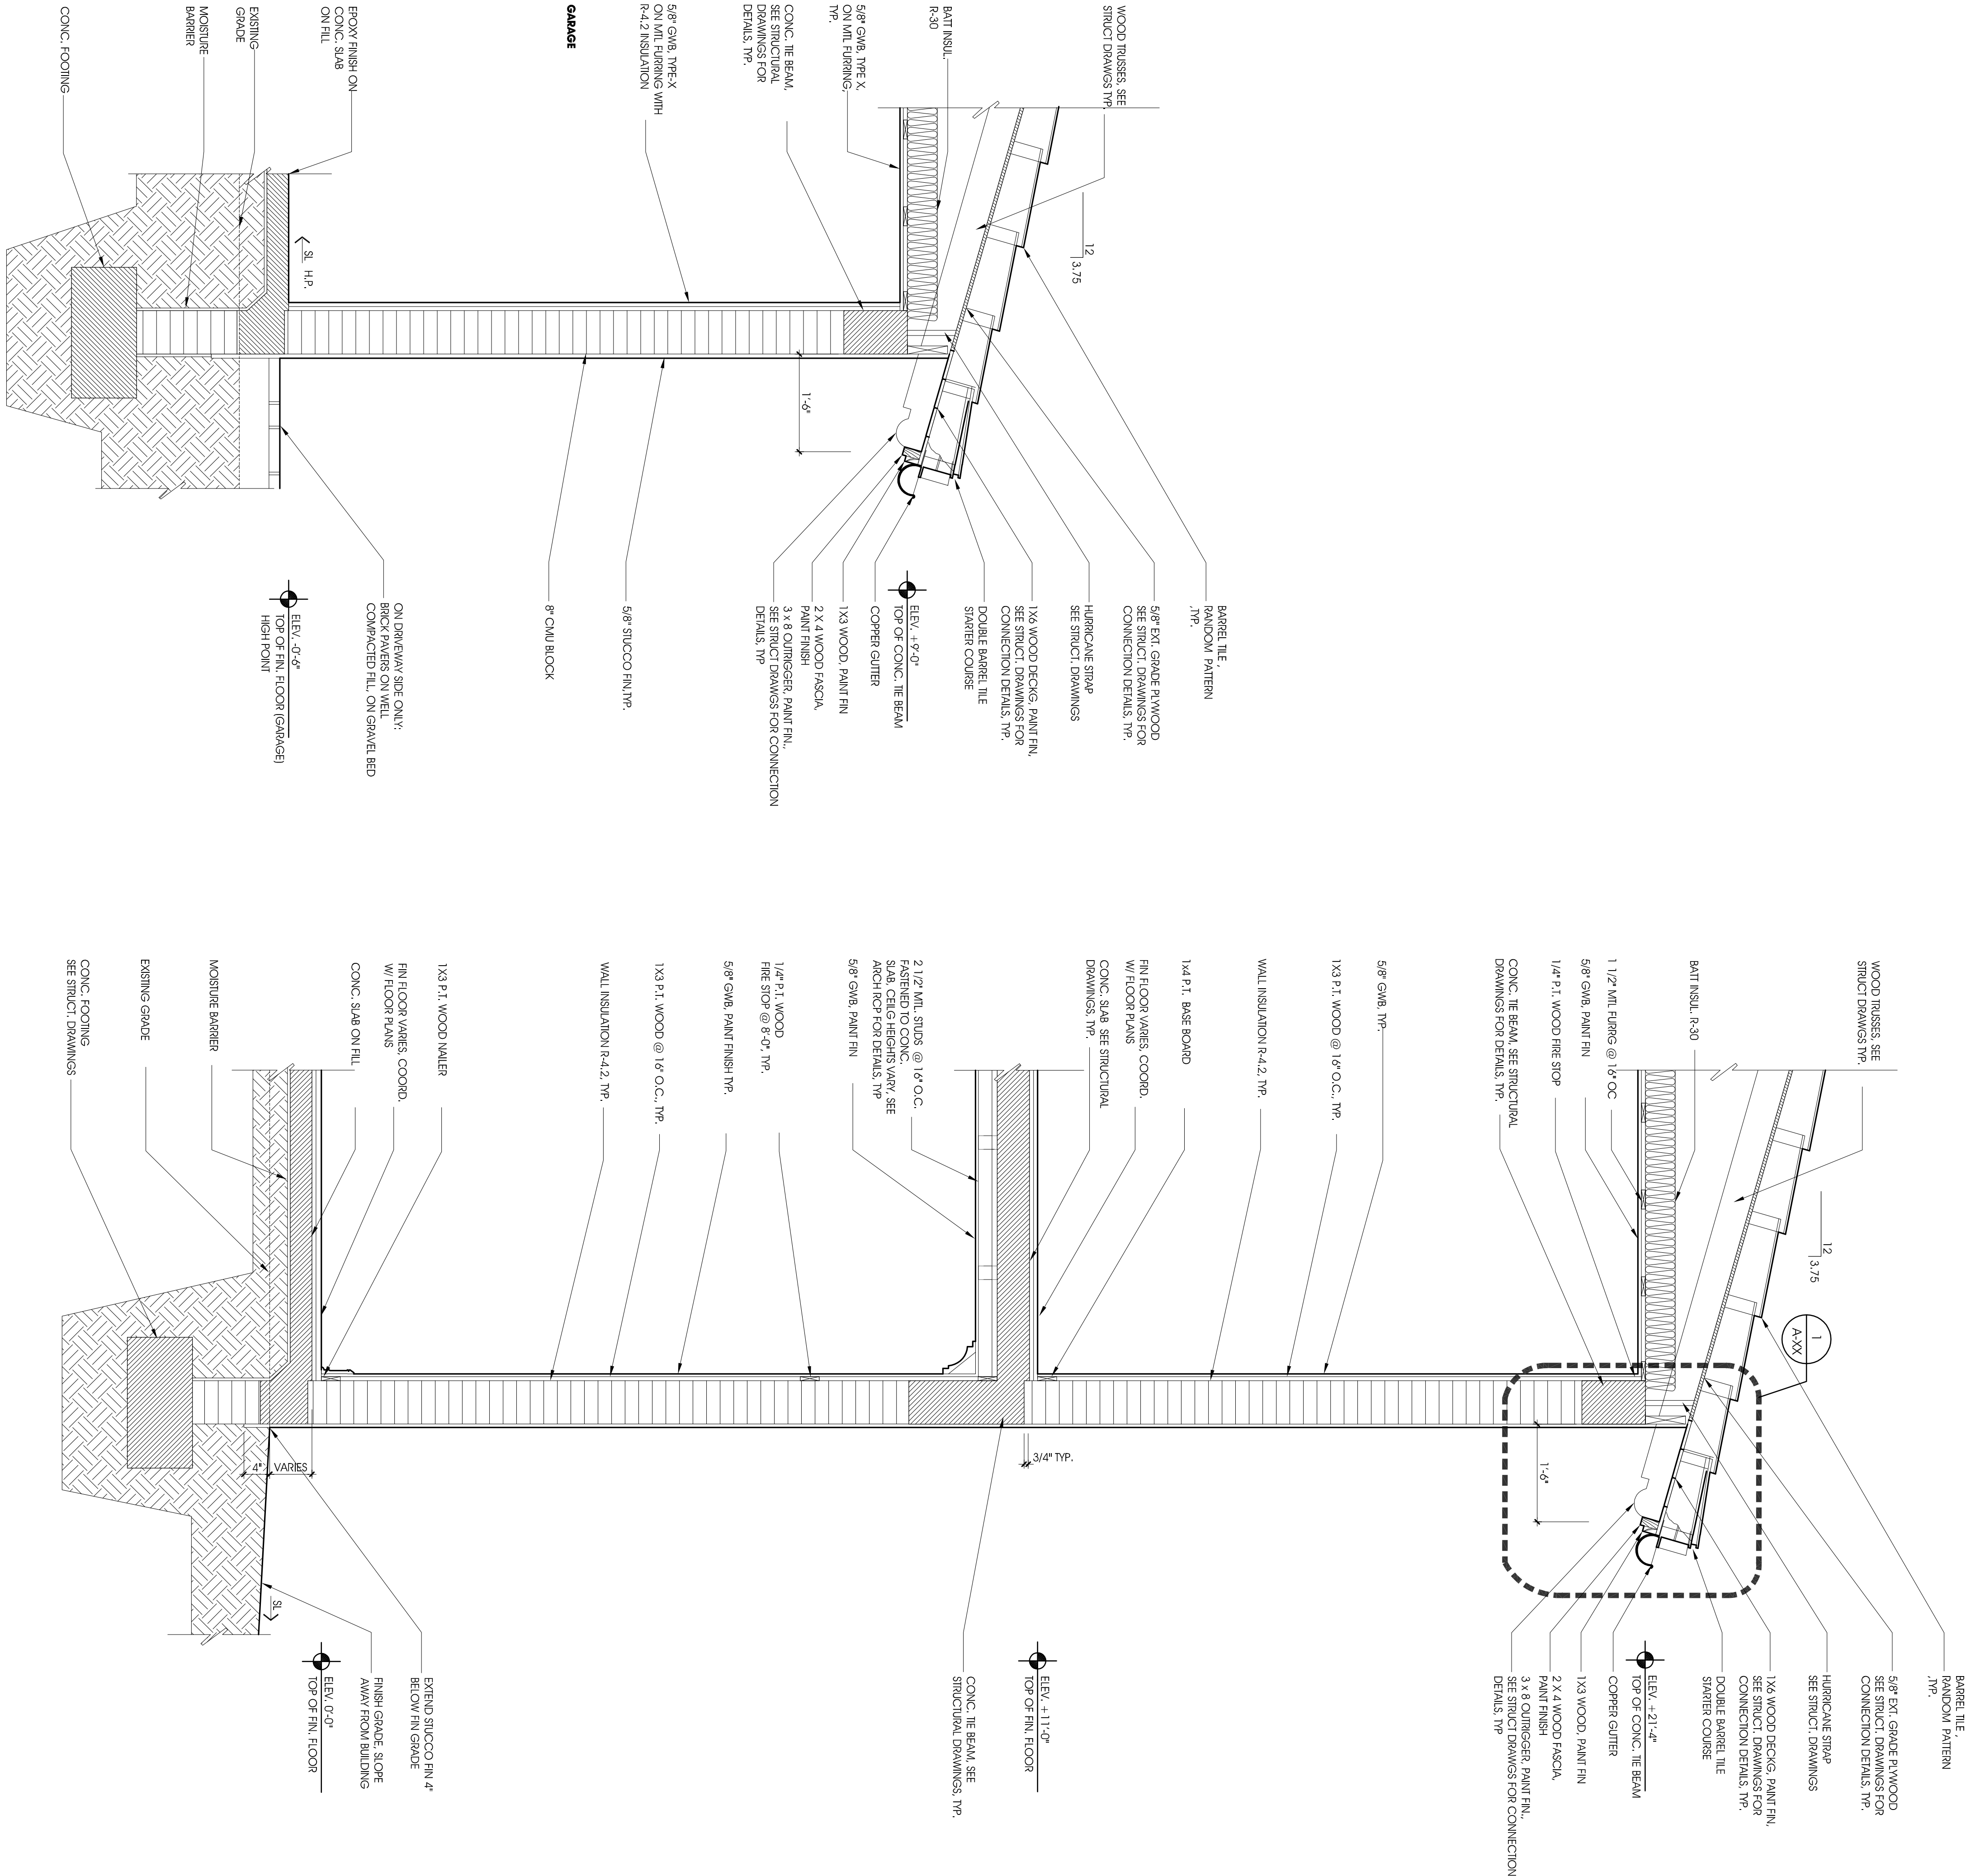[illegible]

WALL SECTION @ LOGGIA

SCALE: $3/4" = 1'-0"$

WALL SECTION @ GARAGE

SCALE: $3/4" = 1'-0"$


TYPICAL WALL SECTION

SCALE: 3/4" = 1'-0"

WINDOW SCHEDULE


[illegible]

- NOTES:
1. ALL WINDOWS BY CGI.
2. ALL WINDOWS SHALL BE IMPACT RESISTANT, 7/16" THICK.
3. HARDWARE AS SELECTED BY ARCHITECT, CLEAR GLASS, WHITE FRAMES.
4. EGRESS WINDOWS SHOULD CLEAR OPENING FOR NO LESS THAN 20" IN WIDE AND 24" IN HEIGHT.
5. EGRESS WINDOWS, BOTTOM OF OPENINGS SHALL NOT BE MORE THAN 44" ABOVE FINISHED FLOOR.
6. AND 5" OF AREA, BOTTOM OF OPENINGS SHALL NOT BE MORE THAN 44" ABOVE FINISHED FLOOR.
7. OPERABLE WINDOWS WILL HAVE SCREENS.
8. WINDOW MANUFACTURER/INSTALLER TO FIELD VERIFY ALL OPENINGS.

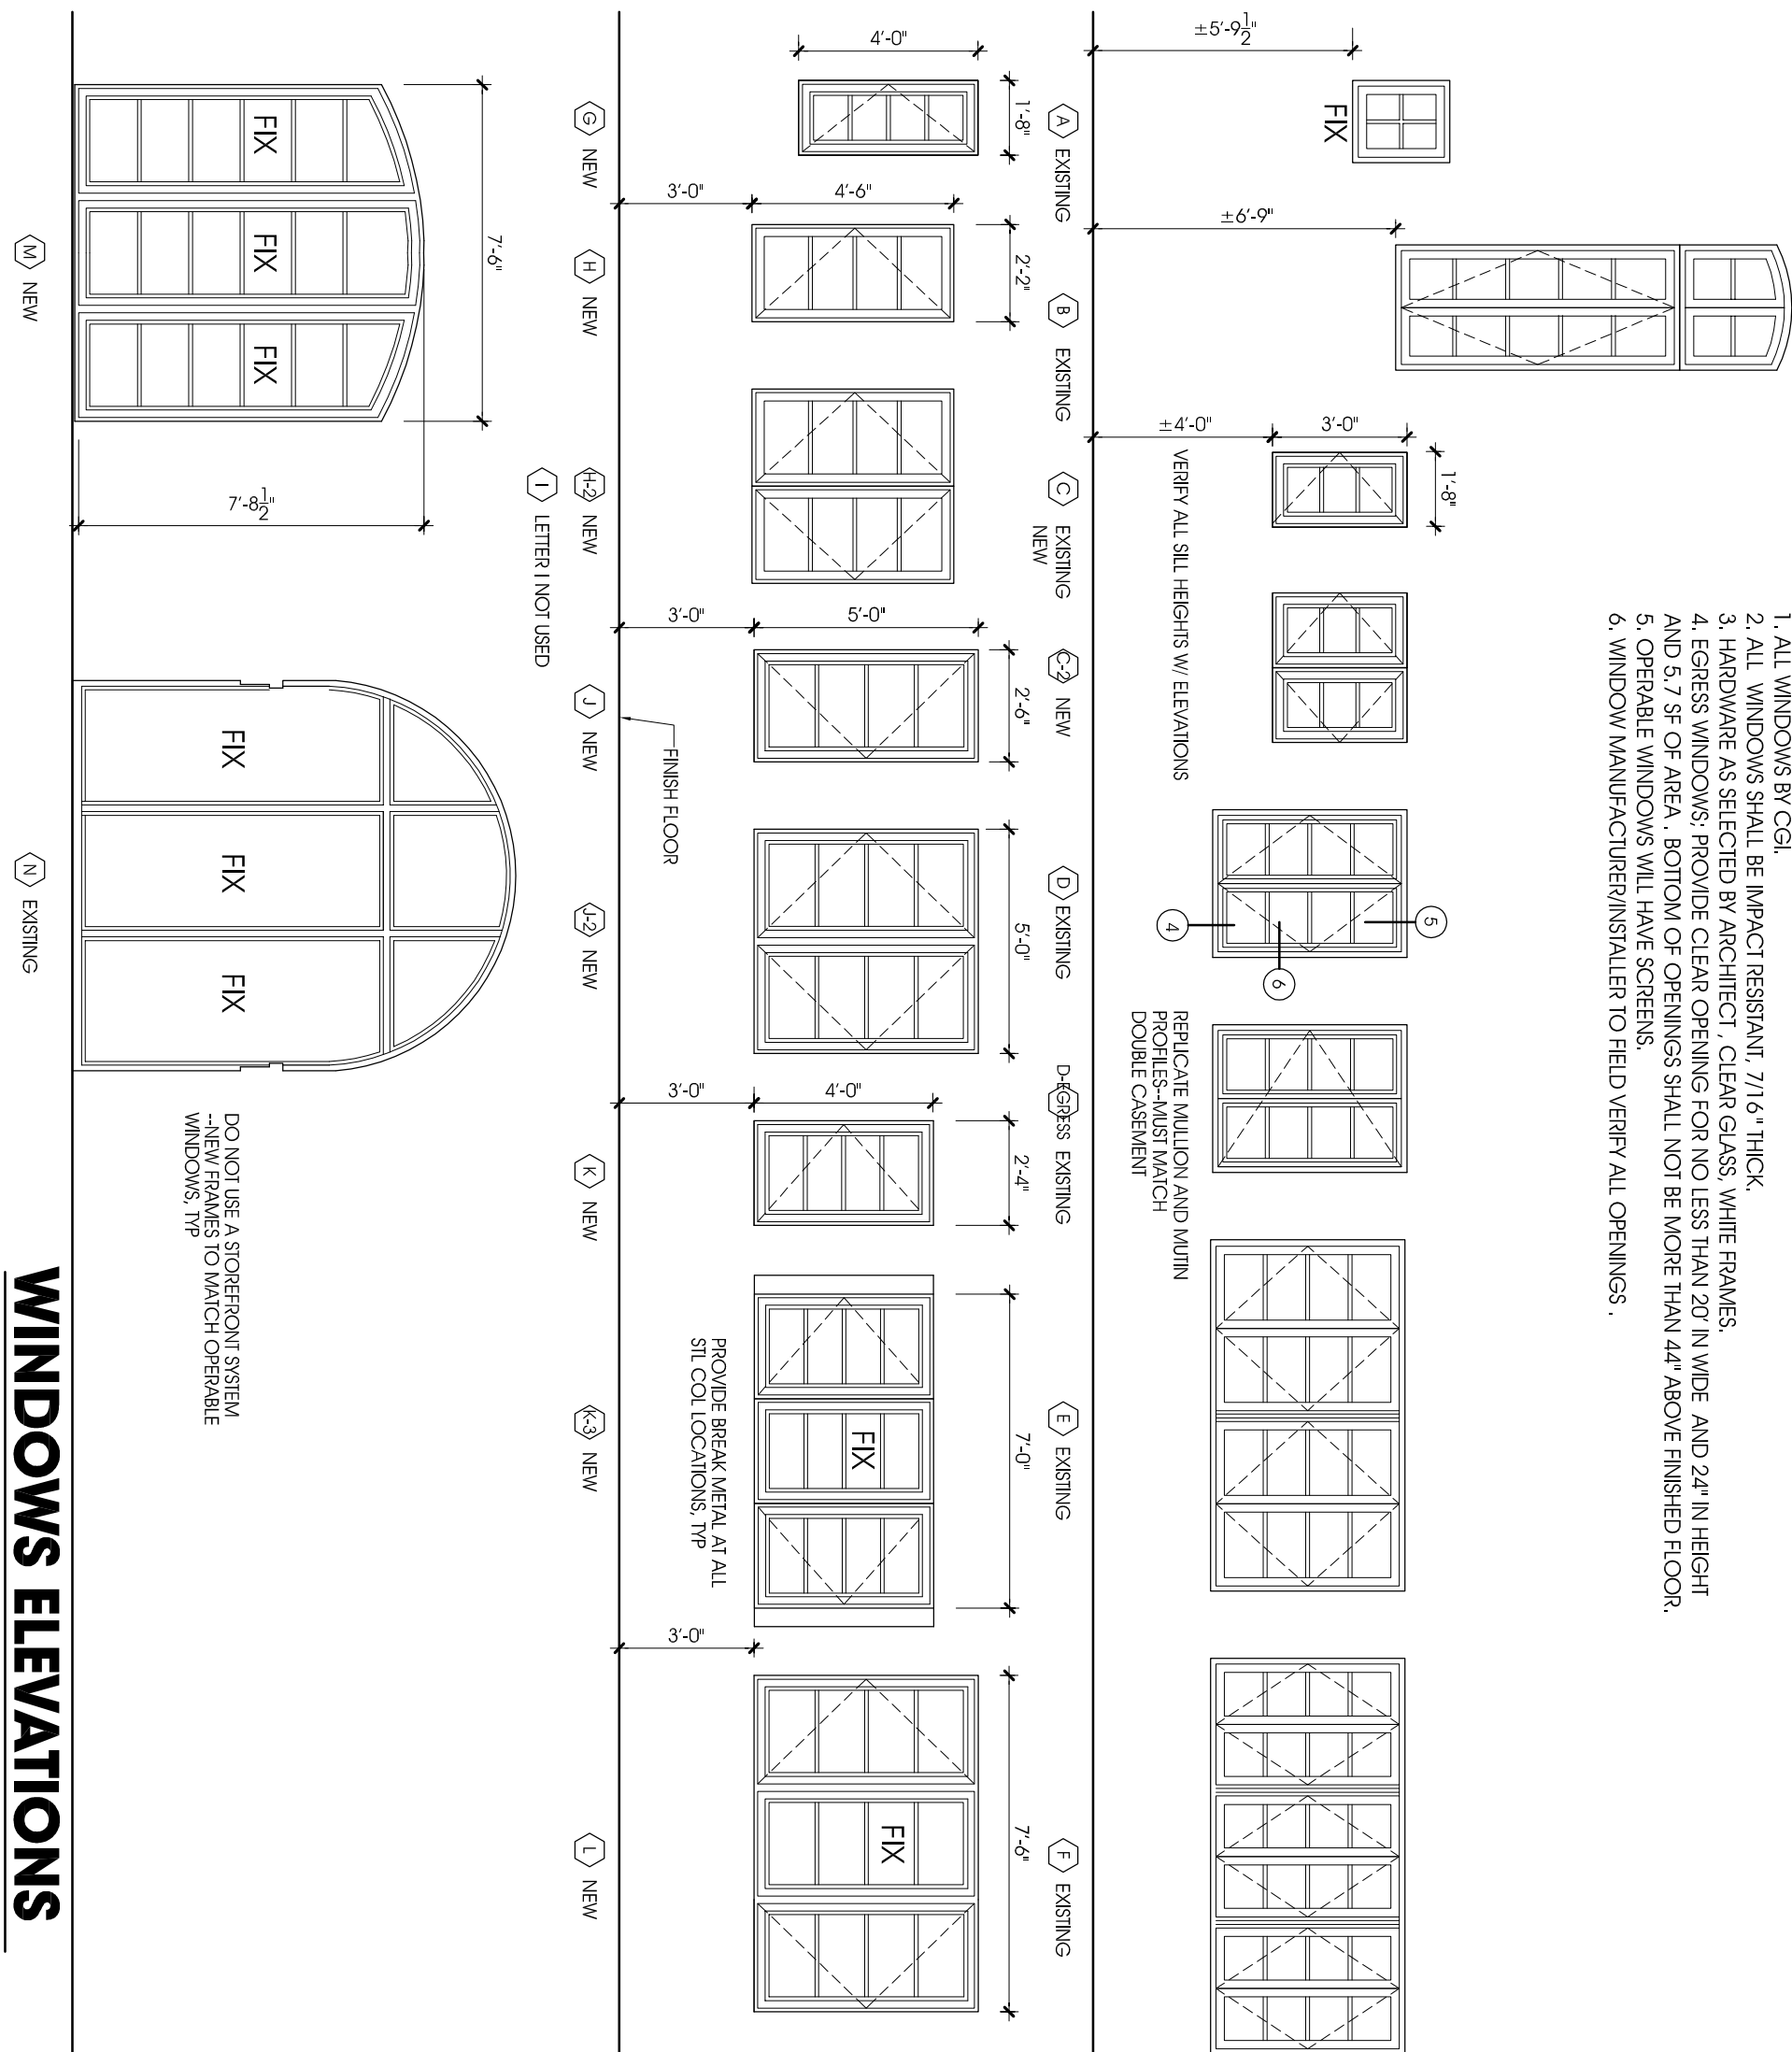


WINDOWS ELEVATIONS

SCALE: 1/4" = 1'-0"

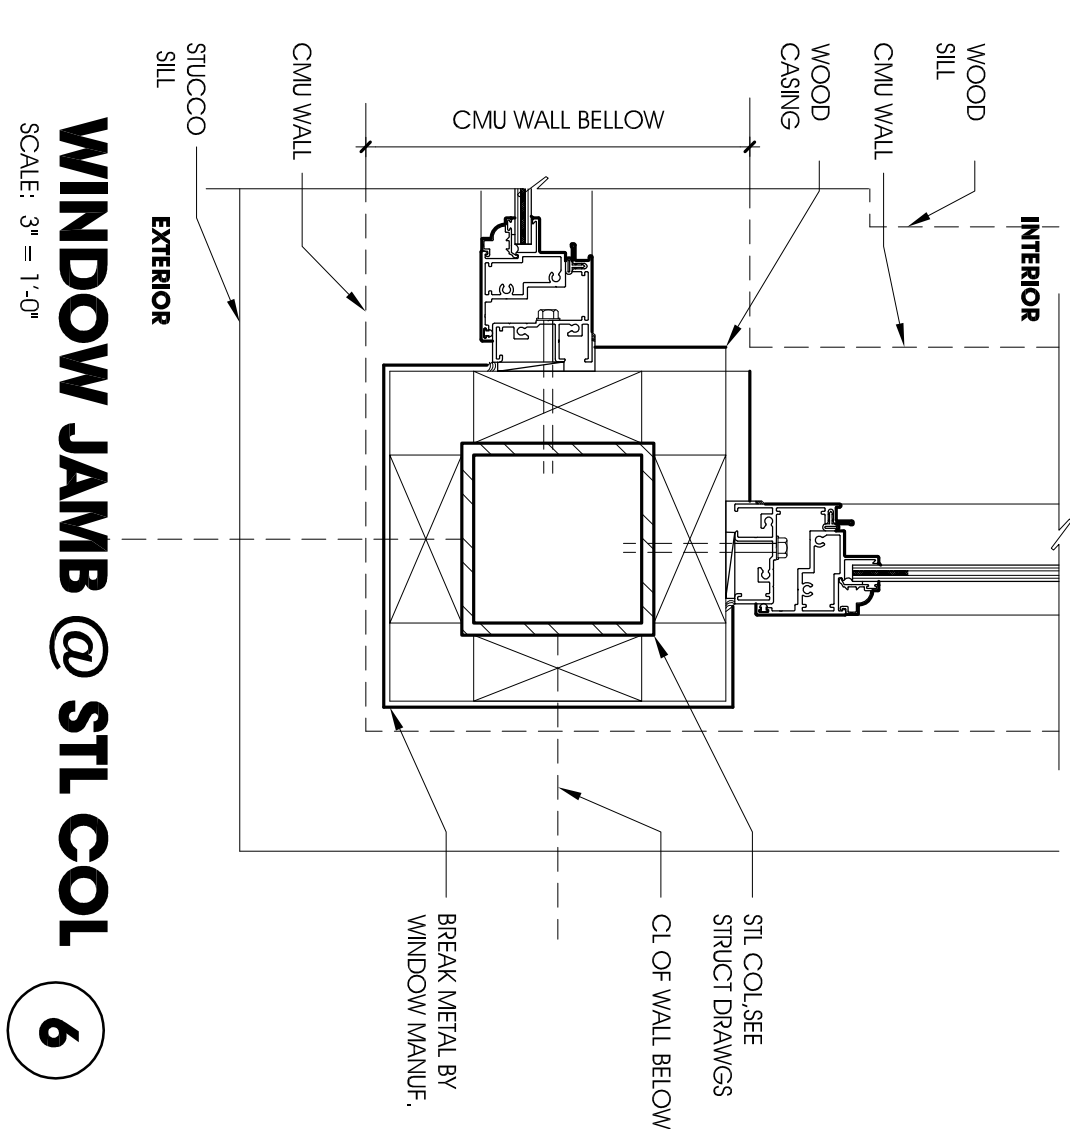

WINDOW JAMB @ STL COL
SCALE: 3" = 1'-0"

SCALE: 3" = 1'-0"

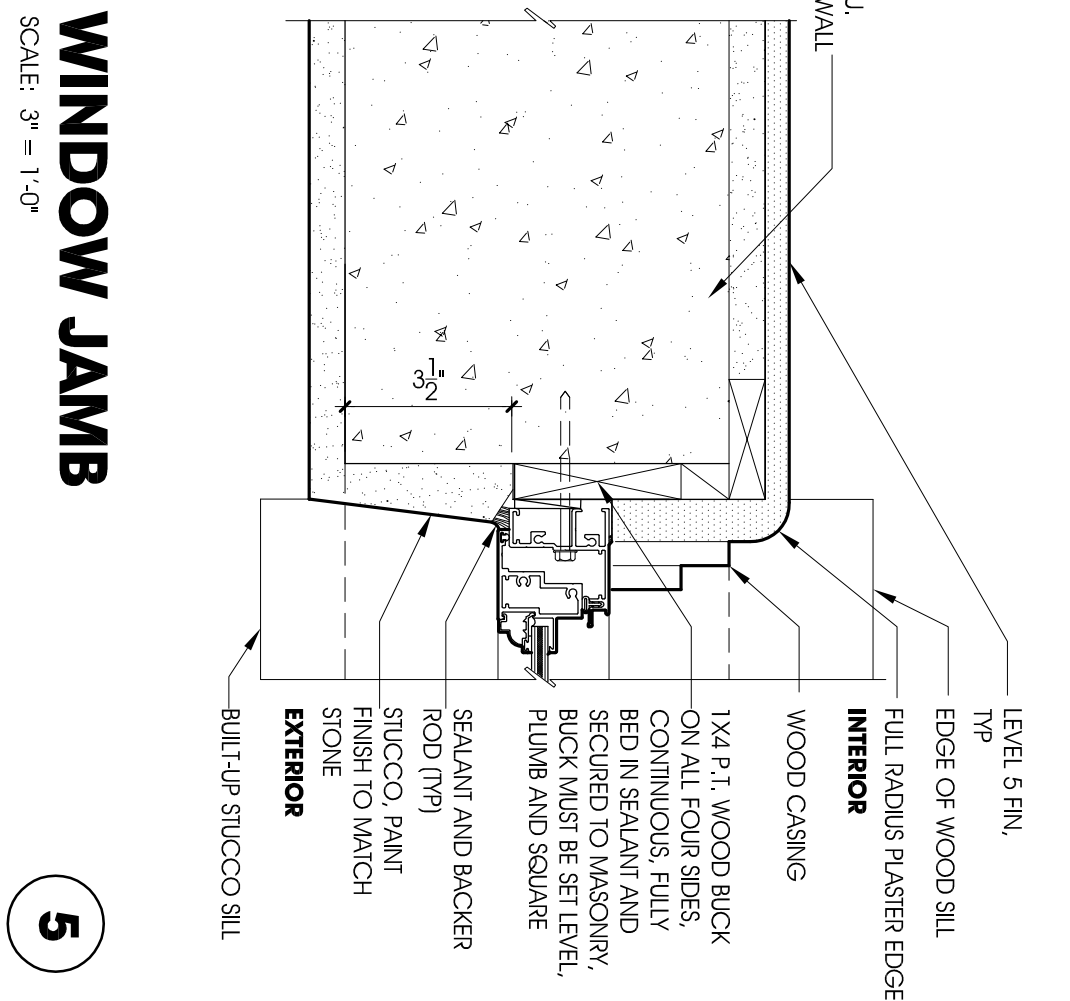


WINDOW JAMB
SCALE: 3" = 1'-0"

SCALE: 3" = 1'-0"

FIRST FLOOR DOOR SCHEDULE


DOORS							FAMES					EMERGENCY EGRESS GROUP
DOOR #	TYPE	MATL.	FIN.	WIDTH	HEIGHT	THICK.	TYPE	MATL.	FIN.	JAMB	HEAD	
101	A	MDFL.		10'-2"	7'-0"	-	WO					YES
102	G	FRNT		2'-6"	7'-0"	-	WO					-
103	BBE	MDFL.	FRNT	-	-	-	WO					-
104	BBE	MDFL.	FRNT	-	-	-	WO					-
105	BBE	MDFL.	FRNT	-	-	-	WO					-
106	B	MDFL.		8'-0"	6'-0"	-	MEL					YES
107	B	MDFL.		8'-0"	6'-0"	-	MEL					YES
108	B	MDFL.		8'-0"	6'-0"	-	MEL					YES
109	B	MDFL.		8'-0"	6'-0"	-	MEL					YES
110	B	MDFL.		8'-0"	6'-0"	-	MEL					YES
111	D	MDFL.		2'-6"	8'-0"	-	MEL					YES
112	C	MDFL.		10'-2"	8'-0"	-	MEL					YES
113	B	MDFL.		8'-0"	6'-0"	-	MEL					YES
114	B	FRNT		2'-6"	8'-0"	-	WO					-
115	B	FRNT		2'-6"	8'-0"	-	WO					-
116	GRAND	MEL.		9'-0"	8'-0"	-	MEL					YES
117	GRAND	MEL.		9'-0"	8'-0"	-	MEL					YES
118	GRAND	MEL.		9'-0"	8'-0"	-	MEL					YES
119	C	MDFL.		10'-2"	8'-0"	-	MEL					YES
120	B	MDFL.		8'-0"	6'-0"	-	MEL					YES
121	C	MDFL.		10'-2"	8'-0"	-	MEL					YES
122	D	MDFL.		2'-6"	8'-0"	-	MEL					YES
123	F	FRNT		10'-10"	7'-0"	1 1/2"	WO					-
124	F	FRNT		10'-10"	7'-0"	1 1/2"	WO					-
125	E	FRNT		2'-6"	7'-0"	1 1/2"	WO					-
126	E	FRNT		2'-6"	7'-0"	1 1/2"	WO					-
127	G	WO		2'-6"	7'-0"	1 1/2"	WO					LOADED
128	E	WO		2'-6"	8'-0"	1 1/2"	WO					RESEALING AND COMBAT
129	G	WO		2'-6"	8'-0"	1 1/2"	WO					LOADED
130	E	WO		2'-6"	8'-0"	1 1/2"	WO					COORD W/ LEADERS RESULTS
131	E	WO		2'-6"	8'-0"	1 1/2"	WO					-
132	E	WO		2'-6"	8'-0"	1 1/2"	WO					-
133	F	WO		10'-2"	8'-0"	1 1/2"	WO					LOADED
134	F	WO		10'-2"	8'-0"	1 1/2"	WO					LOADED
135	E	WO		2'-6"	8'-0"	1 1/2"	WO					-
136	E	WO		2'-6"	8'-0"	1 1/2"	WO					-
137	E	WO		2'-6"	8'-0"	1 1/2"	WO					-
138	H	WO		3'-0"	8'-0"	1 1/2"	WO					LOADED
139	H	WO		3'-0"	8'-0"	1 1/2"	WO					POCKET

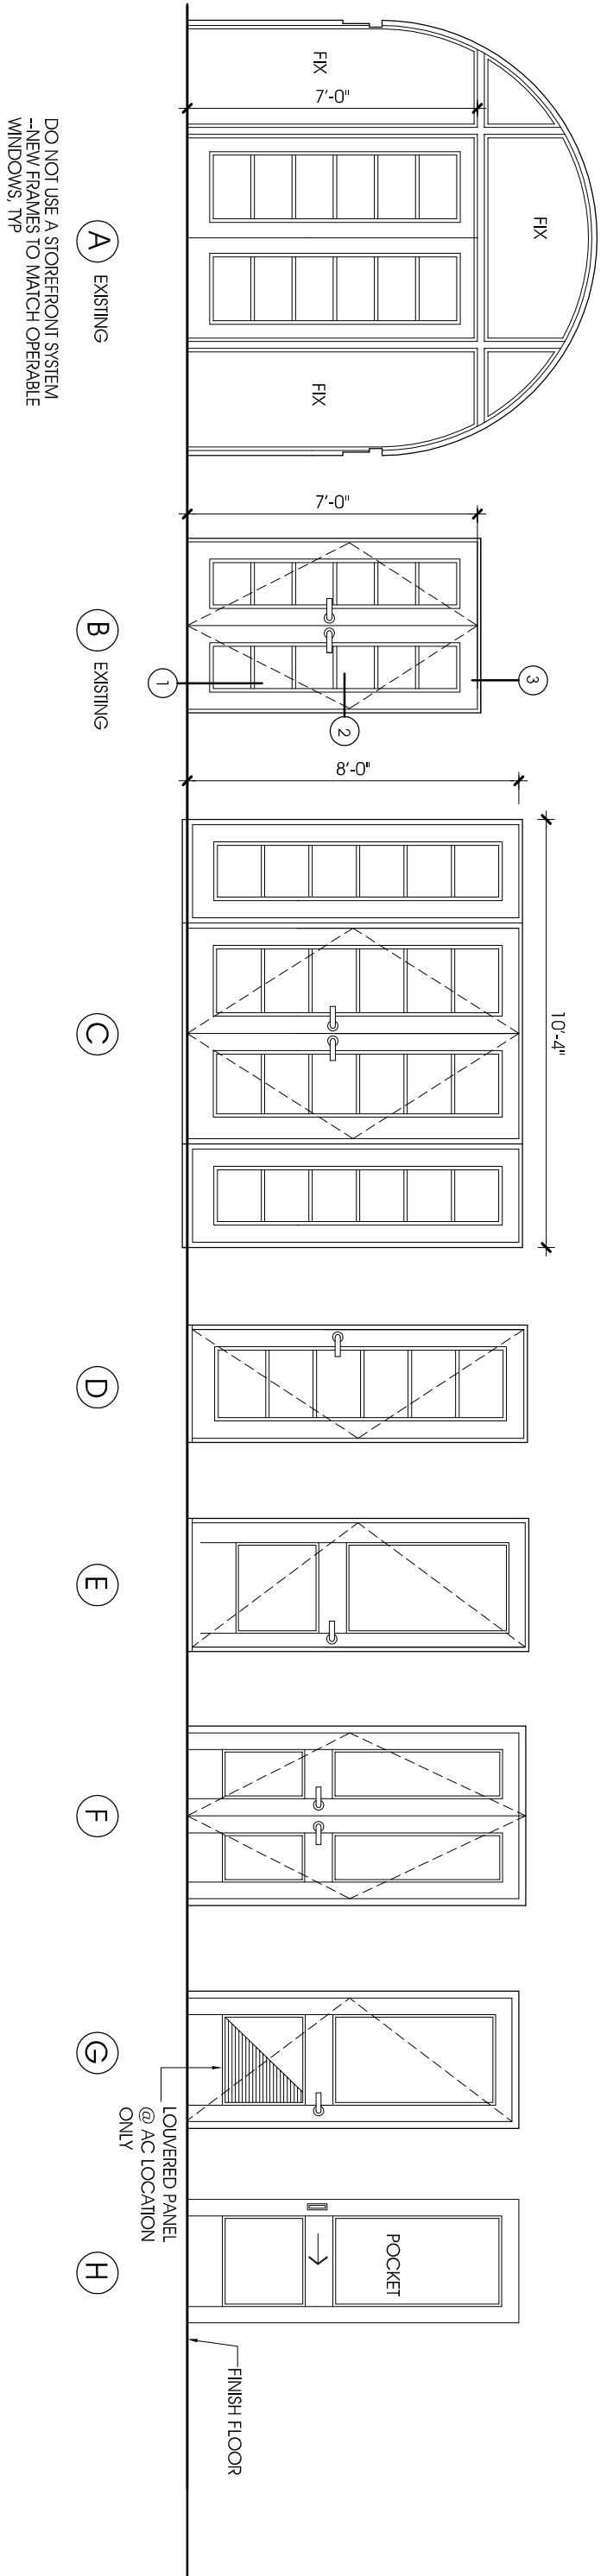

SECOND FLOOR DOOR SCHEDULE


DOORS													FRAMES				DETAILS			JAMB GROUP	REMARKS
DOOR TYPE	MAT.	FIN.	WIDTH	HIGHT	HICK	TYPE	MAT.	FIN.	JAMB	HEAD	SILL	INSET	GLASS								
201	E	WOOD	12'-2 1/2"	8'-0"	1 3/4"	WD	PAINT	-	-	-	-	YES	-	WATER-RESIST & INSULATION STRIP							
202	E	WOOD	5'-0"	8'-0"	1 3/4"	WD	-	-	-	-	-	-	-	-							
203	E	WOOD	5'-0"	8'-0"	1 3/4"	WD	-	-	-	-	-	-	-	COORD. W/ REVISION RECORDS							
204	E	WOOD	2'-6"	8'-0"	1 3/4"	WD	-	-	-	-	-	-	-	-							
205	E	WOOD	2'-6"	8'-0"	1 3/4"	WD	-	-	-	-	-	-	-	-							
206	E	WOOD	2'-6"	8'-0"	1 3/4"	WD	-	-	-	-	-	-	-	-							
207	G	WOOD	2'-6"	8'-0"	1 3/4"	WD	-	-	-	-	-	-	-	LOCKERED							
208	G	WOOD	2'-6"	8'-0"	1 3/4"	WD	-	-	-	-	-	-	-	LOCKERED							
209	E	WOOD	2'-6"	8'-0"	1 3/4"	WD	-	-	-	-	-	-	-	LOCKERED							
210	E	WOOD	2'-6"	8'-0"	1 3/4"	WD	-	-	-	-	-	-	-	PROVIDE DOWEL AND DOOR WINDL STOP							
211	E	WOOD	2'-6"	8'-0"	1 3/4"	WD	-	-	-	-	-	-	-	-							
212	E	WOOD	5'-0"	8'-0"	1 3/4"	WD	-	-	-	-	-	-	-	LOCKERED							
213	E	WOOD	5'-0"	8'-0"	1 3/4"	WD	-	-	-	-	-	-	-	LOCKERED							
214	E	WOOD	12'-1 1/2"	7'-0"	1 3/4"	WD	-	-	-	-	-	-	-	LOCKERED							
215	F	WOOD	12'-1 1/2"	7'-0"	1 3/4"	WD	-	-	-	-	-	-	-	LOCKERED							
216	F	WOOD	12'-1 1/2"	7'-0"	1 3/4"	WD	-	-	-	-	-	-	-	-							
217	F	WOOD	12'-1 1/2"	7'-0"	1 3/4"	WD	-	-	-	-	-	-	-	-							
218	E	WOOD	12'-1 1/2"	7'-0"	1 3/4"	WD	-	-	-	-	-	-	-	-							
219	E	WOOD	12'-1 1/2"	7'-0"	1 3/4"	WD	-	-	-	-	-	-	-	EXISTING CLOSING AND FRAME TO REMAIN							
220	E	WOOD	12'-1 1/2"	7'-0"	1 3/4"	WD	-	-	-	-	-	-	-	EXISTING CLOSING AND FRAME TO REMAIN							
221	E	WOOD	12'-1 1/2"	7'-0"	1 3/4"	WD	-	-	-	-	-	-	-	EXISTING CLOSING AND FRAME TO REMAIN							

1. ALL EXTERIOR DOORS BY CGI.
2. ALL EXTERIOR DOORS SHALL BE IMPACT RESISTANT 7/16" CLEAR GLASS, WHITE FRAMES.
3. HARDWARE AS SELECTED BY ARCHITECT.
4. ALL GLASS SHOWER DOORS WILL BE 1/2" TEMPERED SAFETY GLASS
5. ALL INTERIOR DOORS SHALL BE SOLID CORE.

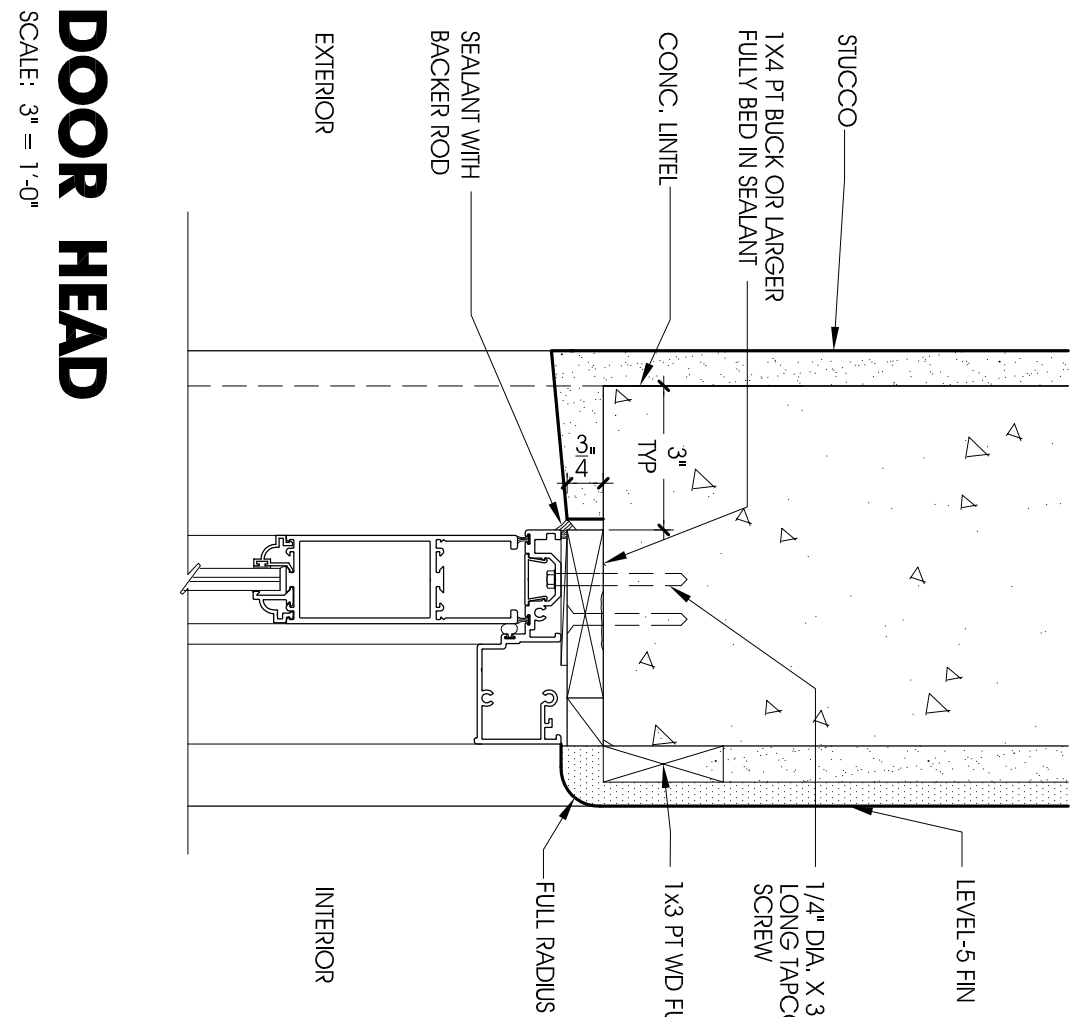

2 **DOOR SILL**
SCALE: 3" = 1'-0"

SCA

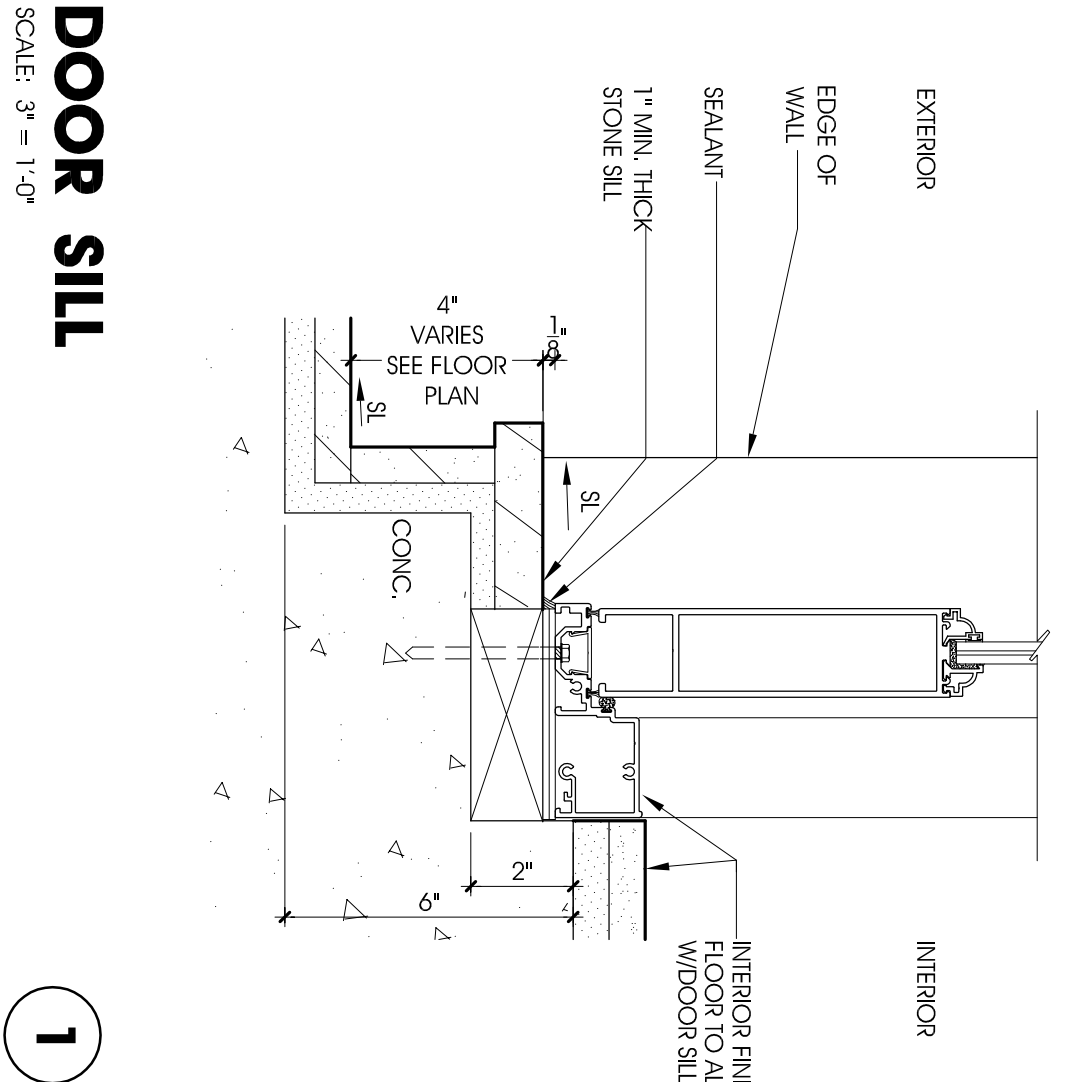

A-13

①

DOOR ELEVATIONS

SCALE: 1/4" = 1'-0"

[illegible]

