




SOUTH ELEVATION 30' W x 11' 0"

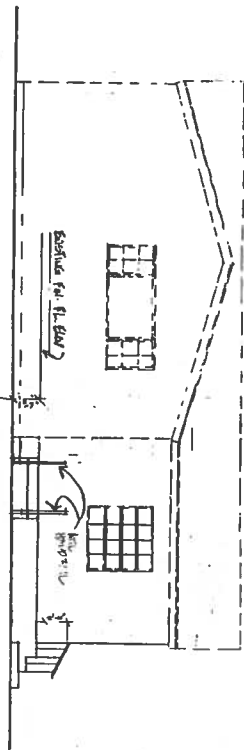

EAST ELEVATION 30' W x 11' 0"

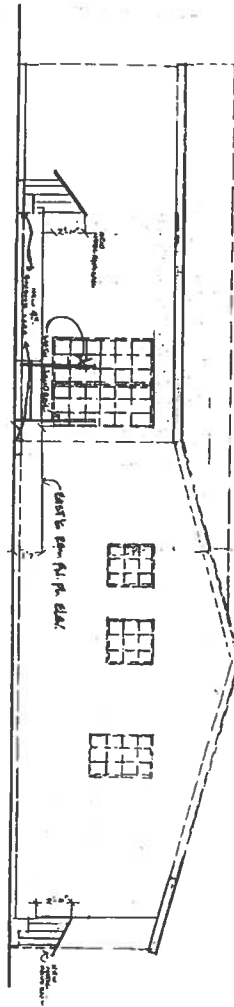

NORTH ELEVATION 30' W x 11' 0"

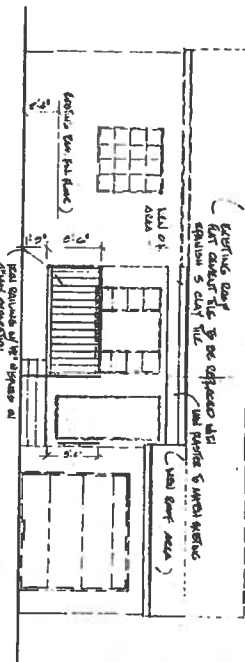

NOTE:
ARCHITECT'S PLANS
WITH PERMIT NO. 9902893.

[Signature]
4/30/98

RESIDENCE IMPROVEMENT FOR MR + MRS IGLESIAS
118 SARTO AVE CORAL GABLES, FLA 33134
ELEVATIONS

RAUL C. RAKELA, AIA RA 14759 - 123 SARTO AVE CA FL 33134 TEL 305.461.2503

AS BUILT

AS-BUILT
4/20/98

98056327

Porch As-Built

7

Revision to
OFFICE SET
#17199

perm. #

93030343

[illegible]

LINK → a2108535
P903