

HISTORICAL PHOTO, 1920'S

COA HISTORICAL SUBMITTAL (MASTER PLAN): 02-06-23 BOA SUBMITTAL: 12-21-23 COA HISTORICAL SUBMITTAL (REMODEL & ADDITIONS): 02-26-24

# HISTORICAL: REMODEL & ADDITIONS SOANE RESIDENCE

1104 Malaga Avenue, Coral Gables, FL 33134

Project Team

INCORP 500 South Di	orated xie Highway, Suite 307		ARCHITECTURE
Coral Gable Tel (305) 740	s, Florida 33146 I-0120 ocusarchitecture.net		
	as Soane owner	Torre Con	npanies contractor
1036 Andalu		208 Andalusia Av	
Coral Gable: Tel.: 3472869	s, Florida 33134 9284	Coral Gables, FL Tel 305-442-9494	
Email: nvsoa	ne@gmail.com		rrecompanies.com
Roche	Il Engineering structural	HL MARTIN	- EANDOCAL EARCHILECT
1500 N.W. 89 Doral, FL 331	Pth Court, Suite 212 72	5965 S.W. 38th Str Miami, FL 33155	reet
Tel.: (305) 64 Email: alex@		Tel.: (305) 790-437 Email: hImartinufiu	
icence No:		License No.: RLA#	<sup>4</sup> 0001722 (LC#26000404)
ENESU (	& Associates, Inc. MEP	SB Engine	eering, Inc. SEPTIC SYSTEM
13818 SW 15 Miami, Fl 331	2nd Street, Suit 302 177	Sarima Batista Tel.:(305) 631-214	45
Tel.: (786) 49 Email: egarc	6 4295 ia@enesu.com	Email: sbenginc@	
License No. 2			
Drawing	g Contents		
SHEET NO.	SHEET CONTENTS		
	SURVEY	S-9	SECTION 3 & 4
		S-10	DETAILS
ARCHITECTUI		S-11	DETAILS
A-01.0	PROPOSED SITE PLAN AND ZONING INFORMATION	S-12	DETAILS
A-01.1	AREA DIAGRAMS AND CALCULATIONS	S-13	STRUCTURAL NOTES
A-01.2	EXISTING AND DEMOLITION SITE PLAN		ul
A-01.3 A-01.4	ENLARGED SITE PLAN DETAIL SITE WALLS AND DETAILS	MECHANICA M-1	MECHANICAL PLAN, FIRST FLOOR
4-01.4 4-02.0	EXISTING AND DEMOLITION FIRST FLOOR PLAN	M-2	MECHANICAL PLAN, SECOND FLOOR
A-02.1	EXISTING AND DEMOLITION SECOND FLOOR PLAN	M-3	MECHANICAL NOTES, LEGEND AND SCHEDULES
4-02.2	PROPOSED FIRST FLOOR PLAN	M-4	MECHANICAL DETAILS
<b>A-02.3</b>	PROPOSED SECOND FLOOR PLAN		
4-03.0	PROPOSED FIRST FLOOR REFLECTED CEILING PLAN	ELECTRICAL	
A-03.1	PROPOSED SECOND FLOOR REFLECTED CEILING PLAN	E-01	ELECTRICAL SITE PLAN
A-04.0	EXISTING AND DEMOLITION ROOF PLAN	E-02	LIGHTING PLAN, FIRST FLOOR
A-04.1	PROPOSED ROOF PLAN	E-03	POWER PLAN, FIRST FLOOR
4-05.0	EXISTING, DEMOLITION AND PROPOSED FRONT ELEVATION	E-04	LIGHTING PLAN, SECOND FLOOR
A-05.1	EXISTING, DEMOLITION AND PROPOSED REAR ELEVATION	E-05	POWER PLAN, SECOND FLOOR
A-05.2	EXISTING, DEMOLITION AND PROPOSED EAST ELEVATION	E-06	ELECTRICAL PANEL SCHEDULES
A-05.3	EXISTING, DEMOLITION AND PROPOSED WEST ELEVATION	E-07	ELECTRICAL POWER RISER, CALCULATIONS AND NOTES
A-05.4	PROPOSED PARTIAL ELEVATIONS (LOGGIA AND GARAGE)	<b></b>	
A-05.5	PROPOSED BUILDING SECTIONS	PLUMBING	DILIM ADINIC CITE DI ANI
A-06.0 A-06.1	WALL SECTION 1 & 2 WALL SECTION 3 & 4	P-01	PLUMBING SITE PLAN
A-06.1 A-06.2	WALL SECTION 3 & 4 WALL SECTION 5	P-02	SANITARY PLAN, FIRST FLOOR
A-06.2 A-06.3	WALL SECTION 5 WALL SECTION 6	P-03	Water Plan, first floor Water Plan, first floor
A-00.0 A-07.0	DOOR SCHEDULE AND DETAILS	P-04 P-05	GAS PARTIAL PLAN, FIRST FLOOR AND GAS RISER
A-07.1	WINDOW SCHEDULE AND DETAILS	P-05 P-06	WATER AND SANITARY PLAN, SECOND FLOOR
A-08.0	DETAILS	P-07	ROOF PLAN
		P-08	PLUMBING SCHEDULES AND DETAILS
STRUCTURAL		P-09	PLUMBING GENERAL NOTES, SCHEDULES AND DETAILS
G-0	SITE WALL PLAN		
-0A	PARTIAL SITE WALL ELEVATION	LANDSCAPE	
G-1	FOUNDATION & GROUND FLOOR PLAN	L-01.0	LANDSCAPE PLAN
S-2	SECOND FLOOR PLAN	L-01.1	NOTES, DETAILS & LEGEND
S-3	ROOF FRAMING PLAN	L-01.2	TREE SURVEY/DISPOSITION PLAN
S-4	ELEVATIONS: WINDOW PRESSURES	L-01.3	TREE DISPOSITION & PROTECTION
S-5	ELEVATIONS: WINDOW PRESSURES	L-01.4	GRADING PLAN
S-6	ELEVATIONS: WINDOW PRESSURES	L-01.4	IRRIGATION PLAN
S-7	SCHEDULE & DETAILS		
5-8	SECTION 1 & 2	SEPTIC	
	IT OUDS ATT AT 40 00 0000	SP-1	SEPTIC SYSTEM SITE PLAN

## PERMIT SUBMITTAL: 10-28-2023 PERMIT SUBMITTAL REV 3: 01-27-2025

#### **GENERAL NOTES**

A. THE TERM "WORK" AS USED IN THESE NOTES SHALL INCLUDE ALL PROVISIONS AS DRAWN OR SPECIFIED IN THESE DOCUMENTS AS WELL AS ALL OTHER PROVISIONS SPECIFICALLY INCLUDED BY THE OWNER IN THE FORM OF DRAWINGS, SPECIFICATIONS, AND WRITTEN INSTRUCTIONS AND APPROVED BY THE ARCHITECT OF RECORD.

B. THE TERM "CONTRACTOR" AS USED IN THESE NOTES SHALL REFER TO THE GENERAL CONTRACTOR OR TO THE SUBCONTRACTORS. THE OWNER MAY ELECT TO CONTRACT DIRECTLY WITH A SUBCONTRACTOR FOR ANY PART

C. THESE DRAWINGS PROVIDE FOR THE LABOR, MATERIAL, EQUIPMENT AND SUPERVISION BY THE CONTRACTOR FOR A COMPLETE LOCK AND KEY JOB WITH THE ITEMS SPECIFICALLY NOTED FURNISHED BY THE CONTRACTOR OR AS AN ALLOWANCE. THE WORK SHALL BE EXECUTED IN A THOROUGH, SUBSTANTIAL AND NEAT MANNER. THE CONTRACTOR SHALL BE RESPONSIBLE FOR ALL PERMITS.

D. IF THE CONTRACT DRAWINGS ARE FOUND TO BE UNCLEAR, AMBIGUOUS OR CONTRADICTORY, THE CONTRACTOR MUST REQUEST CLARIFICATION FROM THE ARCHITECT OF RECORD IN WRITING BEFORE PROCEEDING WITH THAT PART OF THE WORK.

E. ALL WORK SHALL BE IN CONFORMANCE WITH THE REQUIREMENTS OF THE FLORIDA RESIDENTIAL BUILDING CODE 7TH ED (2020) AND ALL AUTHORITIES HAVING JURISDICTION.

F. AIA DOCUMENT A-105 (2020) GENERAL CONDITIONS OF THE CONTRACT IS HEREBY MADE A PART OF THESE DRAWINGS AND SPECIFICATIONS.

G. THE CONTRACTOR SHALL DETERMINE THE SEQUENCE OF CONSTRUCTION ITEMS, AS WELL AS THOSE PROVIDED FOR BY SEPARATE PERMIT. THE CONTRACTOR SHALL ARRANGE FOR INSPECTION AND TESTS AS SPECIFIED OR REQUIRED BY THE BUILDING DEPARTMENT AND SHALL PAY ALL FEES AND COSTS FOR SAME. THE CONTRACTOR SHALL SECURE ALL BUILDING PERMITS AND UPON COMPLETION OF THE PROJECT (PRIOR TO FINAL PAYMENT) DELIVER TO THE OWNER A CERTIFICATE OF OCCUPANCY OR USE FROM THE BUILDING AND ZONING DEPARTMENT.

H. THE BID PRICES SHALL INCLUDE EVERYTHING NECESSARY OR PROPER FOR PERFORMING AND COMPLETING THE WORK REQUIRED AS INDICATED BY THE PLANS AND SPECIFICATIONS, TO PROVIDE FINISHED WORK. ANYTHING OMITTED THEREFROM WHICH IS CLEARLY NECESSARY FOR THE COMPLETION OF THE WORK OR ITS APPURTENANCE SHALL BE CONSIDERED A PORTION OF THE WORK ALTHOUGH NOT DIRECTLY SPECIFIED OR SHOWN ON THE DRAWINGS.

I. INSURANCE: WORKMEN'S COMPENSATION, AS REQUIRED BY LAW, AND PUBLIC LIABILITY SHALL BE CARRIED BY THE CONTRACTOR.

J. AFTER THE AWARD OF THE CONTRACT AND PRIOR TO START OF ANY WORK A PRE-WORK CONFERENCE WILL BE HELD BETWEEN THE CONTRACTOR, ARCHITECT, OWNER AND REPRESENTATIVES OF THE CONTRACTOR. THE TIME AND PLACE OF THIS CONFERENCE WILL BE SET BY THE OWNER. THE CONTRACTOR SHALL PREPARE A BRIEF WORK DESCRIPTION OF PROCEDURE TO BE USED IN THE PERFORMANCE OF THE WORK AND PROVIDE A SCHEDULE (BAR CHART) FOR THE PROJECT.

K. BEFORE CONSTRUCTION BEGINS, THE CONTRACTOR SHALL BE FAMILIAR WITH THE NATURE AND LOCATION OF THE WORK, THE GENERAL AND LOCAL CONDITIONS INCLUDING THOSE BEARING ON TRANSPORTATION, HANDLING AND STORAGE OF DEBRIS, ACCESS TO THE SITE, AND THE EQUIPMENT AND FACILITIES NEEDED TO PERFORM THE WORK.

L. SCOPE OF WORK: THE CONTRACTOR SHALL INCLUDE AND PROVIDE ALL LABOR, MATERIALS, EQUIPMENT, TRANSPORTATION AND PAY ALL EXPENSES INCURRED IN THE PROPER COMPLETION OF WORK UNLESS SPECIFICALLY NOTED TO BE THE WORK OF OTHERS. CONTRACTOR SHALL PERFORM ALL WORK NECESSARY FOR PRODUCING A COMPLETE, HABITABLE PROJECT, INCLUDING BUT NOT LIMITED TO ARCHITECTURAL, ELECTRICAL, PLUMBING AND HVAC.

M. THE CONTRACTOR SHALL PROVIDE AND MAINTAIN SAFE ACCESS TO THE PREMISES AT ALL TIMES.

N. ALL MATERIALS AND FINISHES SHALL BE AS SPECIFIED AND/OR AS SELECTED BY THE ARCHITECT, INTERIOR DESIGNER OR OWNER.

O. THE CONTRACTOR SHALL ALLOW THE A/E TEAM A RESPONSE TIME OF 7 WORKING DAYS FOR RFI'S AND 10 WORKING DAYS FOR SHOP-DRAWING REVIEWS.

P. GUARANTEE: THE CONTRACTOR SHALL UNCONDITIONALLY GUARANTEE ALL MATERIALS, AND WORKMANSHIP FURNISHED OR INSTALLED BY HIM OR HIS SUBCONTRACTORS FOR A PERIOD OF ONE (1) YEAR FROM DATE OF ACCEPTANCE AND SHALL REPLACE ANY DEFECTIVE WORK WITHIN THAT PERIOD WITHOUT EXPENSE TO THE OWNER AND PAY FOR ALL DAMAGES TO OTHER PARTS OF THE BUILDING RESULTING FROM DEFECTIVE WORK OR REPAIRS. THE CONTRACTOR SHALL REPLACE DEFECTIVE WORK WITHIN TEN (10) DAYS AFTER IT IS BROUGHT TO HIS

Q. AT COMPLETION, THE CONTRACTOR SHALL REMOVE FROM THE PREMISES ALL RUBBISH, IMPLEMENTS, EQUIPMENT, AND SURPLUS MATERIALS, LEAVING THE PROJECT "BROOM CLEAN".

R. THE CONTRACTOR IS TO PROVIDE TO THE OWNER A LIST OF ALL SUBCONTRACTORS USED, COMPLETE WITH

ADDRESSES, PHONE NUMBERS AND COPIES OF ALL WARRANTIES.

S. THESE DOCUMENTS DO NOT INCLUDE THE NECESSARY COMPONENTS FOR CONSTRUCTION SAFETY. SAFETY, CARE OF ADJACENT PROPERTIES DURING CONSTRUCTION, COMPLIANCE WITH STATE AND FEDERAL REGULATIONS REGARDING SAFETY AND COMPLIANCE WITH REQUIREMENTS SPECIFIED IN THE OWNER/CONTRACTOR CONTRACT IS, AND SHALL BE, THE CONTRACTOR'S RESPONSIBILITY.

T. DO NOT SCALE DRAWINGS. USE WRITTEN DIMENSIONS FOR ALL MEASUREMENTS. ALL DIMENSIONS ARE TO FACE OF STUD UNLESS OTHERWISE NOTED.

U. PROTECTION: THE CONTRACTOR SHALL BE RESPONSIBLE FOR HIS WORK AND THAT OF HIS SUBCONTRACTORS FOR LOSSES AND DAMAGES TO EQUIPMENT, TOOLS AND MATERIALS USED IN CONJUNCTION WITH THE WORK AND FOR ACTS OF HIS EMPLOYEES.

V. THE CONTRACTOR SHALL NOTIFY THE ARCHITECT IN WRITING AT LEAST ONE WEEK PRIOR TO FINAL INSPECTION. THE CONTRACTOR IS TO PROVIDE THE OWNER WITH PARTIAL RELEASE OF LIEN FOR EACH PAYMENT, AND A FINAL RELEASE OF LIEN AT COMPLETION.

W. FINAL DISBURSEMENT TO THE CONTRACTOR SHALL NOT BE MADE UNTIL THE OWNER'S PUNCH-LIST HAS BEEN

#### SYMBOLS KEY

	· <b>L</b> I		
BUILDING SECTION	A A-01	ELEVATION	ELEV. = +0'-0" FINISH FLOOR
WALL SECTION		INTERIOR ELEVATION	4 A-01 2
	(A-01)	DOOR ID	<u>(01)</u>
DETAIL	A-01	PARTITION TYPE	<del>-</del> 1
		REVISION	$\triangle$
DETAIL @ SECTION	A-01	EQUIPMENT ID	101
NOTES		GLAZING ID	(A)

1. ALL RAINWATER MUST BE RETAINED ON PROPERTY.

2. LANDSCAPING WILL COMPLY WITH THE CITY OF CORAL GABLES LANDSCAPE REQUIREMENT ORD. 98-13 CHAPTER 18A. LANDSCAPING NOT ALLOWED TO GROW WITHIN TRIANGLE OF VISIBILITY BETWEEN A HEIGHT OF

3. NEW 6 INCHES REINFORCED CORAL GABLES BEIGE CONCRETE SIDEWALK REPLACEMENT AT NEW APPROACH


#### 4. FILL SHALL NOT BE BROUGHT UNTO SITE.


5. SOIL TERMITE CONTROL: THE ENTIRE SOIL AREA TO BE COVERED BY FOOTINGS, SLABS, PORCHES, ETC...SHALL BE TREATED WITH FUMISEAL OR EQUAL FOR TERMITES IN ACCORDANCE WITH SPECIFICATIONS. PROVIDE OWNER WITH A PRINTED GUARANTEE AGAINST SUBTERRANEAN TERMITES FOR 5 YEARS, AND OTHER TERMITES FOR 2 YEARS, FROM DATE OF COMPLETION.

6. THE TRIANGLE OF VISIBILITY SHALL BE KEPT CLEAR OF VISUAL OBSTRUCTIONS BETWEEN A HEIGHT OF TWO AND A HALF (2 1/2) FEET AND EIGHT (8) FEET ABOVE THE ESTABLISHED GRADE

#### CODE:

FBC RESIDENTIAL 2020 7TH EDITION

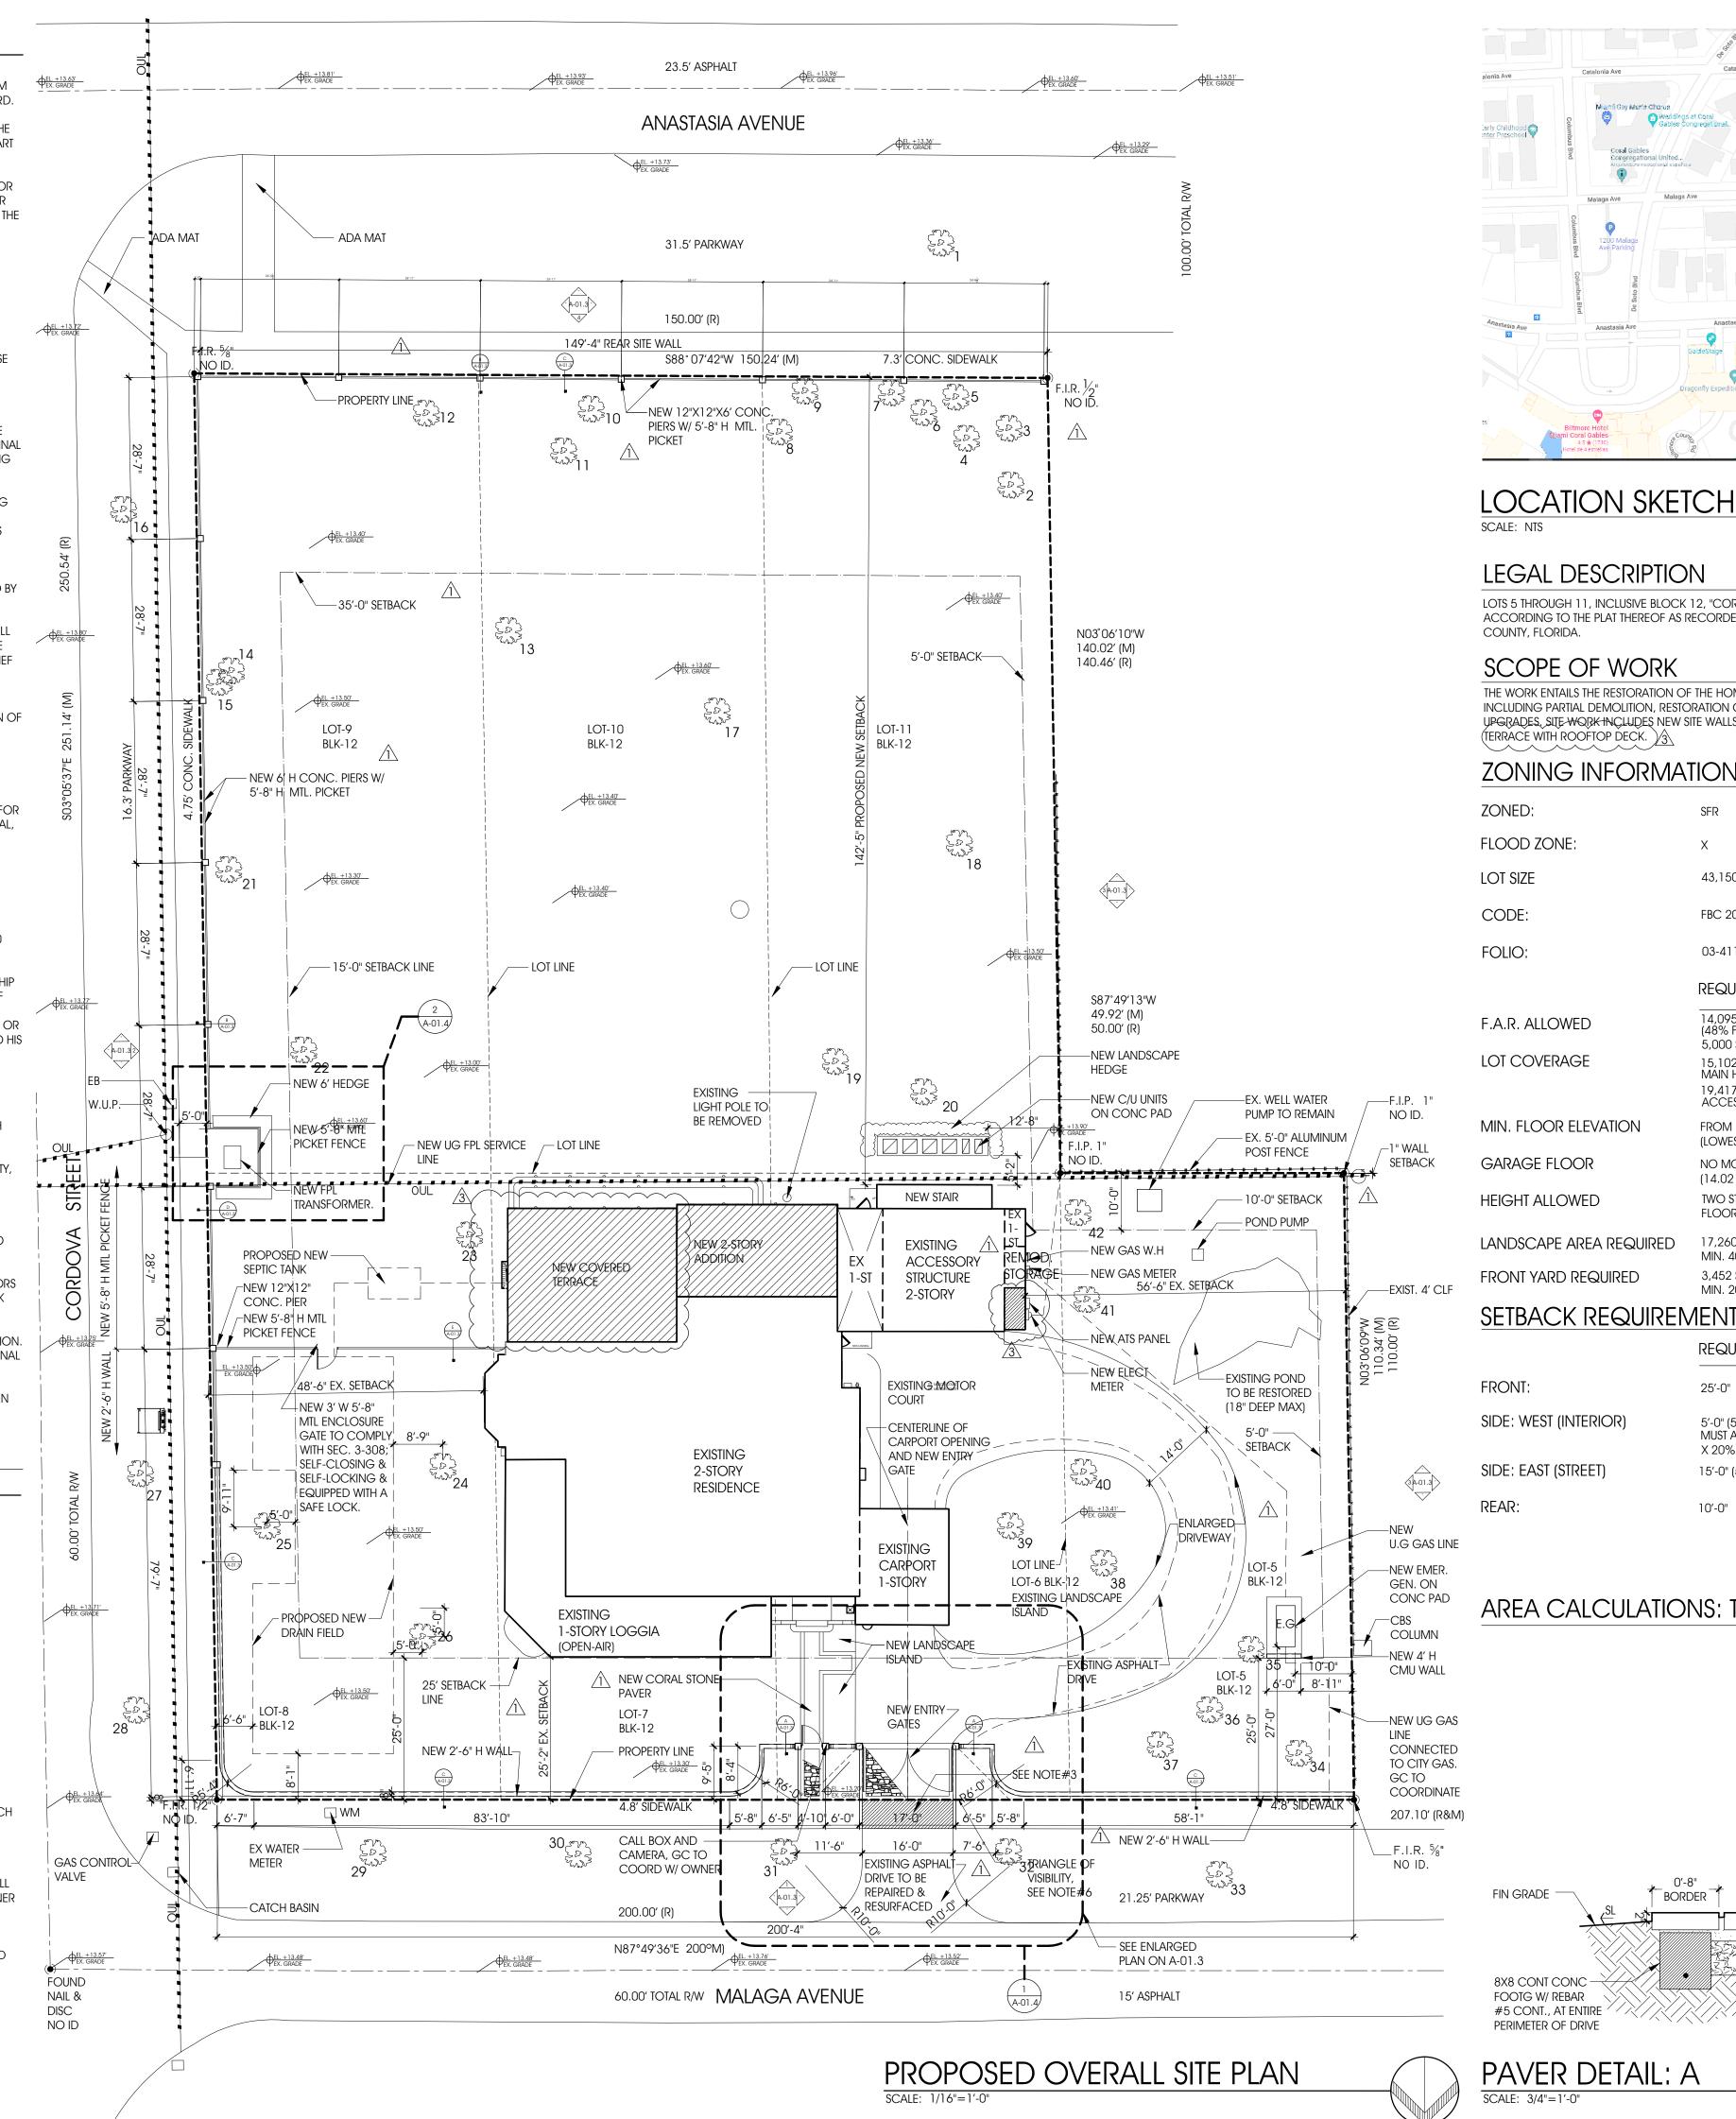

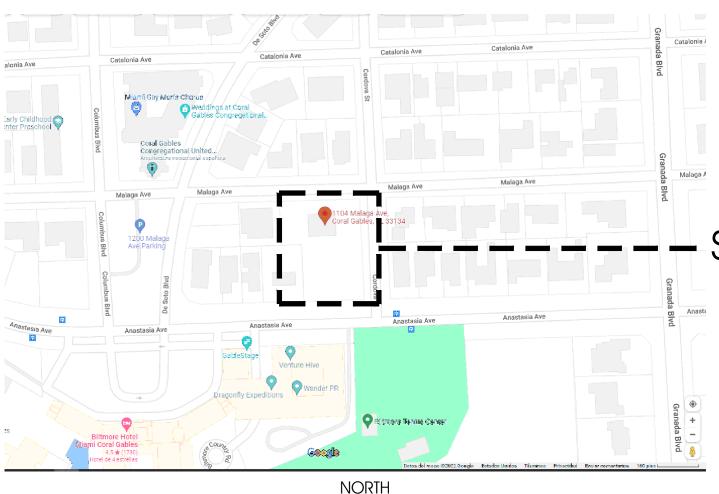

LOTS 5 THROUGH 11, INCLUSIVE BLOCK 12, "CORAL GABLES COUNTRY CLUB SECTION, PART ONE, A SUBDIVISION", ACCORDING TO THE PLAT THEREOF AS RECORDED IN PLAT BOOK 8, PAGE 108, OF THE PUBLIC RECORDS OF MIAMI-DADE

#### SCOPE OF WORK

THE WORK ENTAILS THE RESTORATION OF THE HOME TO IT'S ORIGINAL CONDITION (AS FEASIBLY POSSIBLE), INTERIOR REMODELING, INCLUDING PARTIAL DEMOLITION, RESTORATION OF ORIGINAL HISTORICAL ELEMENTS, NEW 2-STORY ADDITION AT REAR AND MEP UPGRADES, SITE WORK-INCLUDES NEW SITE WALLS, GATES, LANDSCAPE UPGRADES AND NEW SCREEN ENCLOSED COVERED (TERRACE WITH ROOFTOP DECK. )3

#### ZONING INFORMATION

ZONED:	SFR
FLOOD ZONE:	X
LOT SIZE	43,150 SF

CODE: FBC 2020, RESIDENTIAL 7TH EDITION

03-4118-003-1700


	REQUIRED/ALLOWED	EXISTING/PROPOSED
F.A.R. ALLOWED	14,095 SF (48% FIRST 5,000 SF, 35% NEXT 5,000 SF, 30% REMAINING)	7,237 SF (PROPOSED)
LOT COVERAGE	15,102 SF MAIN HOUSE: MAX. 35% LOT 19,417 SF ACCESS STRUCTURES: MAX. 45% LOT	5,831 SF (PROPOSED)  5,831 SF (PROPOSED)
MIN. FLOOR ELEVATION	FROM 16" MIN / 30" MAX ABOVE EST. GRADE (LOWEST ADJACENT GRADE 13.50 NGVD)	NEW PROPOSED = $+1'-6"$ (+15.93' NGVD) TO MATCH EXISTING
GARAGE FLOOR	NO MORE THAN 6" ABOVE GRADE (14.02 NGVD EXISTING)	(14.02 NGVD EXISTING)

TWO STORIES OR 25'-0" MAX. FROM FINISHED NEW PROPOSED=23'-6" FLOOR TO TOP OF TIE BEAM ON TOP FLOOR TO MATCH EXISTING 34,437 SF (PROPOSED) LANDSCAPE AREA REQUIRED 17,260 SF MIN. 40% LOT FRONT YARD REQUIRED 10,889 SF MIN. 20% OF 40% AT FRONT YARD

#### SETBACK REQUIREMENTS

	REQUIRED/ALLOWED	EXISTING/PROPOSED
FRONT:	25′-0"	25'-2" (EXISTING)
SIDE: WEST (INTERIOR)	5'-0" (5'-0" MIN) MUST ADD UP 20% OF LOT=200'-0" X 20%=(20' MAX TOTAL)	56'-6" (EXISTING)
SIDE: EAST (STREET)	15'-0" (5'-0" MIN)	48'-6" (EXISTING)
REAR:	10'-0"	142'-5" (EXISTING)

#### AREA CALCULATIONS: TOTALS: SEE SHEET A-01.1

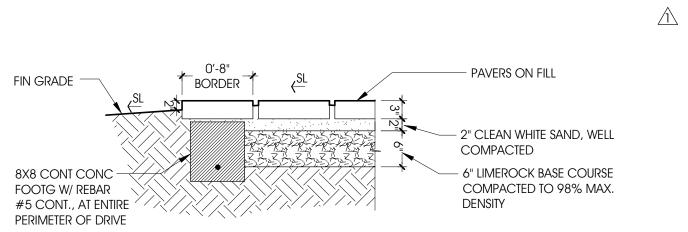

PAVER DETAIL: A

#### LOCUS ARCHITECTURE

INCORPORATED 500 South Dixie Highway, Suite 307 Coral Gables, Florida 33146 Tel (305) 740-0120 Email: locus@locusarchitecture.net

HISTORIC DEPARTMENT

. WINDOW/DOOR MUNTINS ARE TO BE

3. HOUSE IS NOT TO BE RESTUCCOED IN ITS

4. EXISTING WINDOW SILLS ARE TO REMAIN.

5. WORK WITH STAFF ON ALL DECORATIVE DETAILS

TO BE RESTORED (E.G. THE WOODEN SPINDLES,

IRON WORK, LIGHT FIXTURES, ETC.) PRIOR TO

FABRICATION . DETAILED DRAWINGS/SHOP

HIGH-PROFILE / DIMENSIONAL.

2. WINDOW/DOOR GLASS TO BE CLEAR/NON-REFLECTIVE/NON-TINT.

DRAWINGS ARE TO BE SUBMITTED.

CONSULTANT(S)

NO. REVISION/SUBMISSION DATE 01-13-25 REVIEW COA HISTORICAL SUBM 02-06-23 PERMIT SUBMITTAL 10-28-23 **BOA SUBMITTAL** 02-08-24 COA SUBMITTAL 04-17-24

COA & CITY COMMENTS | 04-22-24 OWNER REVISION CITY COMMENTS 07-08-24 **BOA RESUBMITTAL** 10-16-24 **BOA RESUBMITTAL** 12-14-24 OWNER REVISIONS 01-27-25

Historical: Remodel & Additions Soane Residence

1104 Malaga Avenue Coral Gables, FL 33134

DRAWING

PROJECT

Proposed Site Plan and Zoning Information



Nelson de Leon AR 13937

DRAWN


REVIEWED


PROJ. NO.


NDL

SHEET NO.

A-01.0

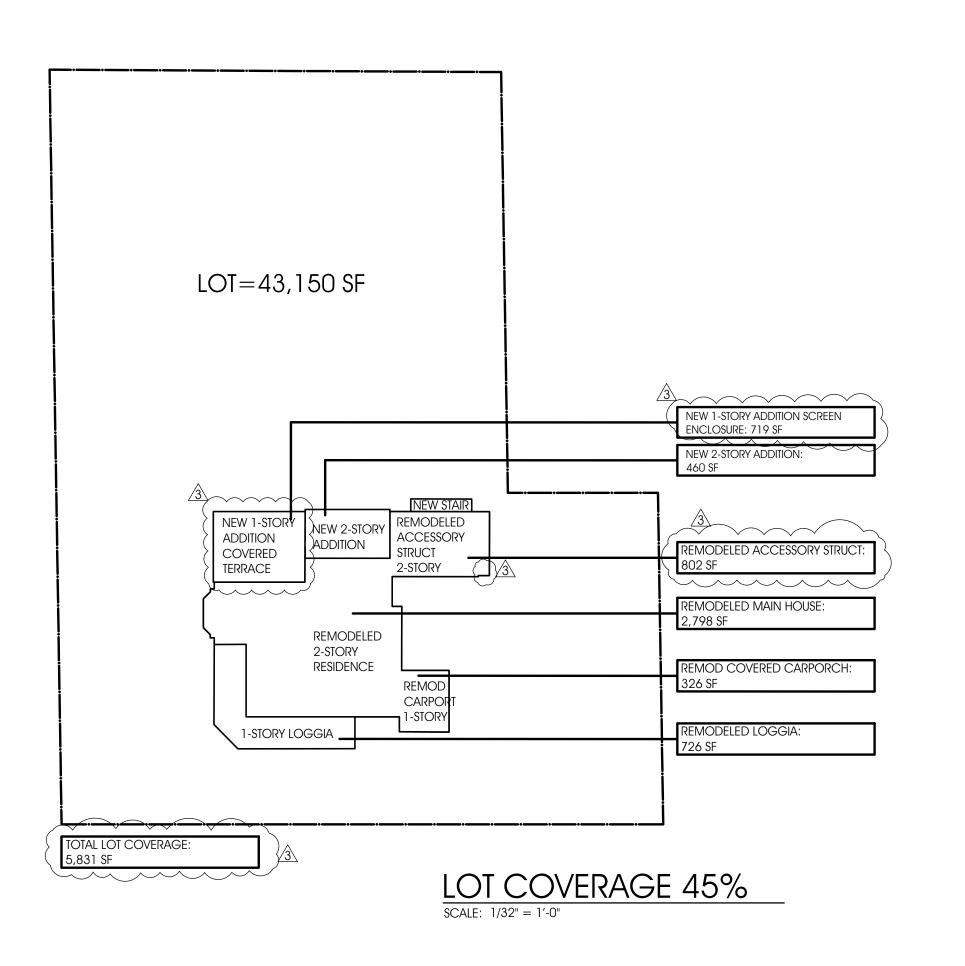

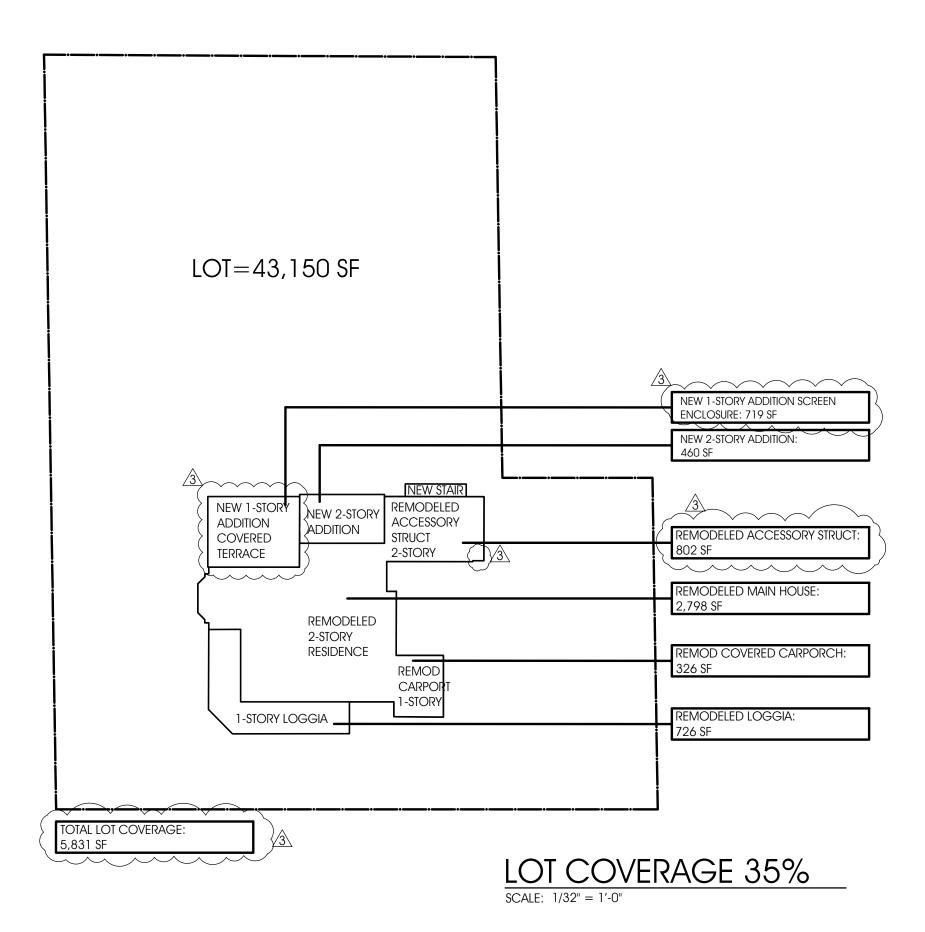

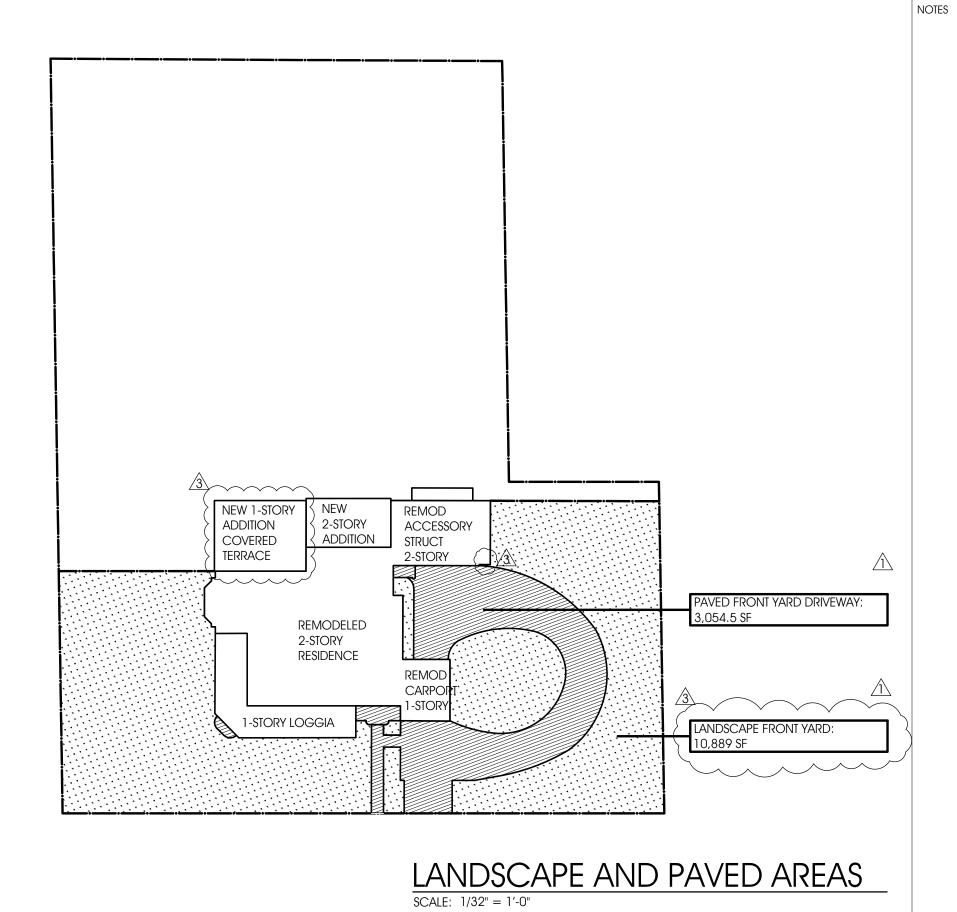

AREA CALCULATIONS: TOTALS

LOT = 43,150 SF


FAR CALCULATIONS ALLOWED: 14,095 S	SF		
	1ST FLOOR	2ND FLOOR	PROPOSED
MAIN HOUSE	3,094 SF	3,079 SF	6,173 SF
GARAGE ACC. STR.	657 SF 3	407 SF	1,064 SF 3
TOTALS			7,237 SF


LOT COVERAGE CALCS: 35% ALLOWED: 15,102 SF	PROPOSED
REMODELED LOGGIA	726 SF
REMODELED CARPORT	326 SF
REMODELED MAIN HOUSE	2,798 SF
REMODELED GARAGE ACCESSORY STRUCTURE	802 SF 3
NEW 2-STORY ADDITION	460 SF
NEW 1-STORY ADDITION SCREEN ENCLOSURE	719 SF 3
TOTALS	( 5,831 SF )

LOT COVERAGE CALCS: 45% ALLOWED: 19,417 SF	PROPOSED
REMODELED LOGGIA	726 SF
REMODELED CARPORT	326 SF
REMODELED MAIN HOUSE	2,798 SF
REMODELED GARAGE ACCESSORY STRUCTURE	802 SF 3
NEW 2-STORY ADDITION	460 SF
NEW 1-STORY ADDITION SCREEN ENCLOSURE	719 SF 3
TOTALS	5,831 SF

LANDSCAPE AREAS REQUIRED: MIN. 17,260 SF	PROPOSED
LANDSCAPE: BACKYARD	23,548 SF
LANDSCAPE: FRONT YARD REQUIRED: 3,452 SF	10,889 SF 3
TOTALS	(34,437 SF)

PAVED AREAS	PROPOSED
FRONT YARD: DRIVEWAY	2,567 SF
BACK YARD: ELEVATED OPEN TERRACE	568 SF
TOTALS	3,135 SF

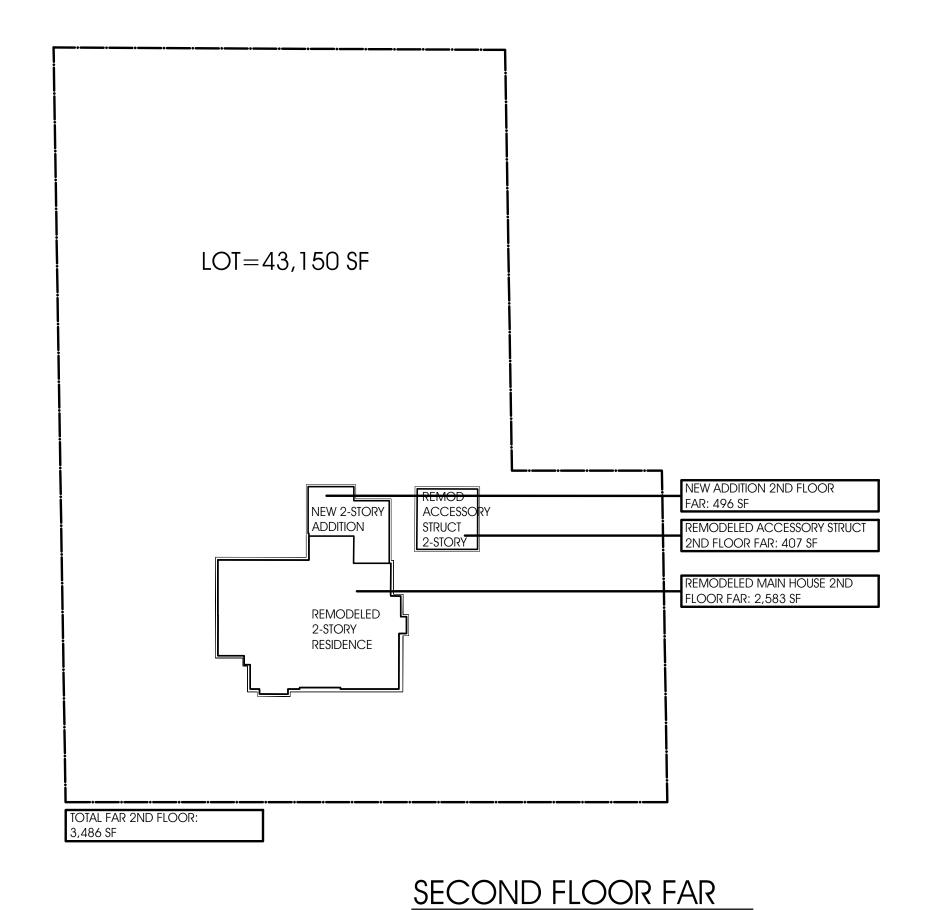

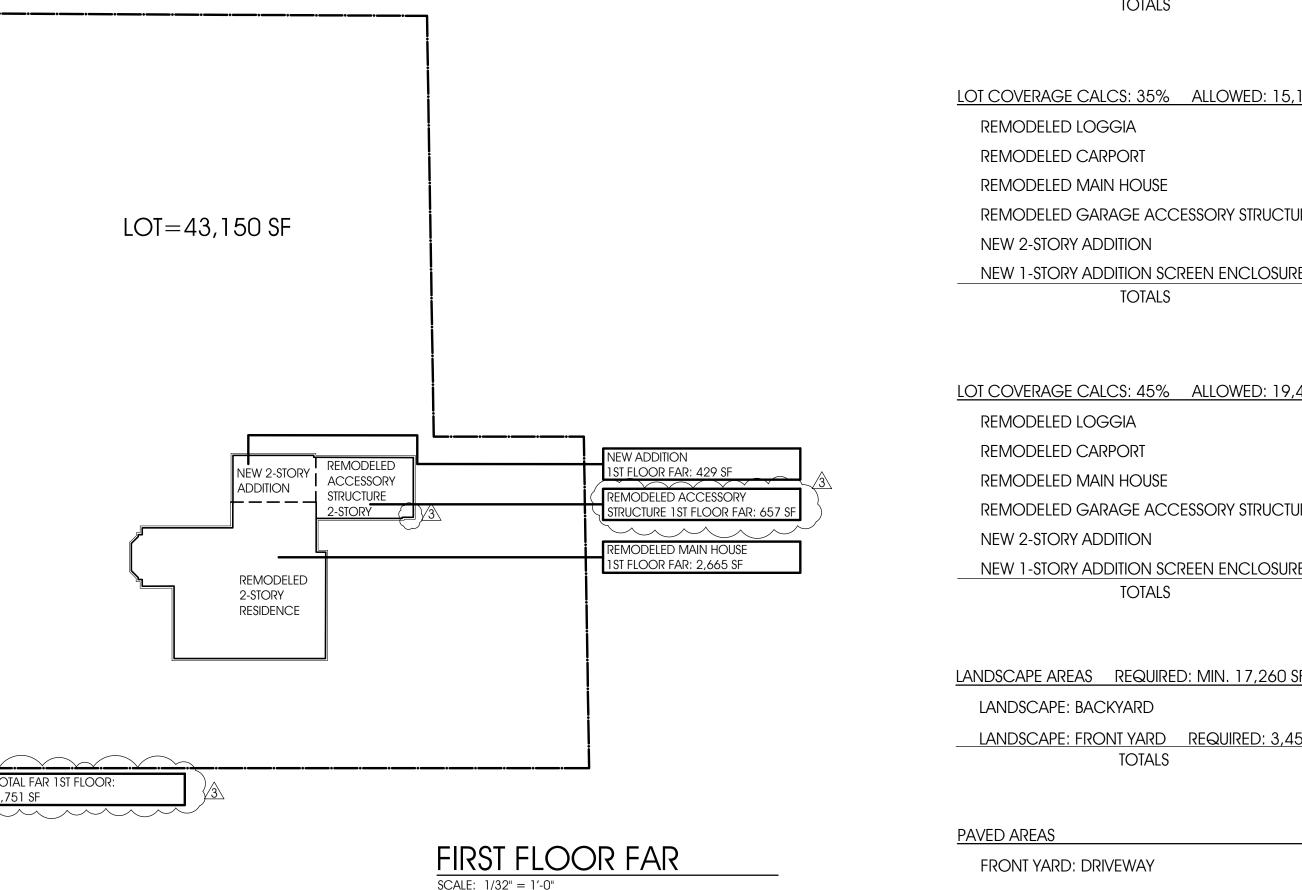


NO. REVISION/SUBMISSION DATE 01-13-25 REVIEW COA HISTORICAL SUBM 02-06-23 PERMIT SUBMITTAL 10-28-23 BOA SUBMITTAL 02-08-24 04-17-24 COA SUBMITTAL COA & CITY COMMENTS 04-22-24 OWNER REVISION BOA RESUBMITTAL 10-16-24 BOA RESUBMITTAL 12-14-24 OWNER REVISIONS 01-27-25 PROJECT Historical: Remodel & Additions Soane Residence 1104 Malaga Avenue Coral Gables, FL 33134 DRAWING Area Diagrams and Calculations DRAWN REVIEWED NDL PROJ. NO. Nelson de Leon 326.02 AR 13937 SHEET NO. A-01.1

LOCUS

INCORPORATED

CONSULTANT(S)

500 South Dixie Highway, Suite 307 Coral Gables, Florida 33146 Tel (305) 740-0120 Email: locus@locusarchitecture.net

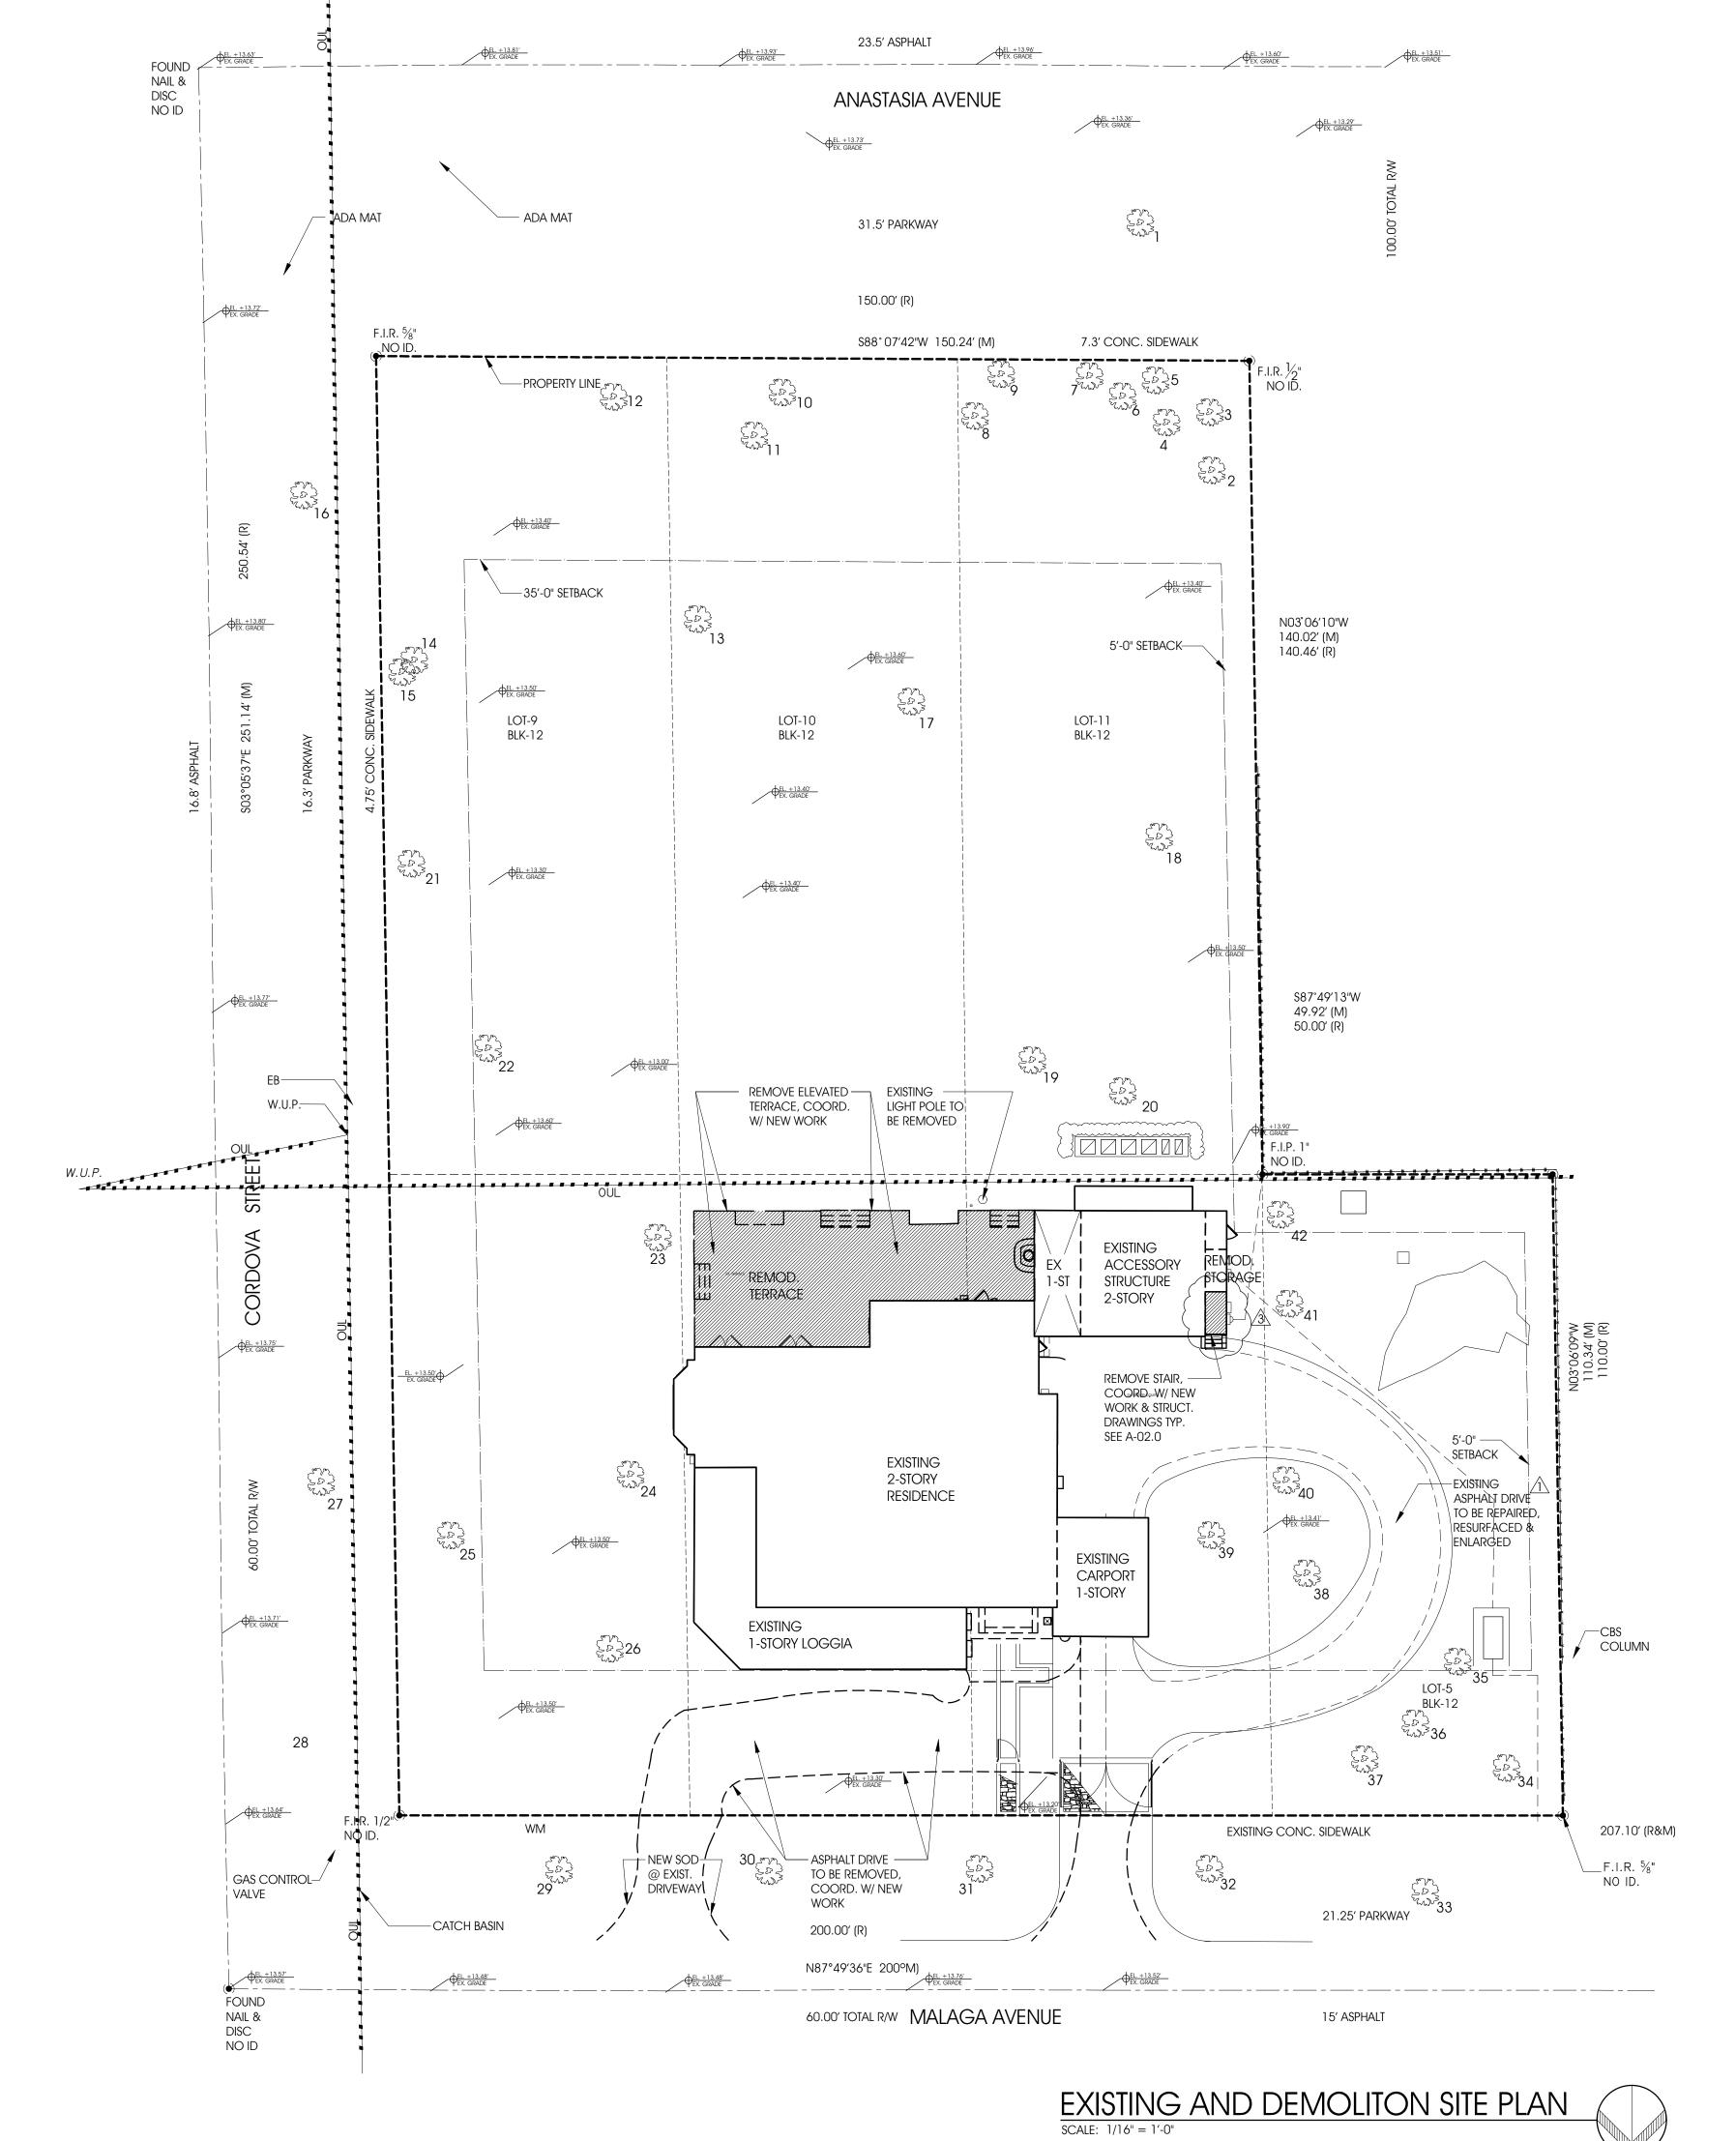



500 South Dixie Highway, Suite 307 Coral Gables, Florida 33146 Tel (305) 740-0120 Email: locus@locusarchitecture.net

CONSULTANT(S)

NO.	REVISION/SUBMISSION	DATE
	REVIEW	01-13-25
	COA HISTORICAL SUBM (MASTER PLAN)	02-06-23
	PERMIT SUBMITTAL	10-28-23
	BOA SUBMITTAL	02-08-24
	COA SUBMITTAL	04-17-24
$\triangle$	COA & CITY COMMENTS OWNER REVISION	04-22-24
<u> </u>	OWNER REVISIONS	10-15-24
	BOA RESUBMITTAL	10-16-24

PROJECT

Historical: Remodel & Additions Soane Residence

1104 Malaga Avenue Coral Gables, FL 33134

DRAWING

Existing and Demolition Site Plan



DRAWN

REVIEWED


PROJ. NO.


326.02


NDL

Nelson de Leon AR 13937 SHEET NO.

A-01.2

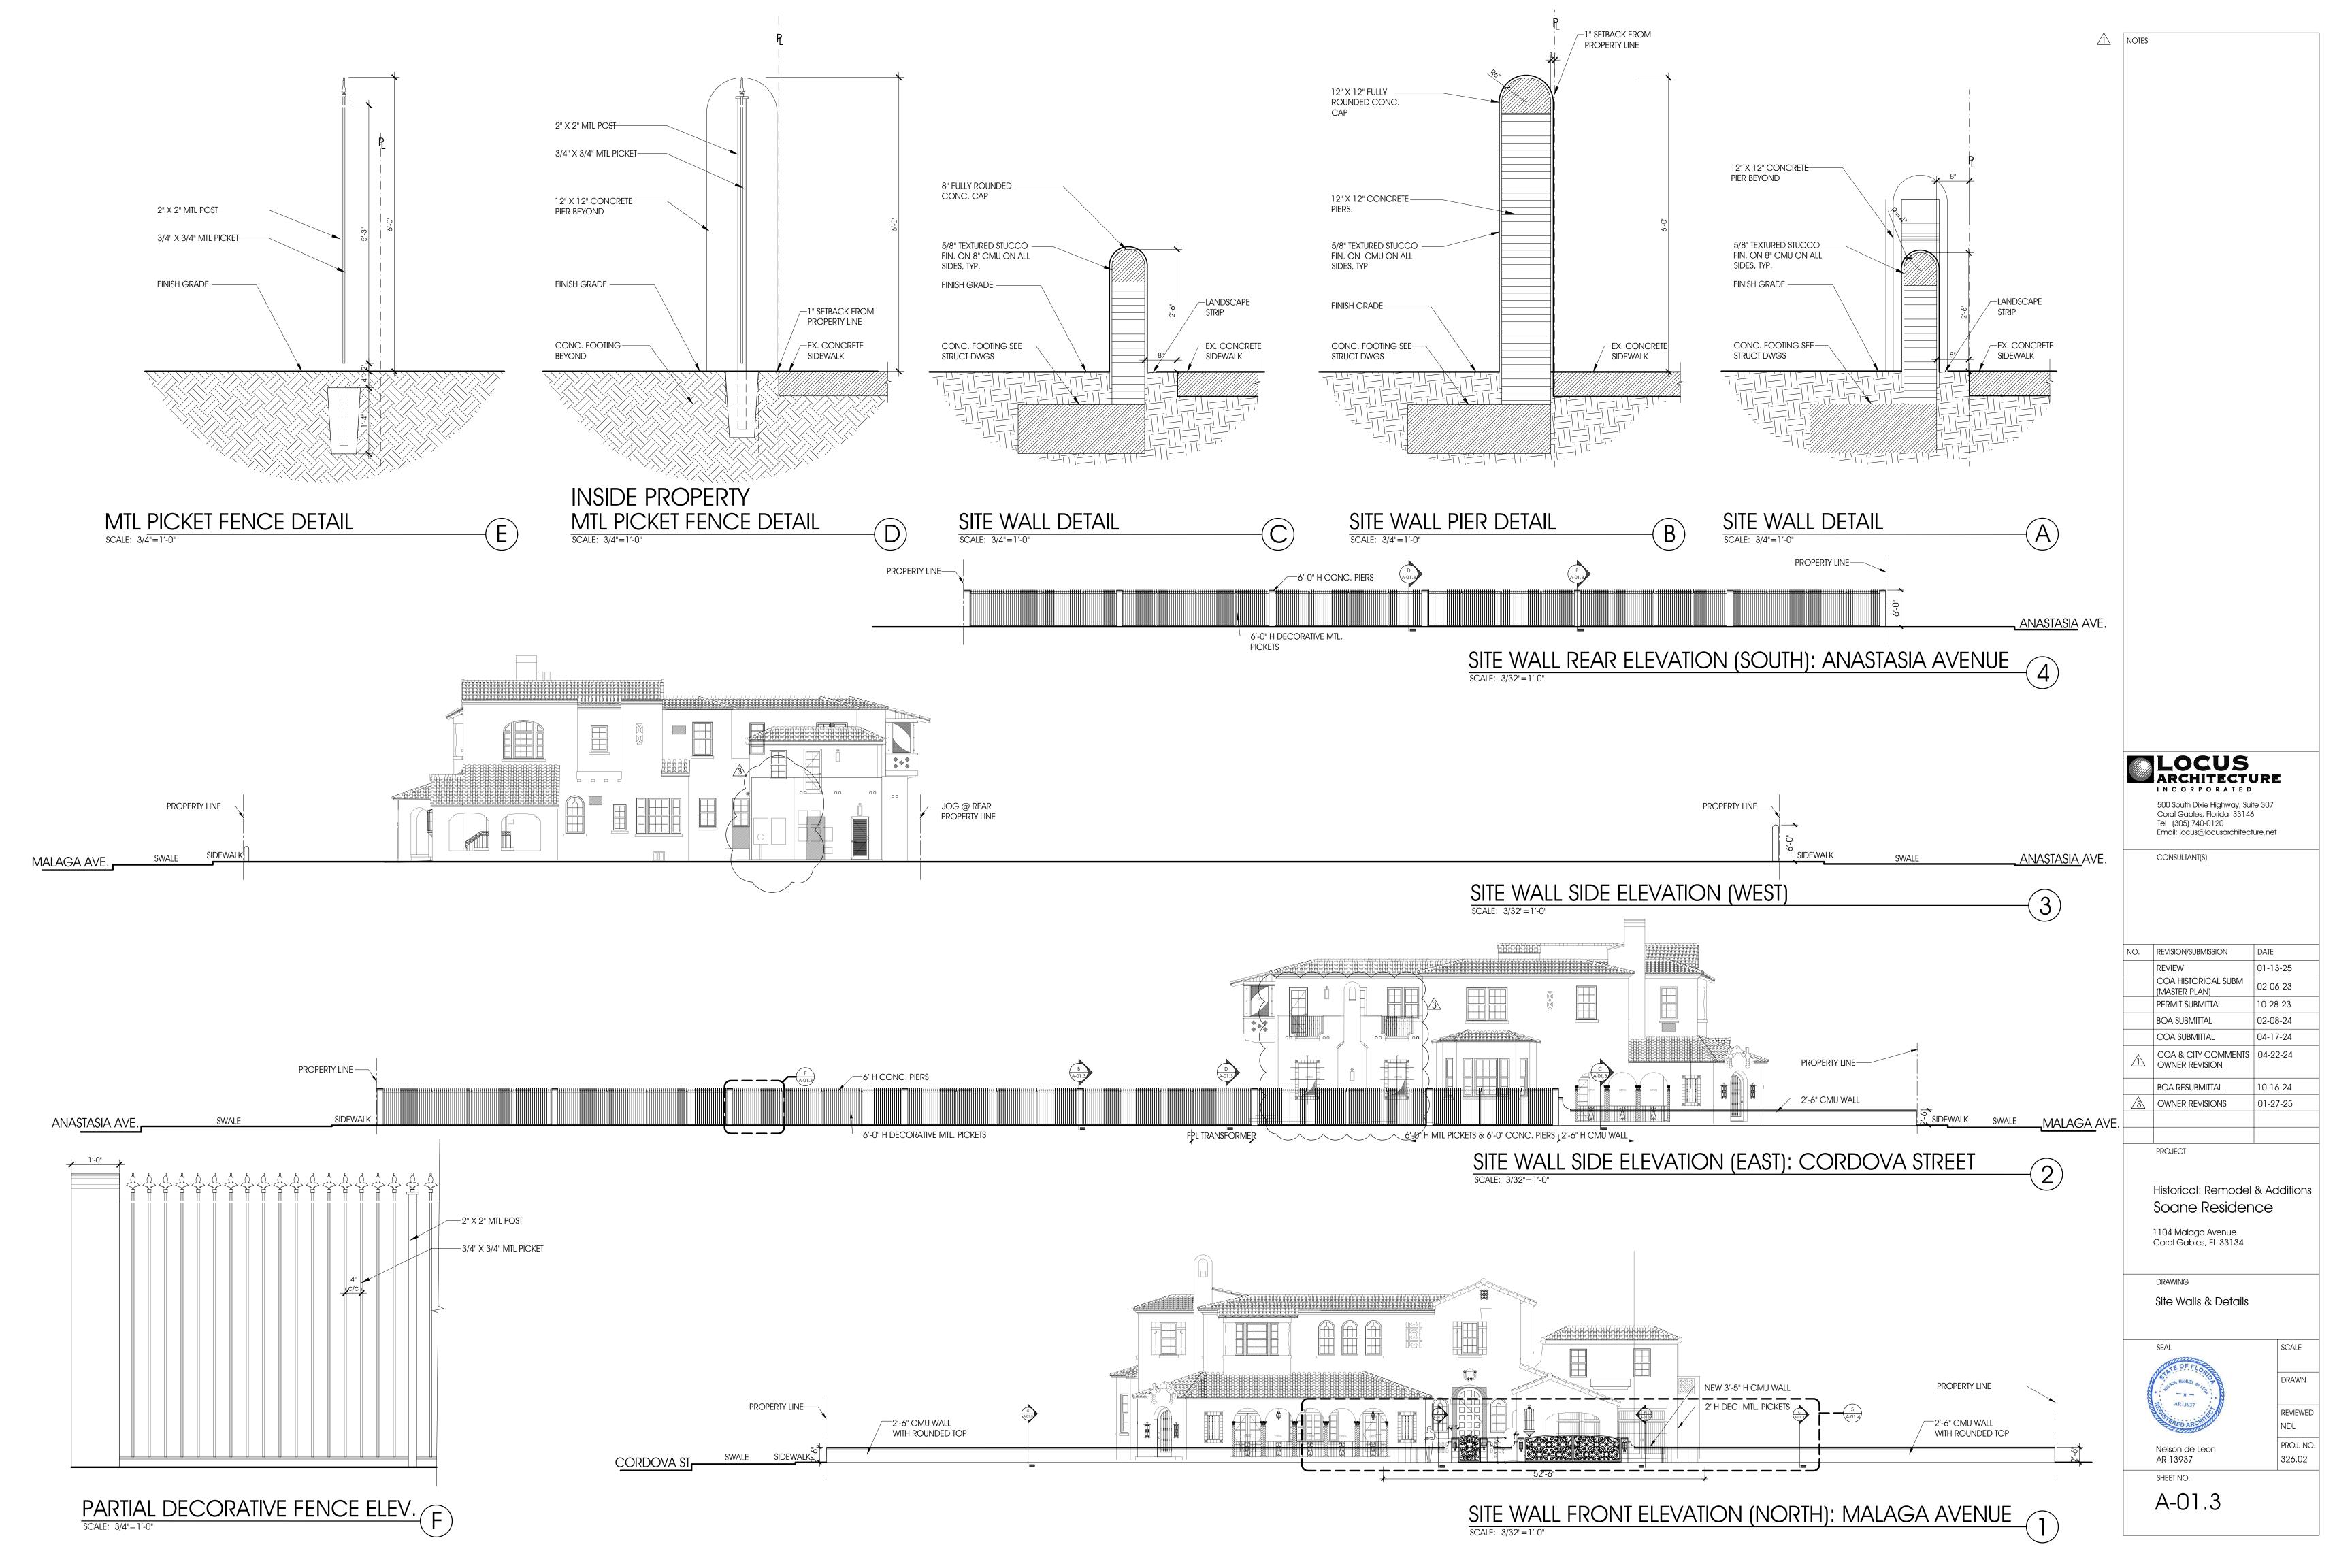

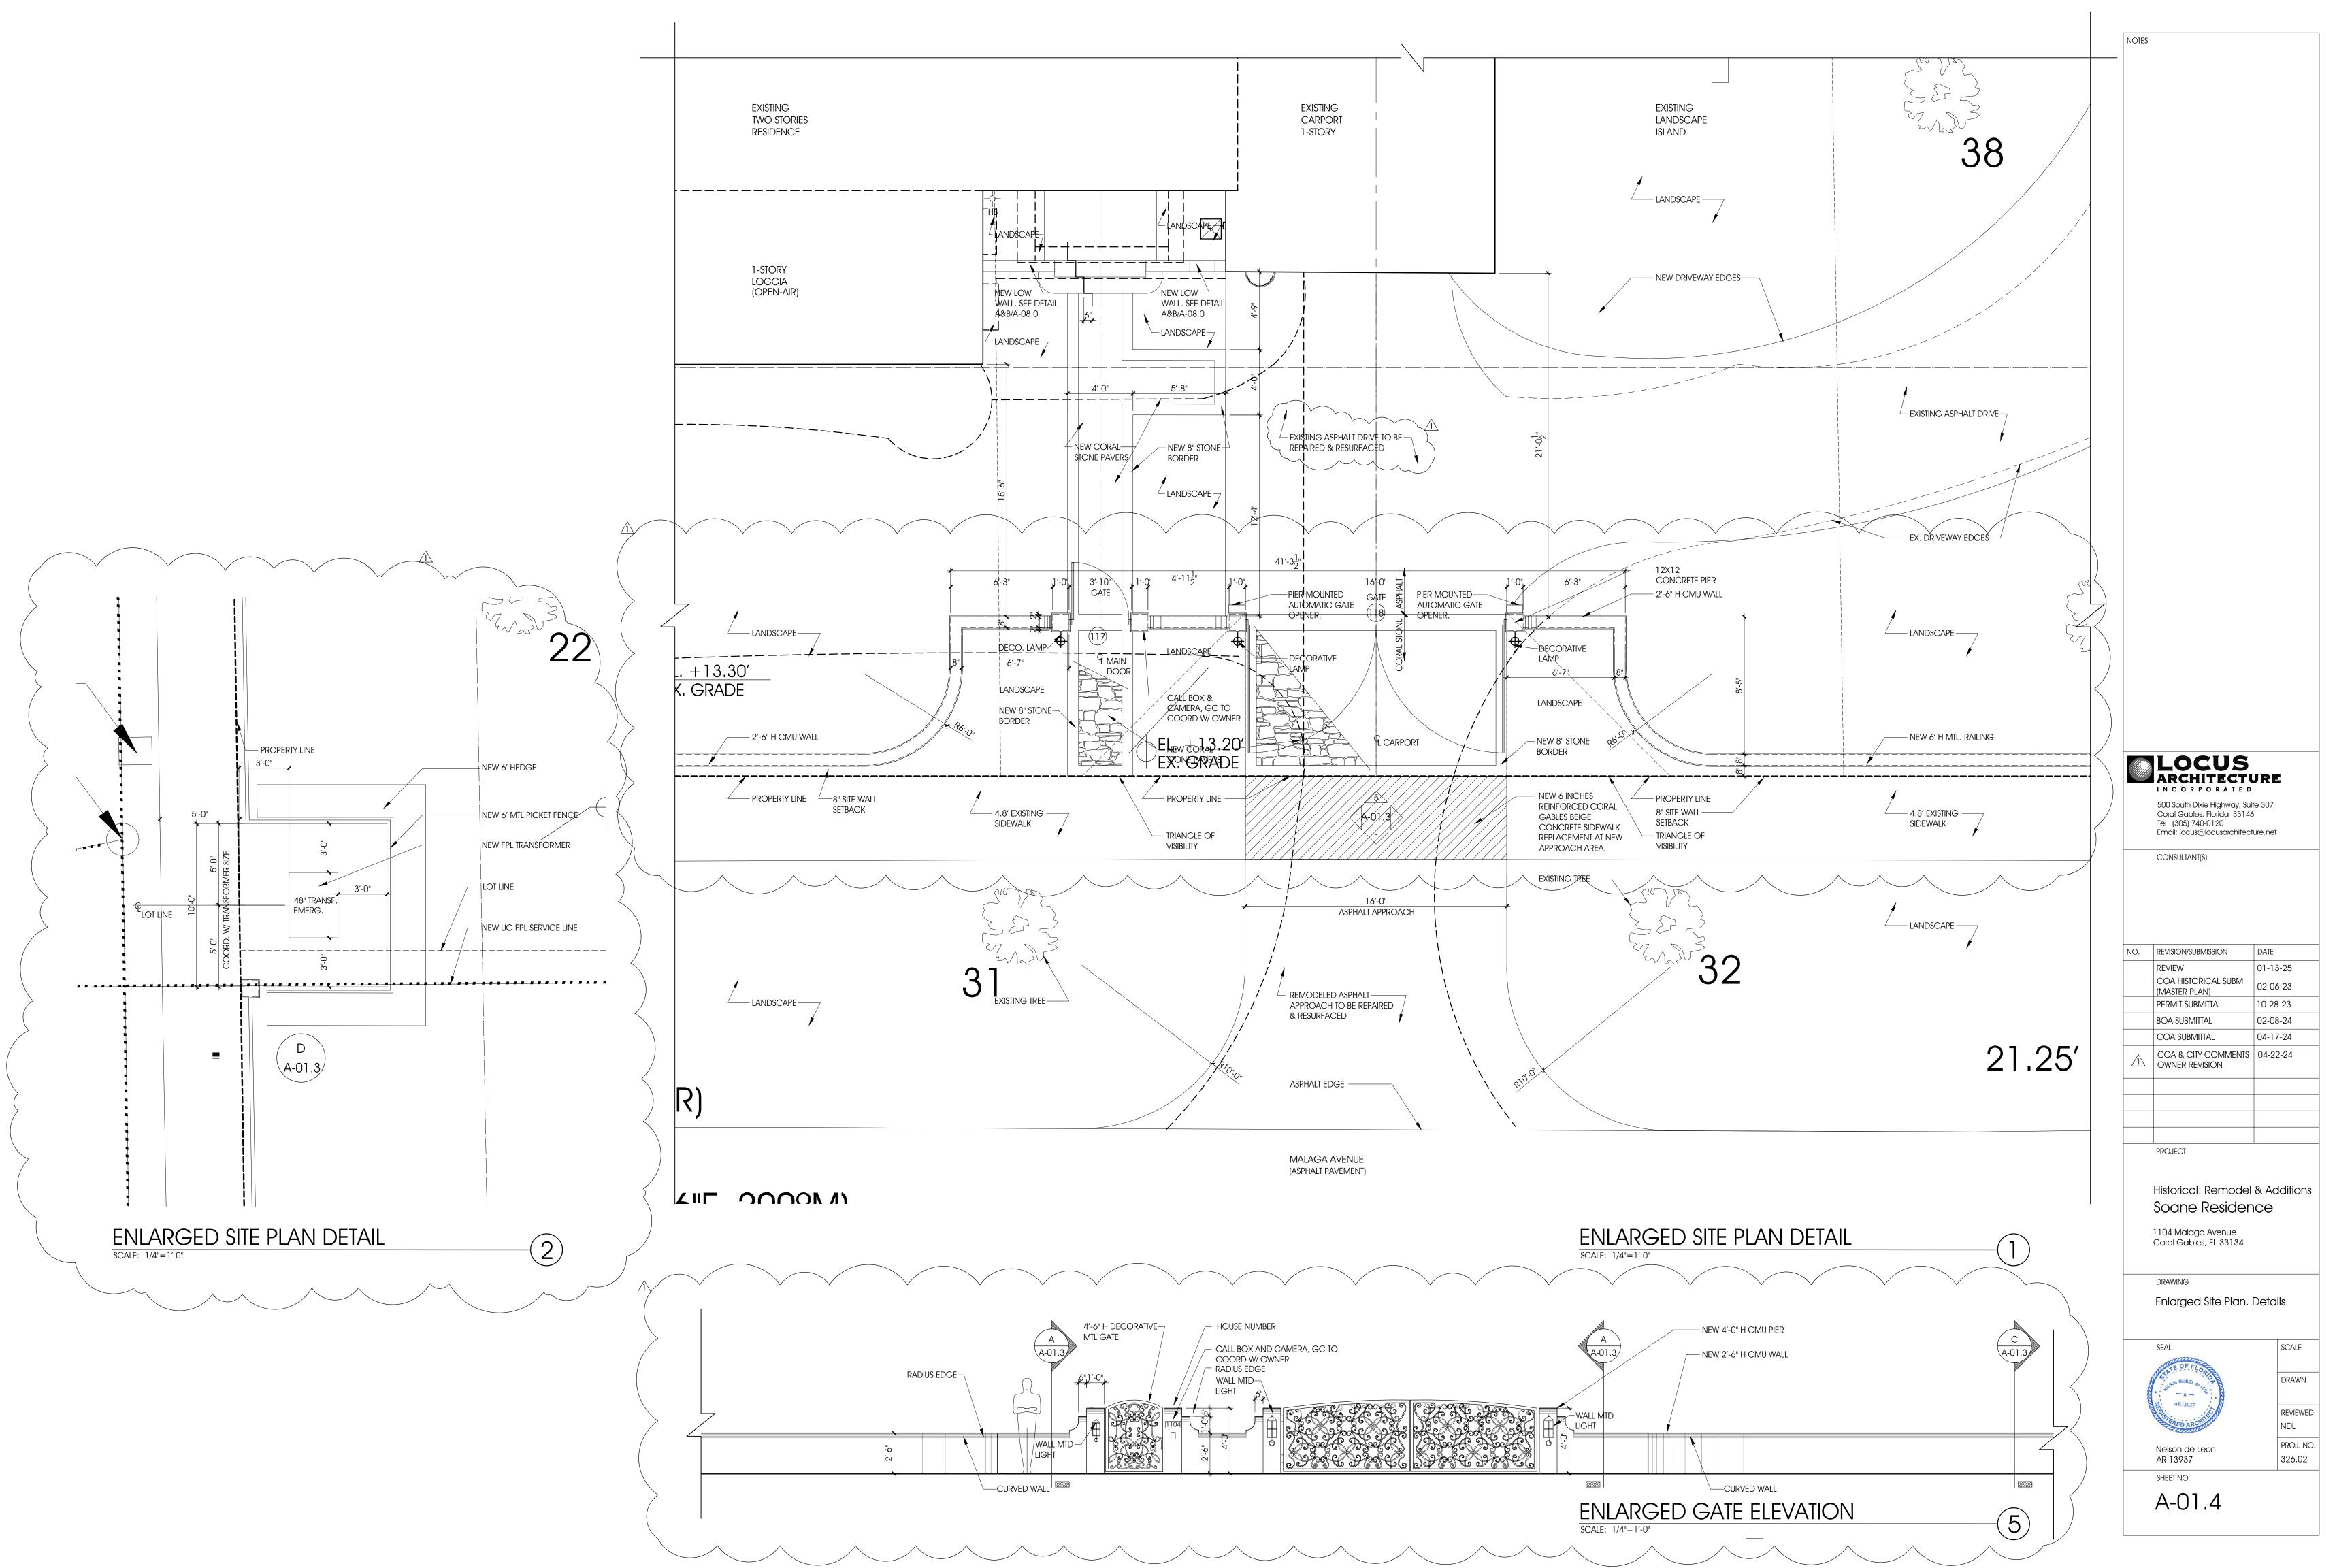

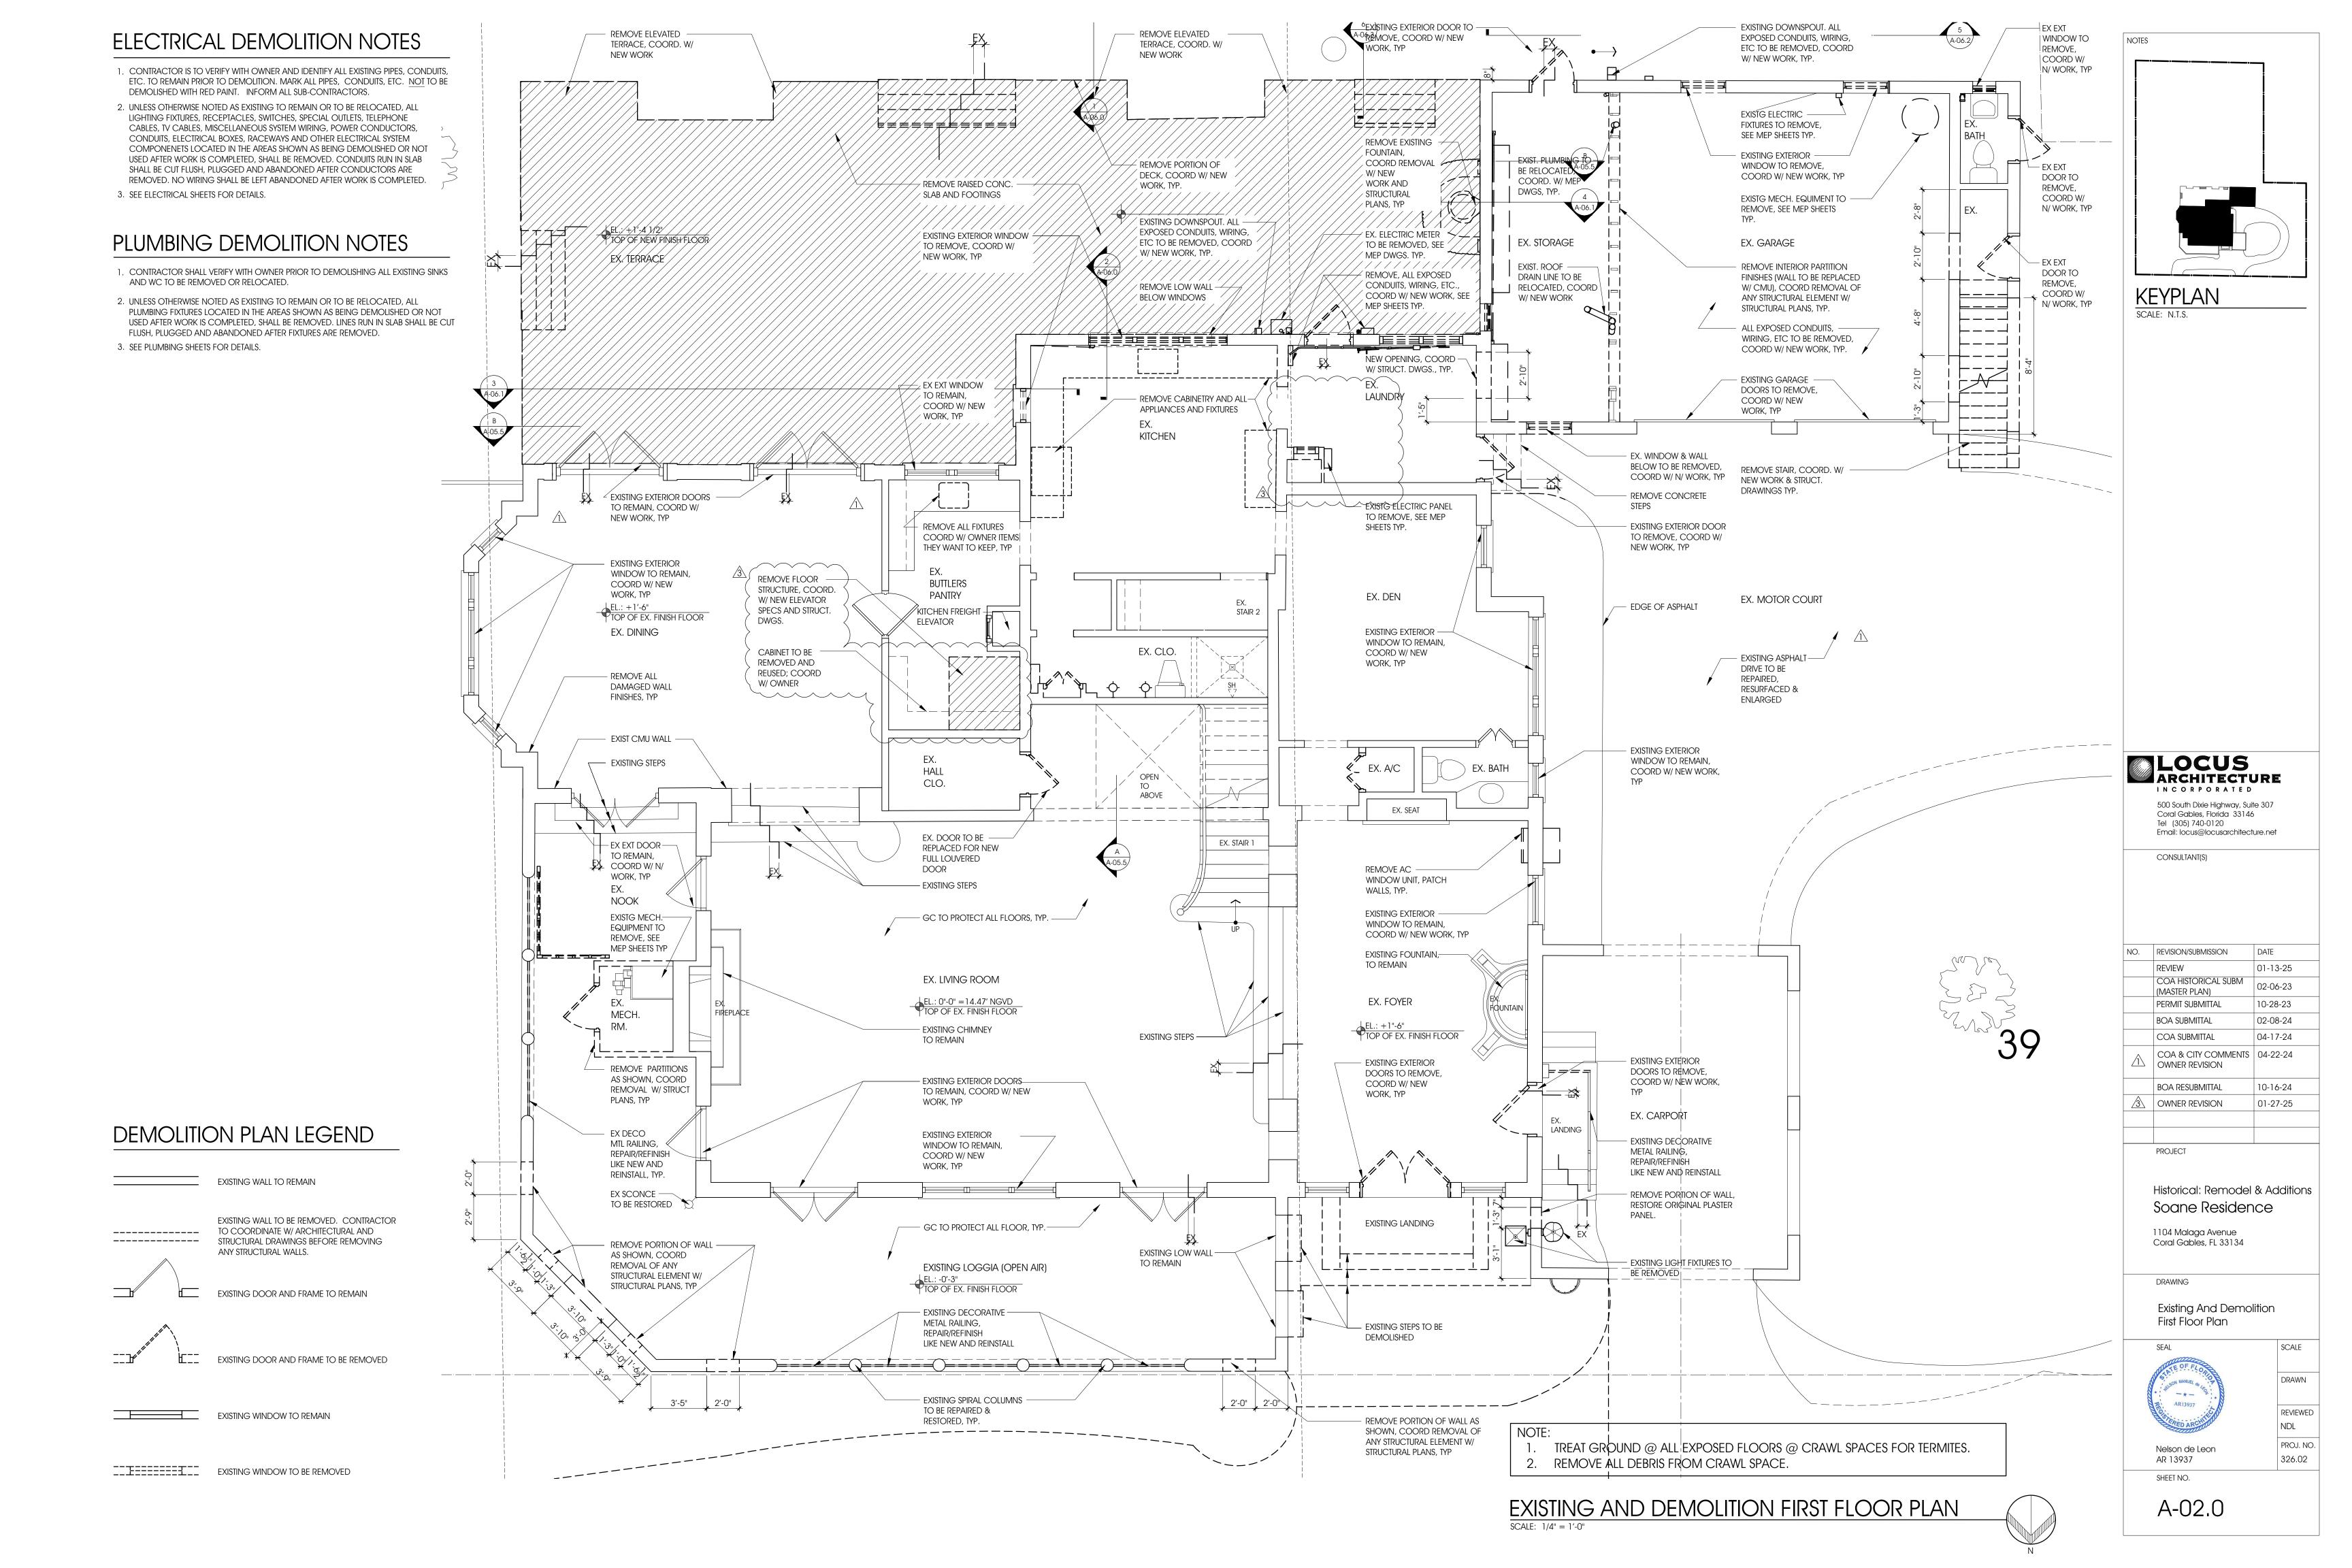

#### ELECTRICAL DEMOLITION NOTES

- 1. CONTRACTOR IS TO VERIFY WITH OWNER AND IDENTIFY ALL EXISTING PIPES, CONDUITS, ETC. TO REMAIN PRIOR TO DEMOLITION. MARK ALL PIPES, CONDUITS, ETC.  $\underline{\text{NOT}}$  TO BE DEMOLISHED WITH RED PAINT. INFORM ALL SUB-CONTRACTORS.
- 2. UNLESS OTHERWISE NOTED AS EXISTING TO REMAIN OR TO BE RELOCATED, ALL LIGHTING FIXTURES, RECEPTACLES, SWITCHES, SPECIAL OUTLETS, TELEPHONE CABLES, TV CABLES, MISCELLANEOUS SYSTEM WIRING, POWER CONDUCTORS, CONDUITS, ELECTRICAL BOXES, RACEWAYS AND OTHER ELECTRICAL SYSTEM COMPONENETS LOCATED IN THE AREAS SHOWN AS BEING DEMOLISHED OR NOT USED AFTER WORK IS COMPLETED, SHALL BE REMOVED. CONDUCTORS ARE REMOVED. NO WIRING SHALL BE LEFT ABANDONED AFTER WORK IS COMPLETED.
- 3. SEE ELECTRICAL SHEETS FOR DETAILS.

#### PLUMBING DEMOLITION NOTES

DEMOLITION PLAN LEGEND

TO COORDINATE W/ ARCHITECTURAL AND

EXISTING WINDOW TO REMAIN

EXISTING WINDOW TO BE REMOVED

EXISTING WALL TO REMAIN

ANY STRUCTURAL WALLS.


EXISTING WALL TO BE REMOVED. CONTRACTOR


STRUCTURAL DRAWINGS BEFORE REMOVING

EXISTING DOOR AND FRAME TO REMAIN

EXISTING DOOR AND FRAME TO BE REMOVED

- 1. CONTRACTOR SHALL VERIFY WITH OWNER PRIOR TO DEMOLISHING ALL EXISTING SINKS AND WC TO BE REMOVED OR RELOCATED.
- 2. UNLESS OTHERWISE NOTED AS EXISTING TO REMAIN OR TO BE RELOCATED, ALL PLUMBING FIXTURES LOCATED IN THE AREAS SHOWN AS BEING DEMOLISHED OR NOT USED AFTER WORK IS COMPLETED, SHALL BE REMOVED. LINES RUN IN SLAB SHALL BE CUT FLUSH, PLUGGED AND ABANDONED AFTER FIXTURES ARE REMOVED.
- 3. SEE PLUMBING SHEETS FOR DETAILS.

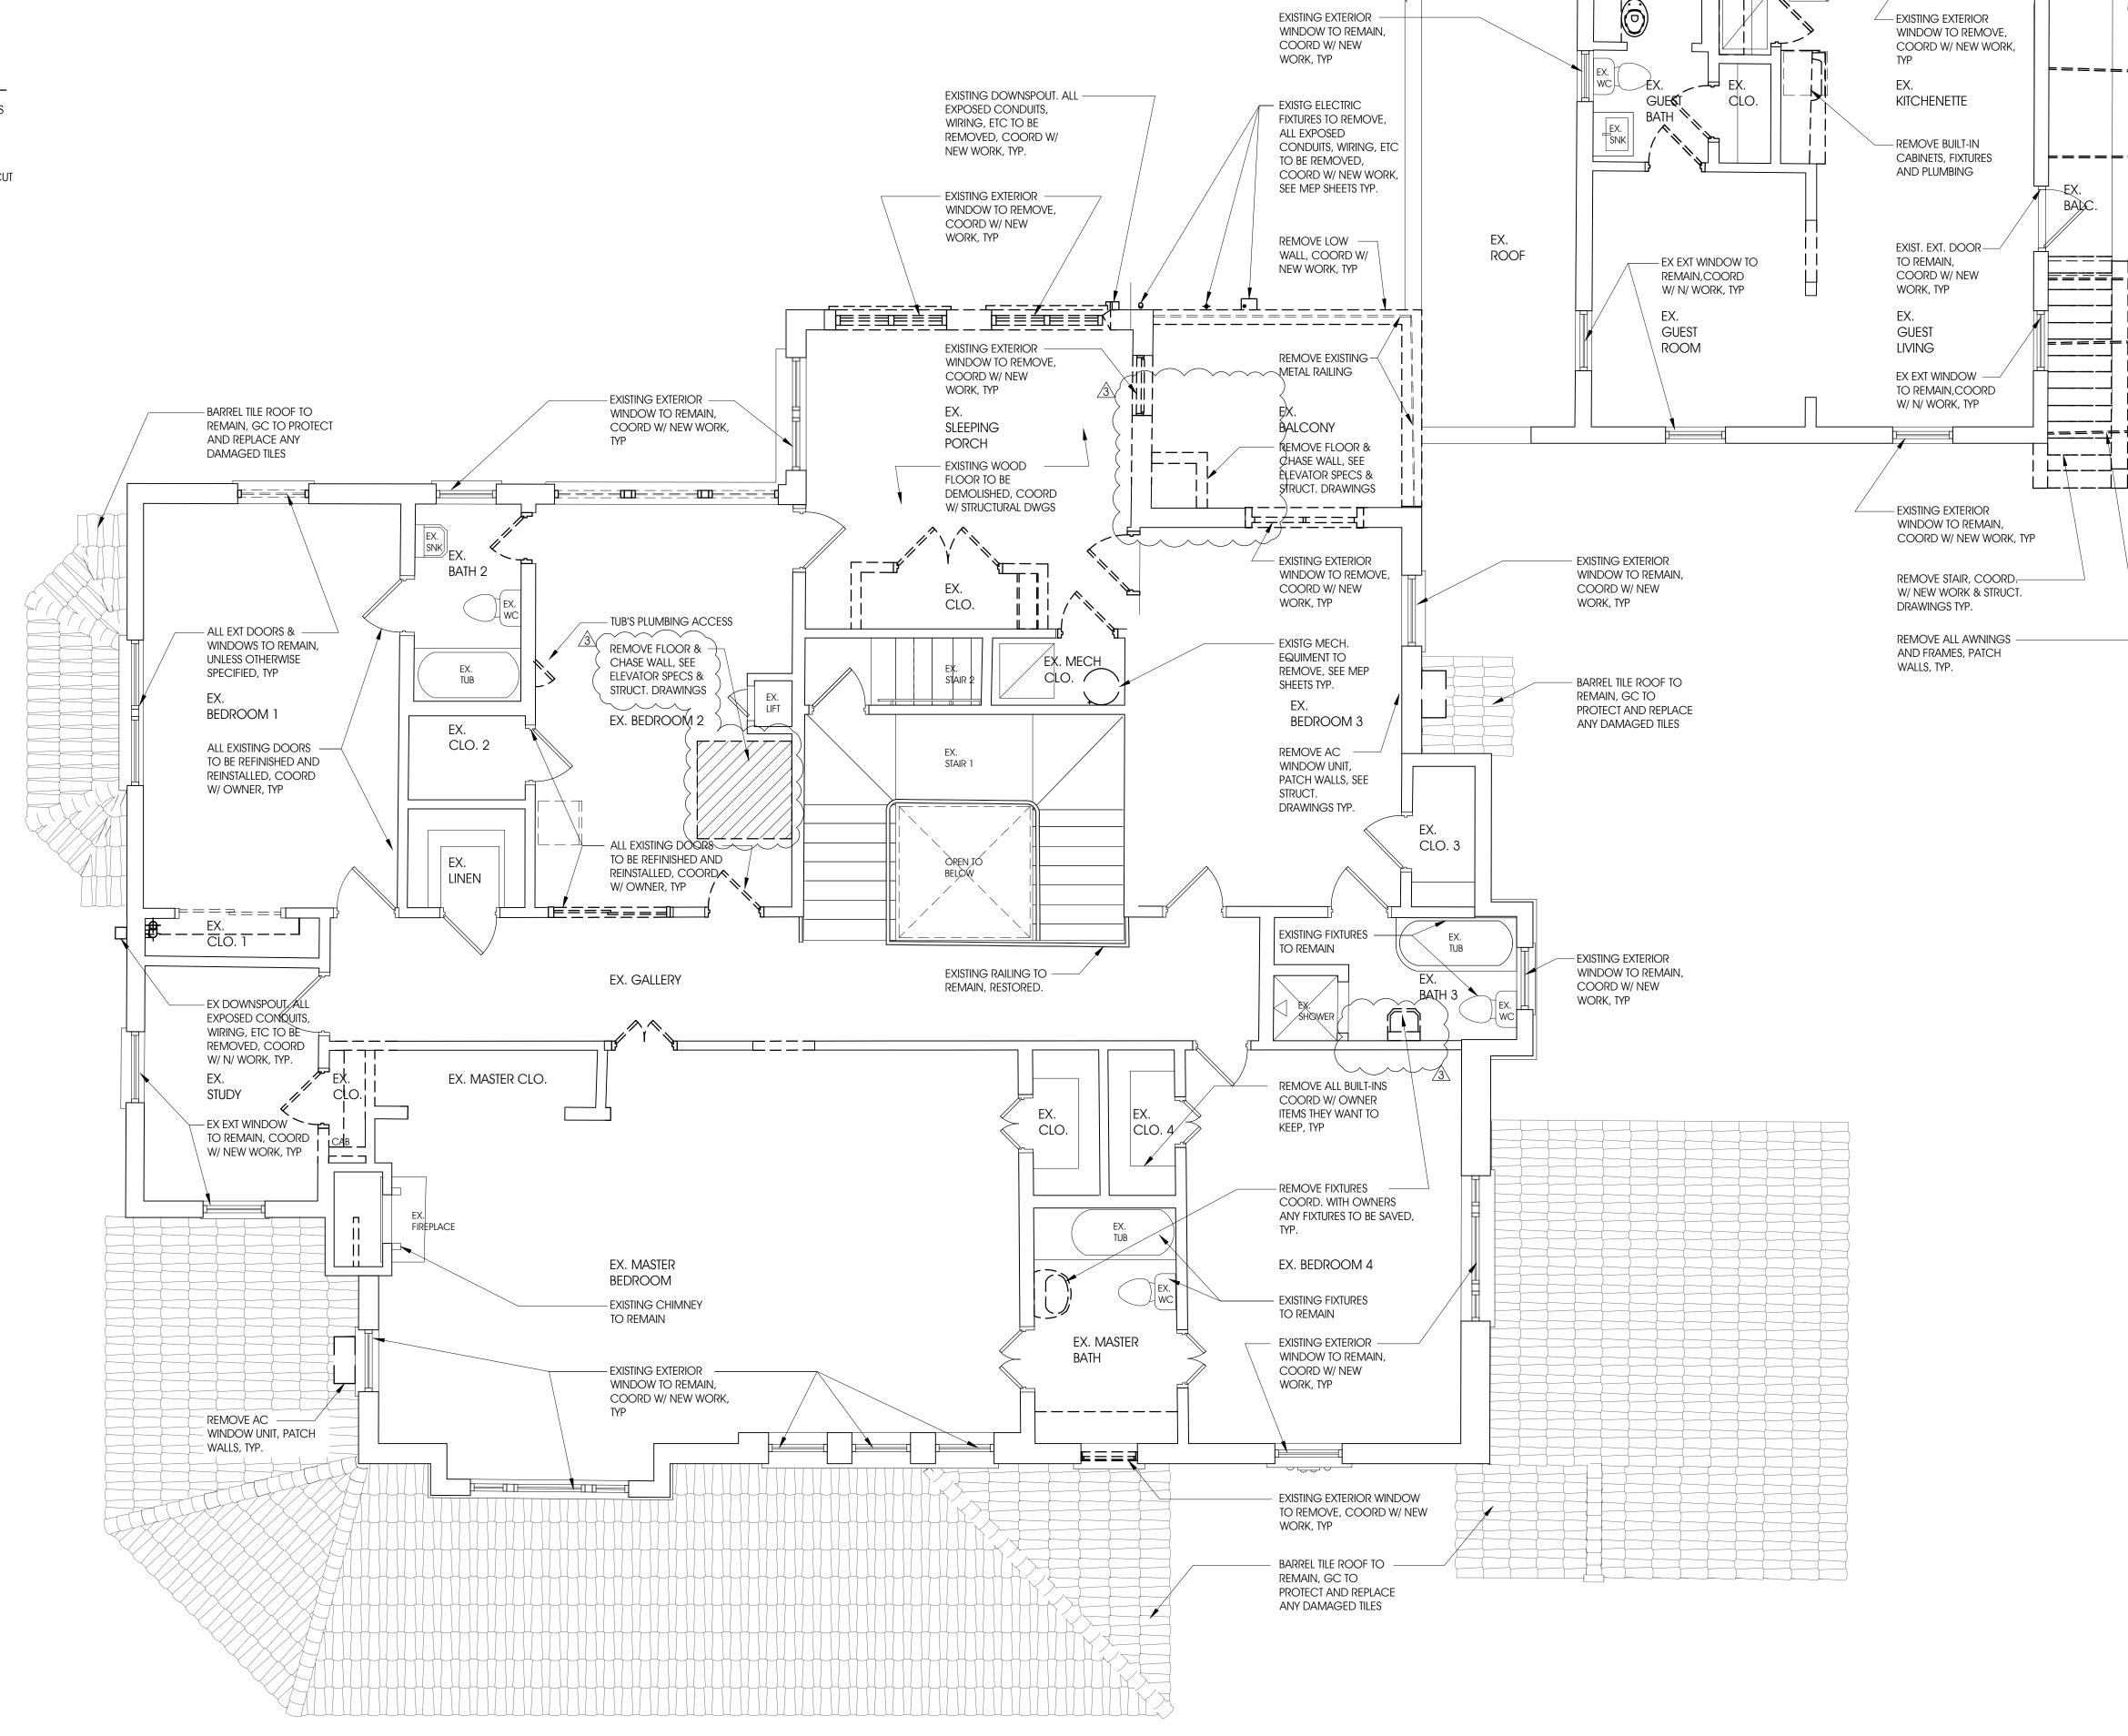

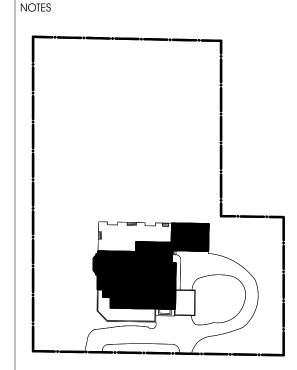

KEYPLAN
SCALE: N.T.S.

## LOCUS ARCHITECTURE INCORPORATED

500 South Dixie Highway, Suite 307 Coral Gables, Florida 33146 Tel (305) 740-0120 Email: locus@locusarchitecture.net

CONSULTANT(S)

NO.	REVISION/SUBMISSION	DATE
	REVIEW	01-13-25
	COA HISTORICAL SUBM (MASTER PLAN)	02-06-23
	PERMIT SUBMITTAL	10-28-23
	BOA SUBMITTAL	02-08-24
	COA SUBMITTAL	04-17-24
<u>/3\</u>	OWNER REVISIONS	01-27-25
	1	

PROJECT

Historical: Remodel & Additions
Soane Residence

1104 Malaga Avenue Coral Gables, FL 33134

DRAWING

Existing And Demolition Second Floor Plan



Nelson de Leon AR 13937 REVIEWED

PROJ. NO.

NDL

A-02.1

EXISTING AND DEMOLITION SECOND FLOOR PLAN

SCALE: 1/4" = 1'-0"

- EXISTING DOWNSPOUT, ALL

REMOVED, COORD W/ NEW


EXPOSED CONDUITS,


WIRING, ETC TO BE


WORK, TYP.

EXISTING PARAPET -

TO REMAIN

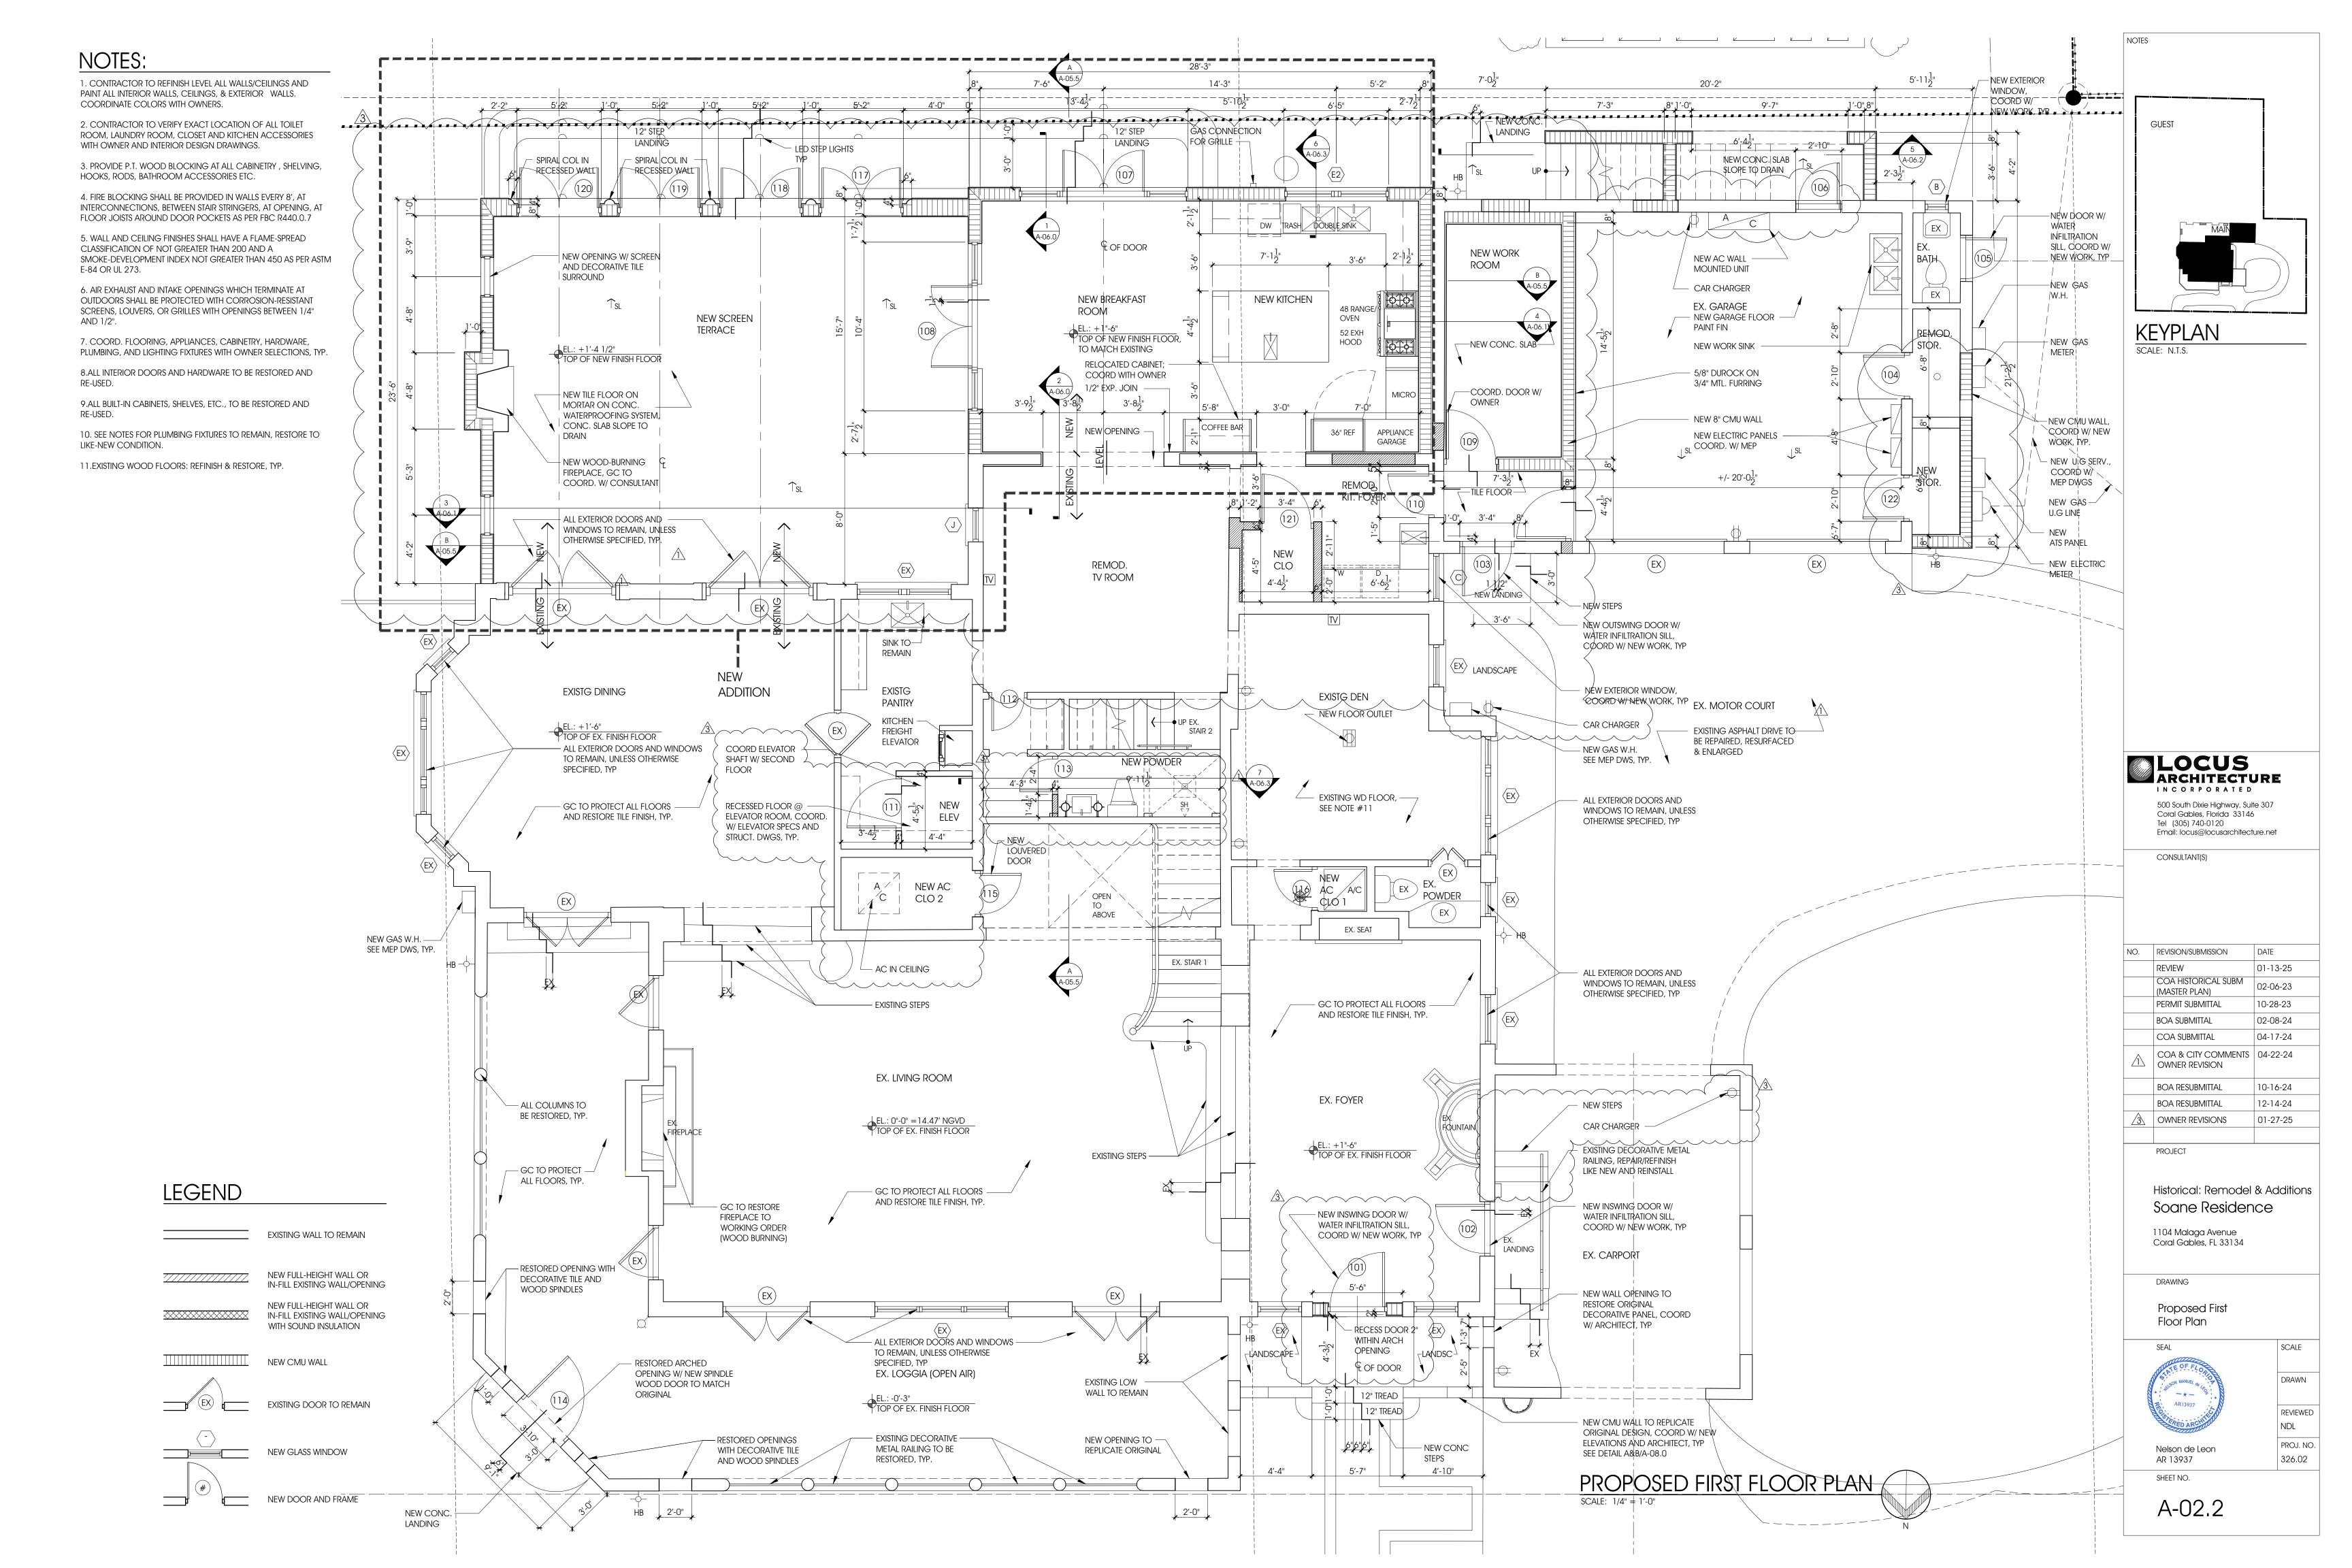

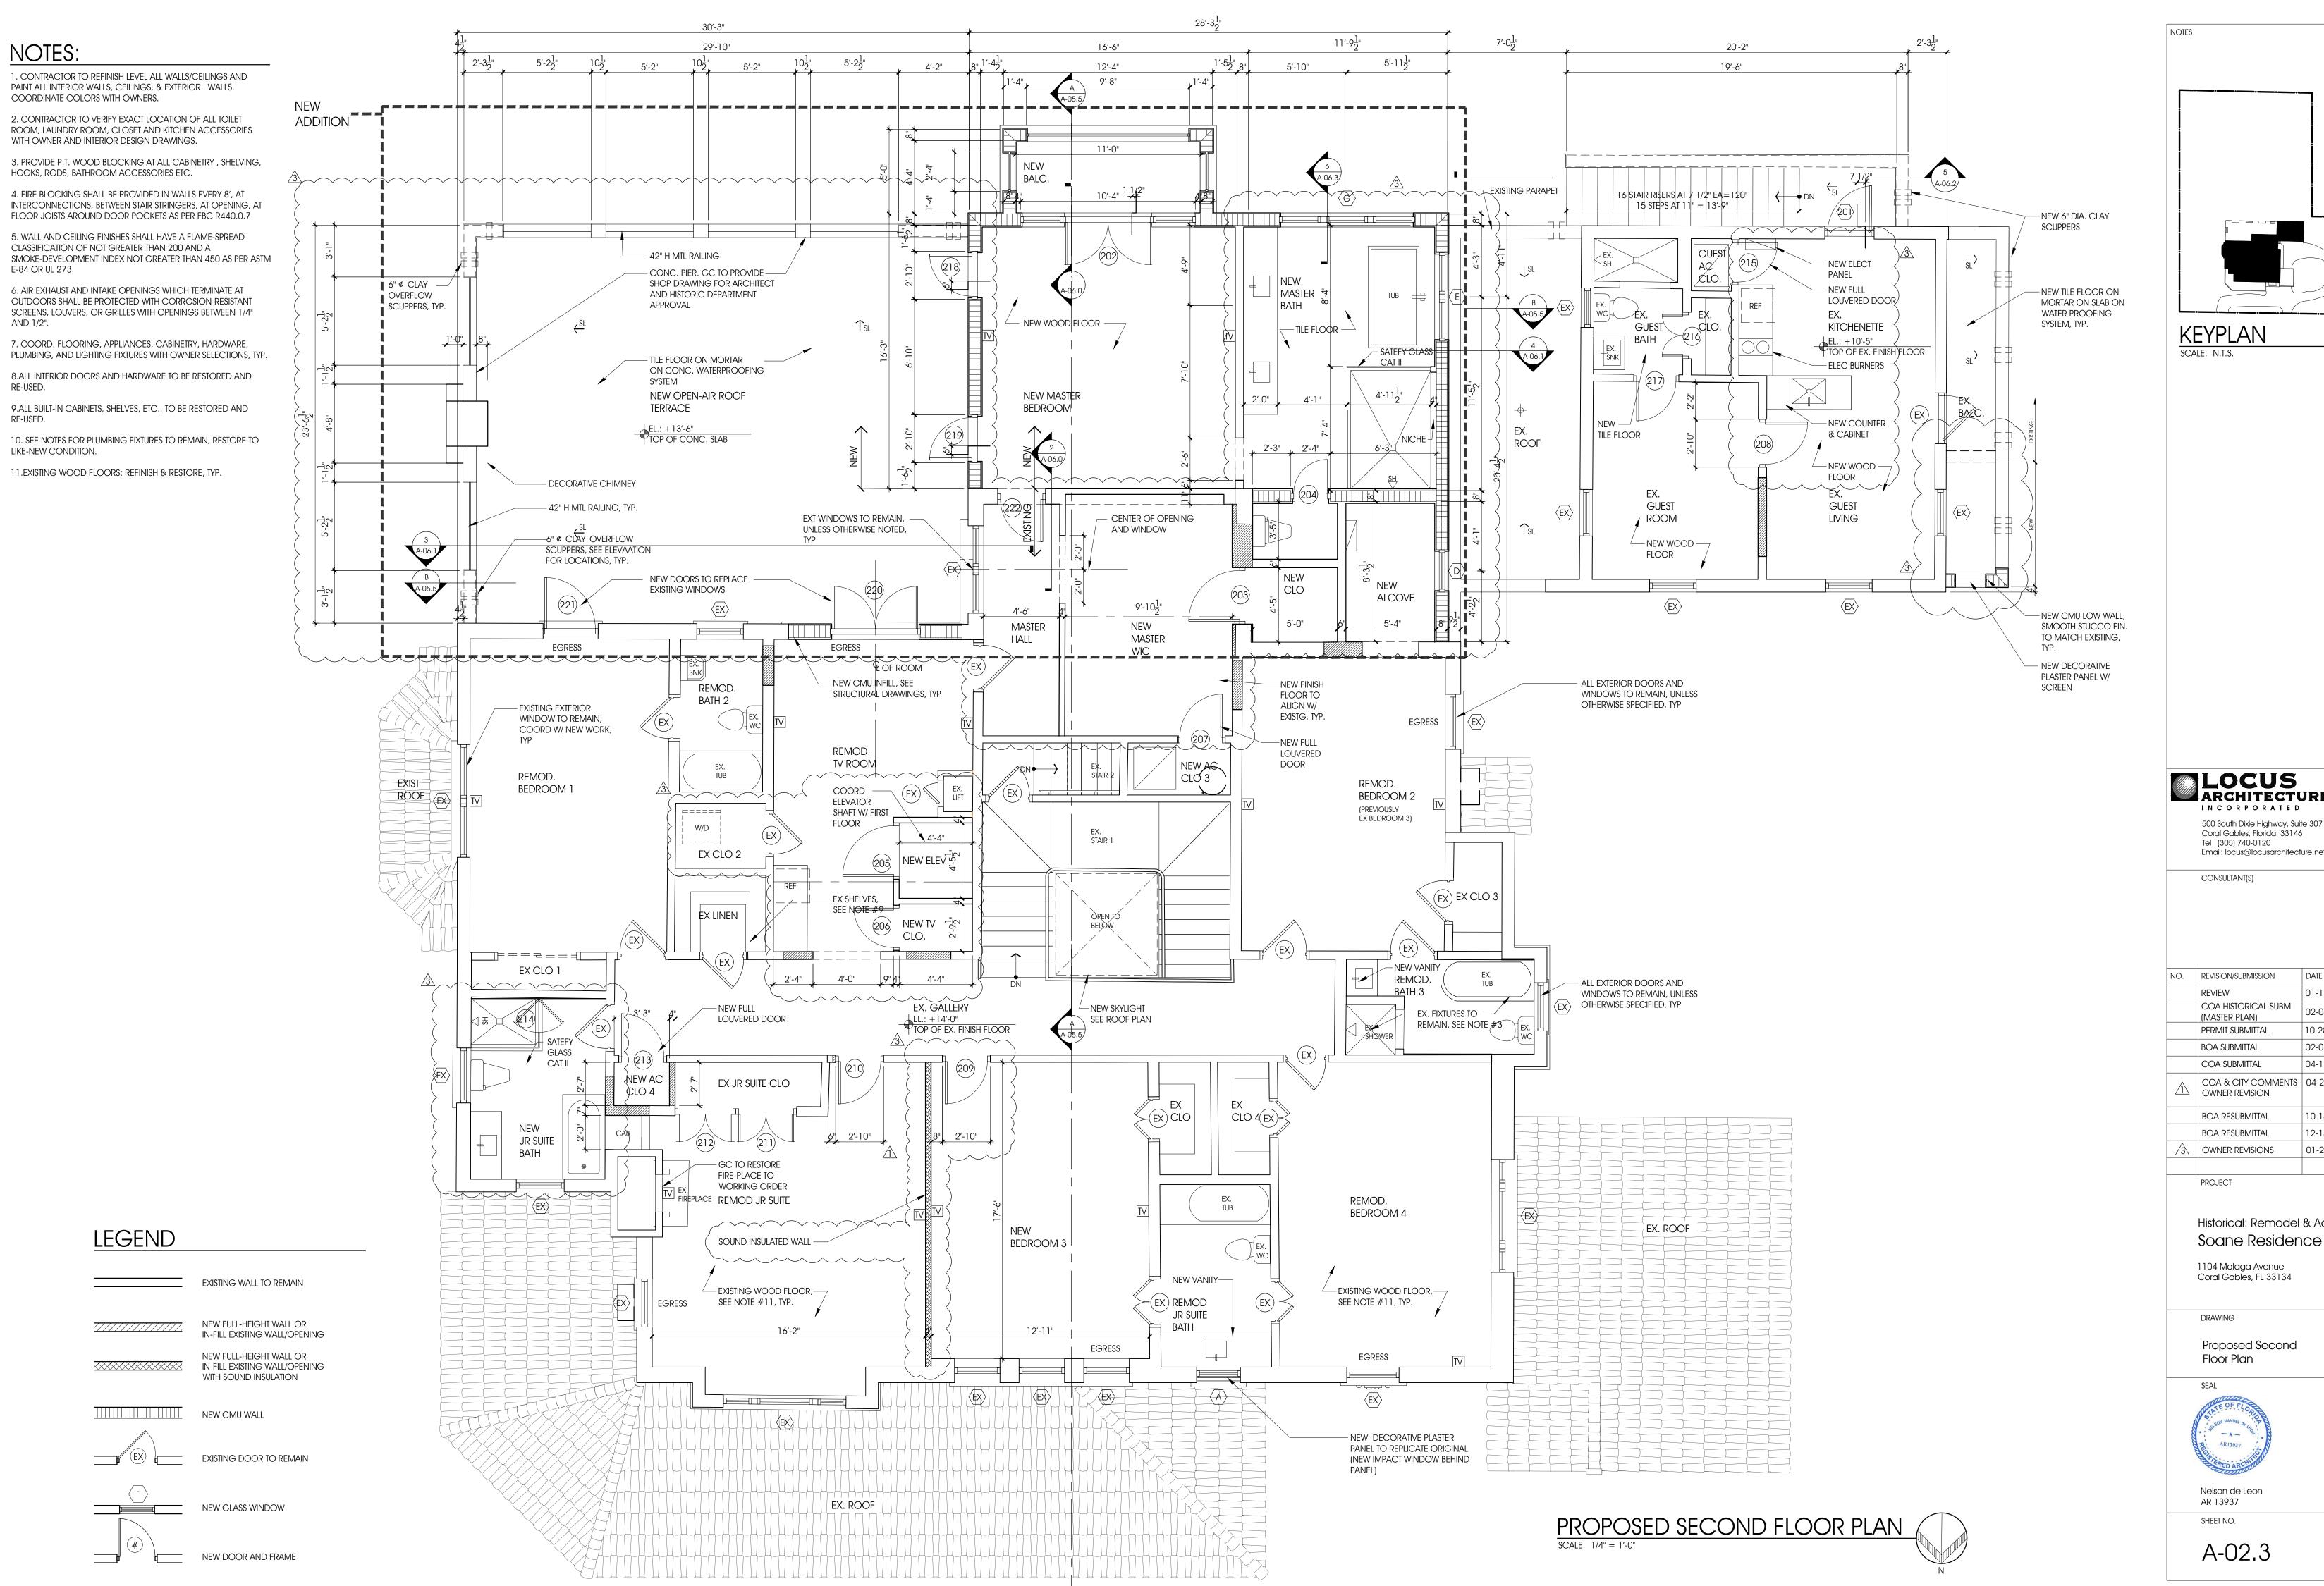

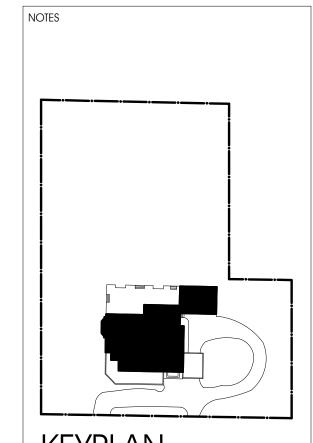

ARCHITECTURE INCORPORATED

Email: locus@locusarchitecture.net

NO.	REVISION/SUBMISSION	DATE
	REVIEW	01-13-25
	COA HISTORICAL SUBM (MASTER PLAN)	02-06-23
	PERMIT SUBMITTAL	10-28-23
	BOA SUBMITTAL	02-08-24
	COA SUBMITTAL	04-17-24
Â	COA & CITY COMMENTS OWNER REVISION	04-22-24
	BOA RESUBMITTAL	10-16-24
	BOA RESUBMITTAL	12-14-24
3	OWNER REVISIONS	01-27-25

Historical: Remodel & Additions Soane Residence


Proposed Second




REVIEWED

PROJ. NO.

NDL

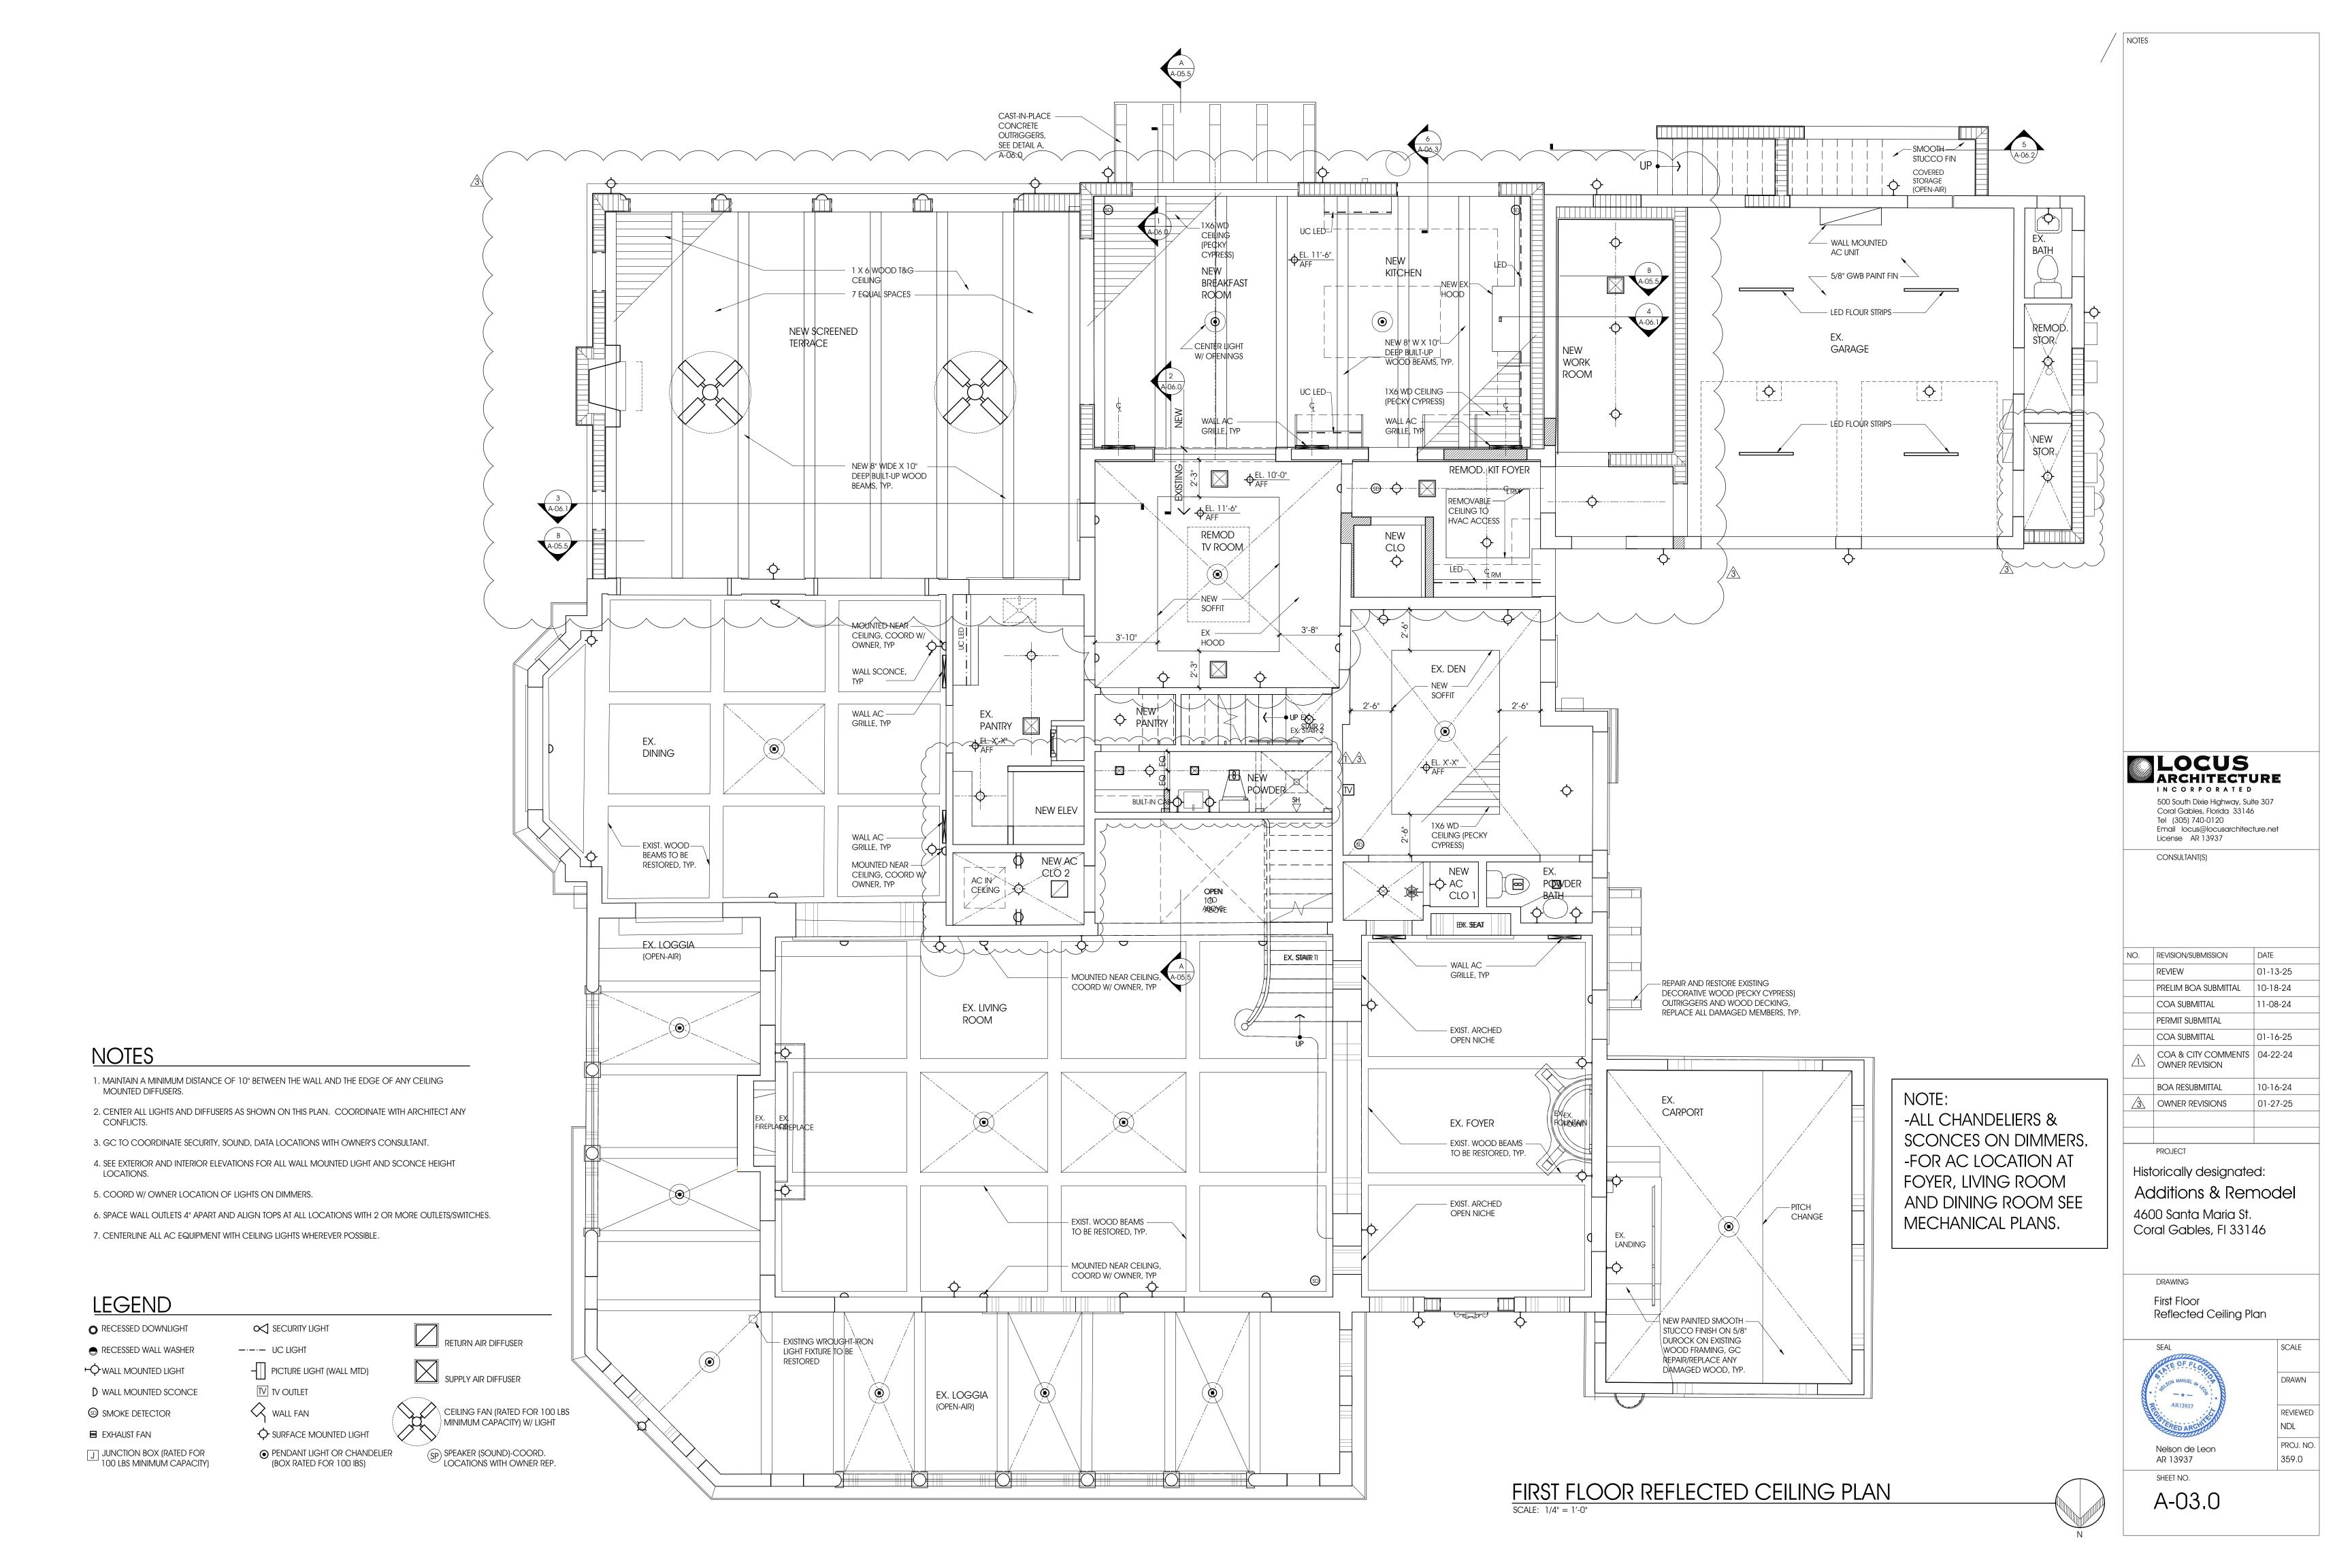

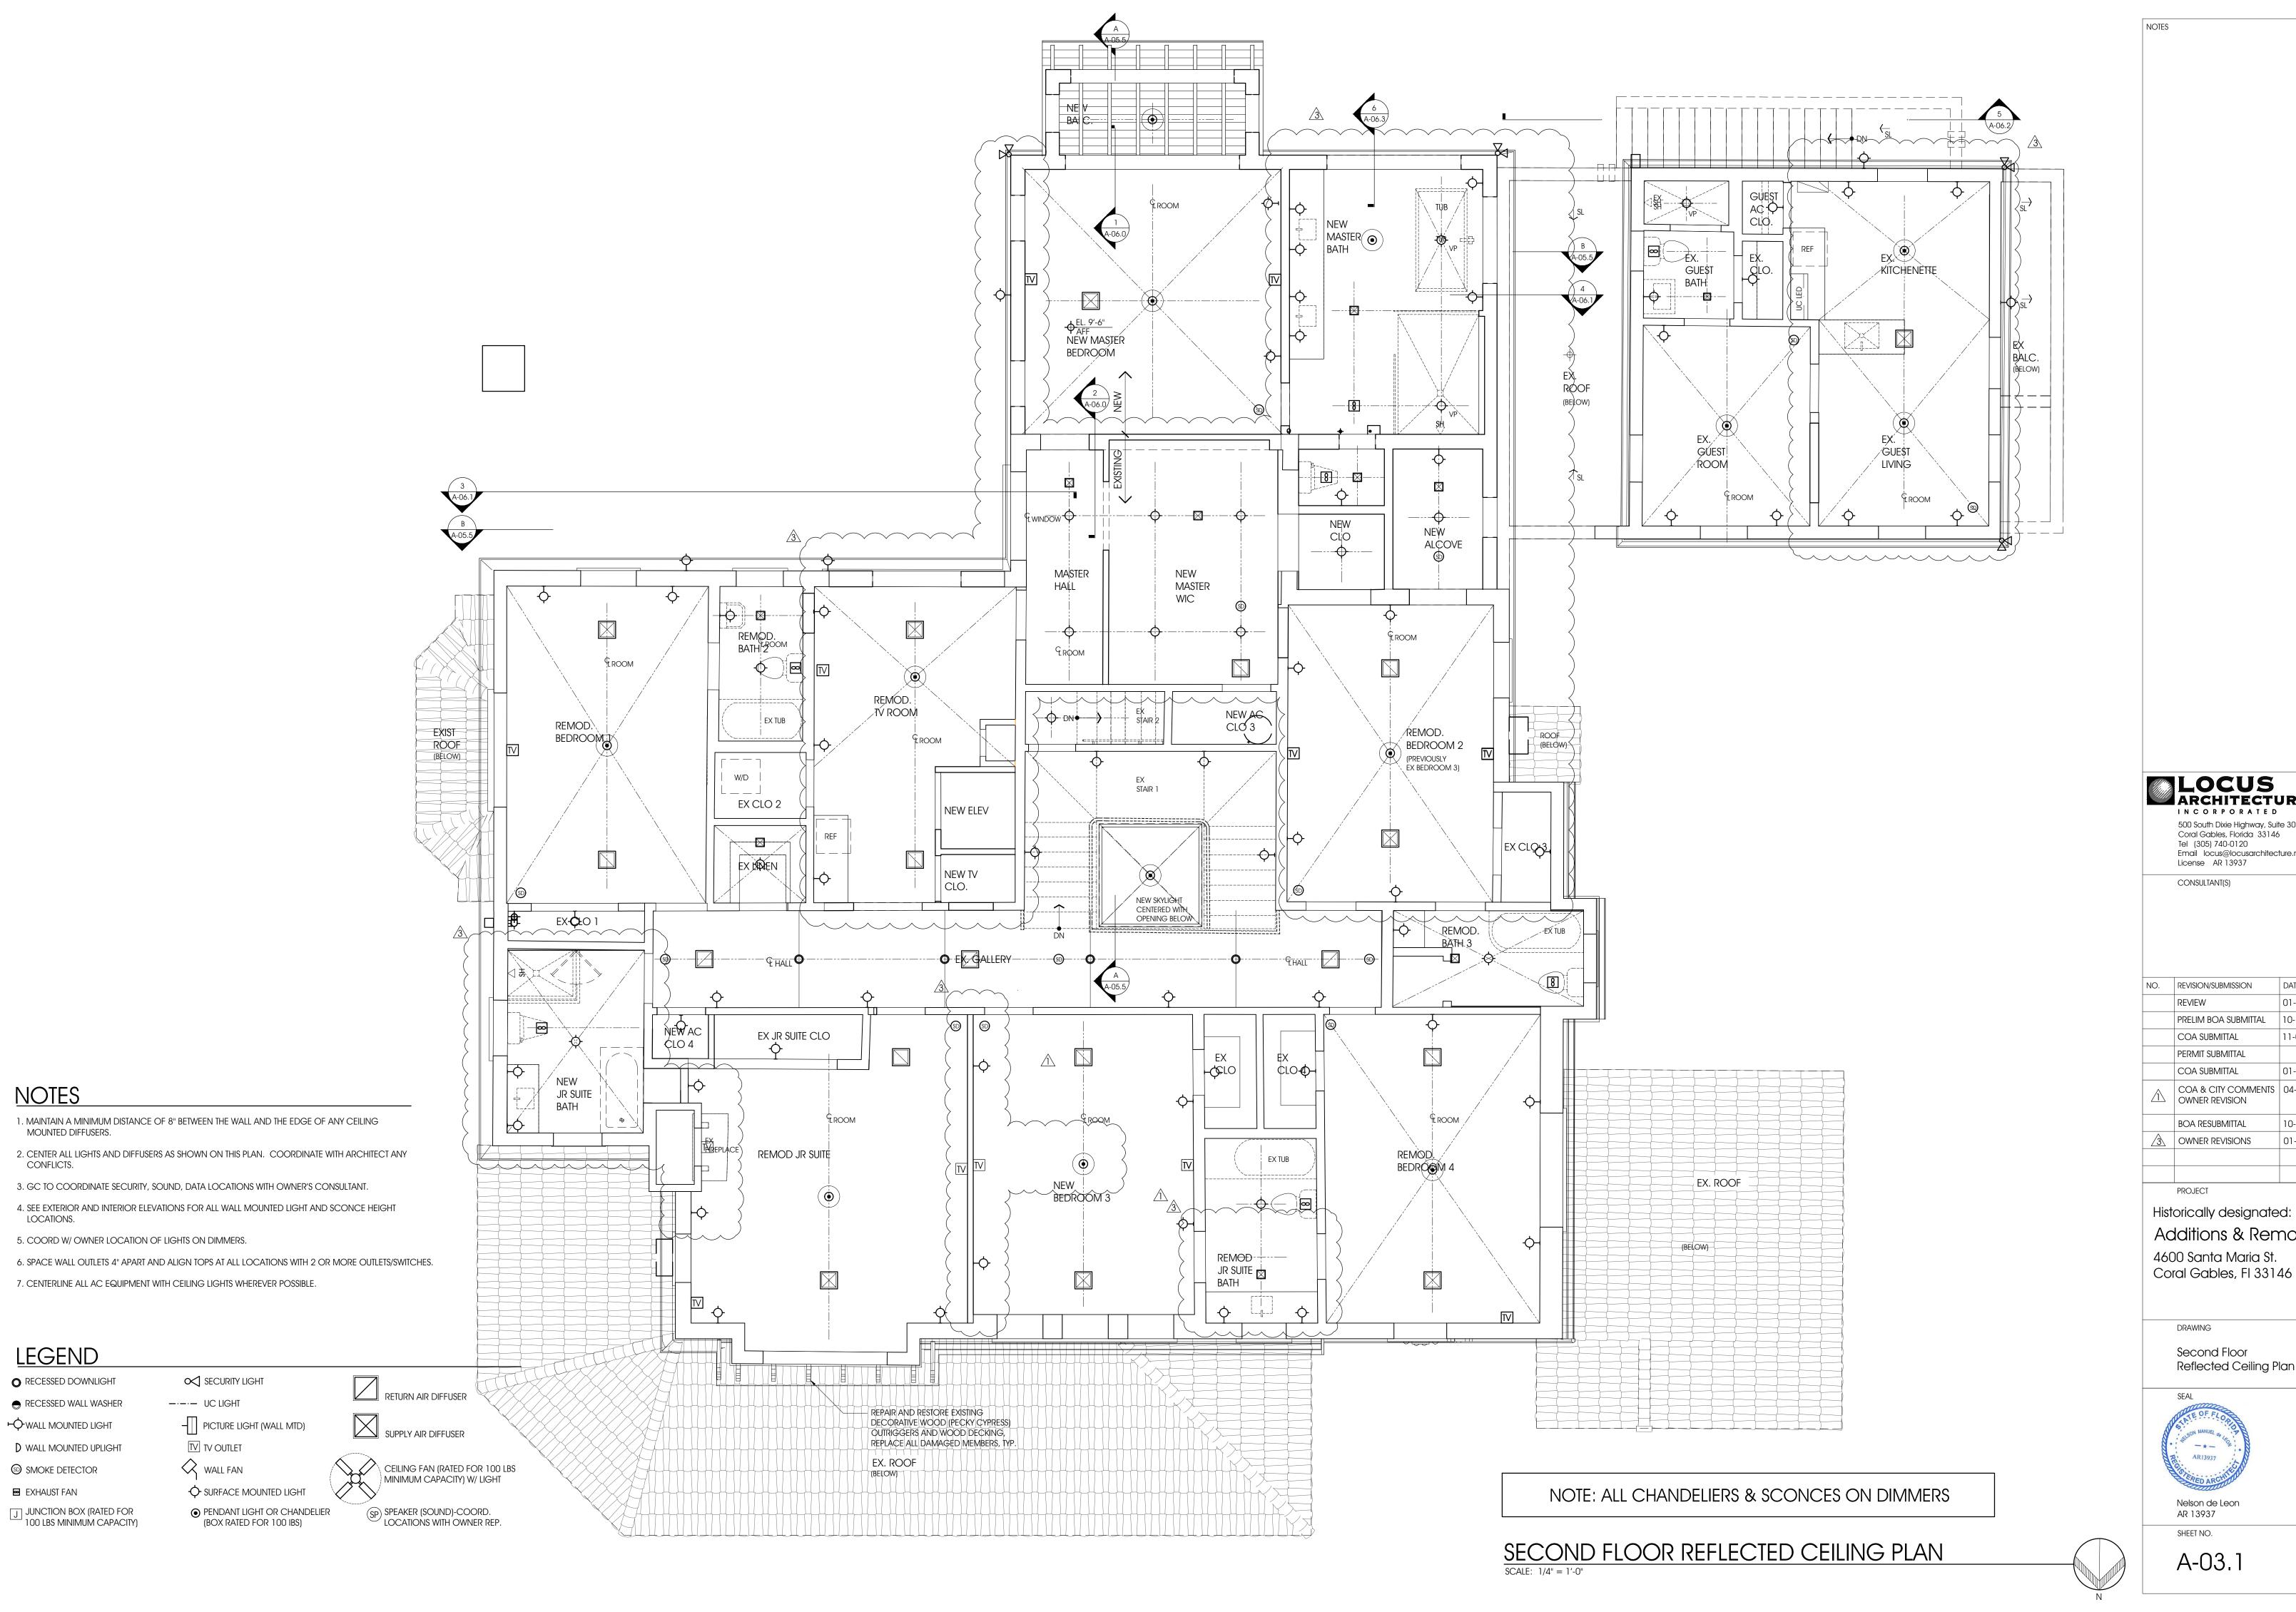

LOCUS

INCORPORATED 500 South Dixie Highway, Suite 307 Coral Gables, Florida 33146 Email locus@locusarchitecture.net

CONSULTANT(S)

NO.	REVISION/SUBMISSION	DATE
	REVIEW	01-13-25
	PRELIM BOA SUBMITTAL	10-18-24
	COA SUBMITTAL	11-08-24
	PERMIT SUBMITTAL	
	COA SUBMITTAL	01-16-25
$\triangle$	COA & CITY COMMENTS OWNER REVISION	04-22-24
	BOA RESUBMITTAL	10-16-24
<u>/3</u>	OWNER REVISIONS	01-27-25

Historically designated: Additions & Remodel 4600 Santa Maria St.

DRAWING

Second Floor Reflected Ceiling Plan



Nelson de Leon AR 13937

DRAWN


REVIEWED


PROJ. NO.

NDL

SHEET NO.

A-03.1

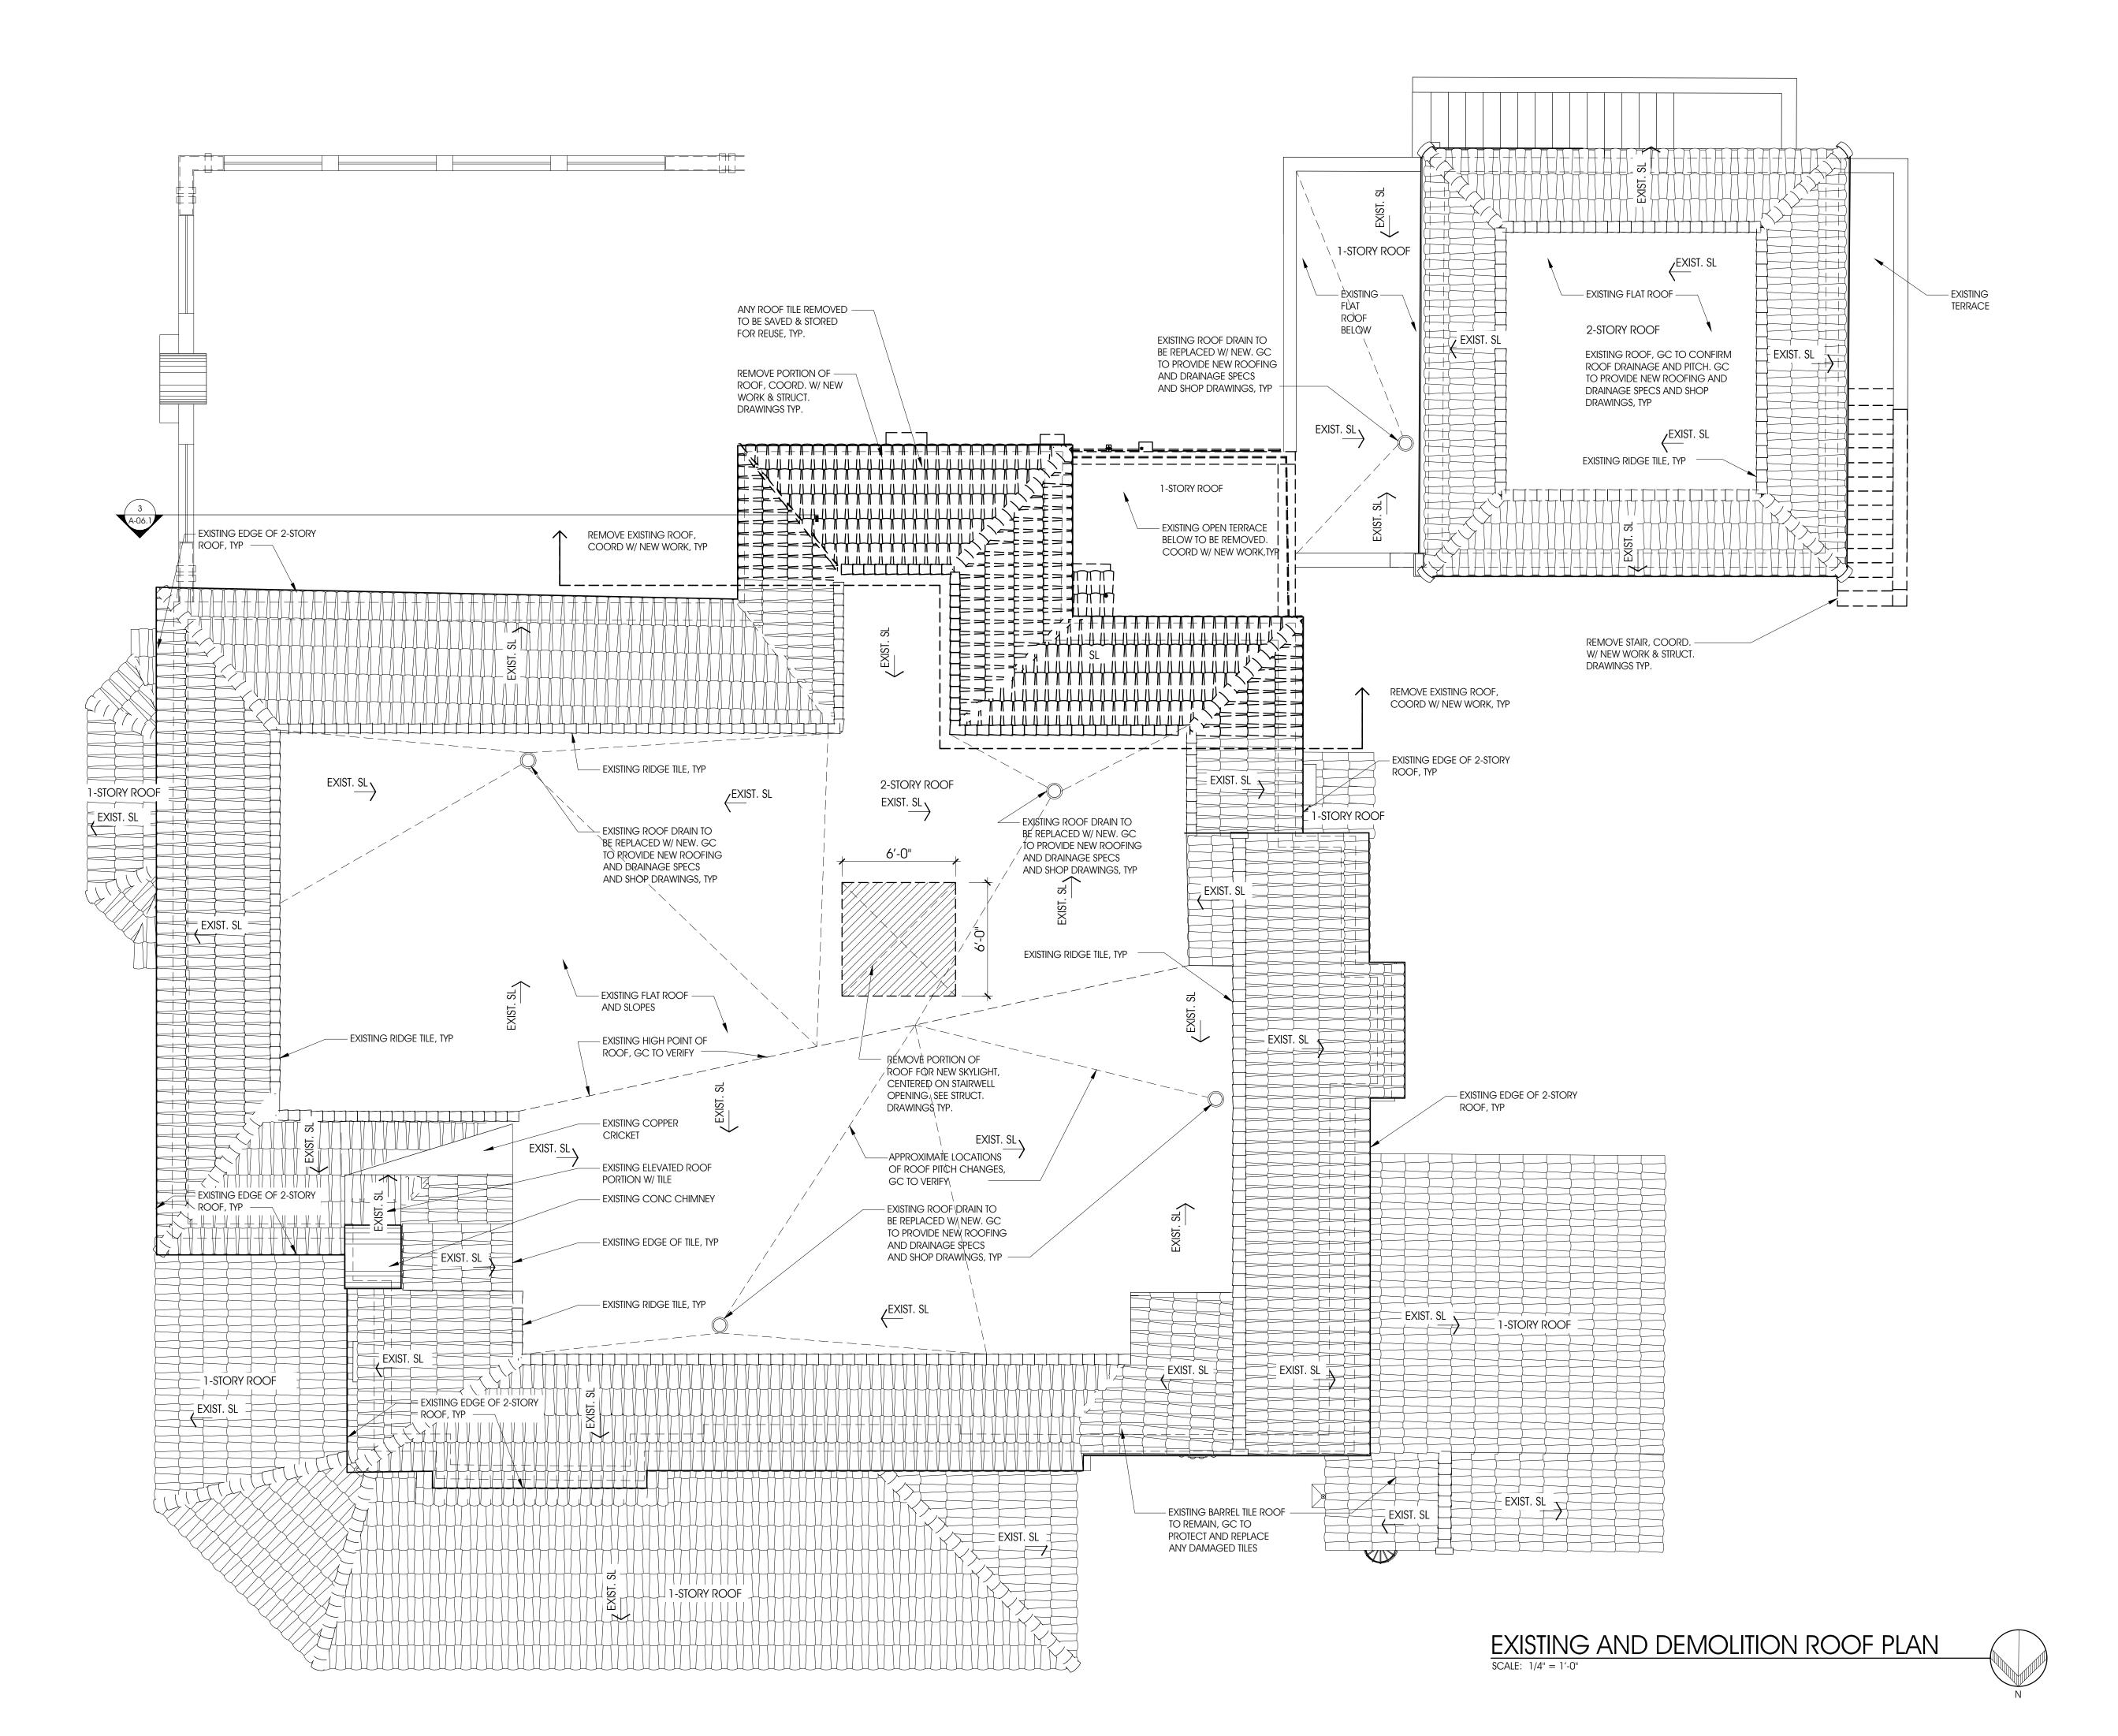

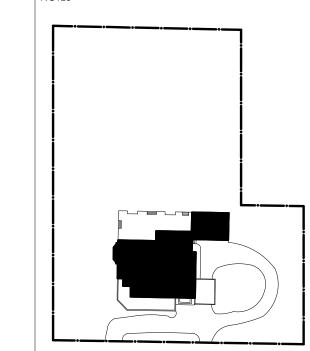

KEYPLAN SCALE: N.T.S.

LOCUS ARCHITECTURE

> 500 South Dixie Highway, Suite 307 Coral Gables, Florida 33146 Tel (305) 740-0120 Email: locus@locusarchitecture.net

CONSULTANT(S)

NO.	REVISION/SUBMISSION	DATE
	REVIEW	01-13-25
	COA HISTORICAL SUBM (MASTER PLAN)	02-06-23
	PERMIT SUBMITTAL	10-28-23
	BOA SUBMITTAL	02-08-24
	COA SUBMITTAL	04-17-24
	OWNER REVISION	10-15-24
	BOA RESUBMITTAL	

PROJECT

Historical: Remodel & Additions Soane Residence

DRAWN

REVIEWED NDL

PROJ. NO.

326.02

1104 Malaga Avenue Coral Gables, FL 33134


DRAWING


Existing And Demolition Roof Plan



Nelson de Leon AR 13937 SHEET NO.

A-04.0

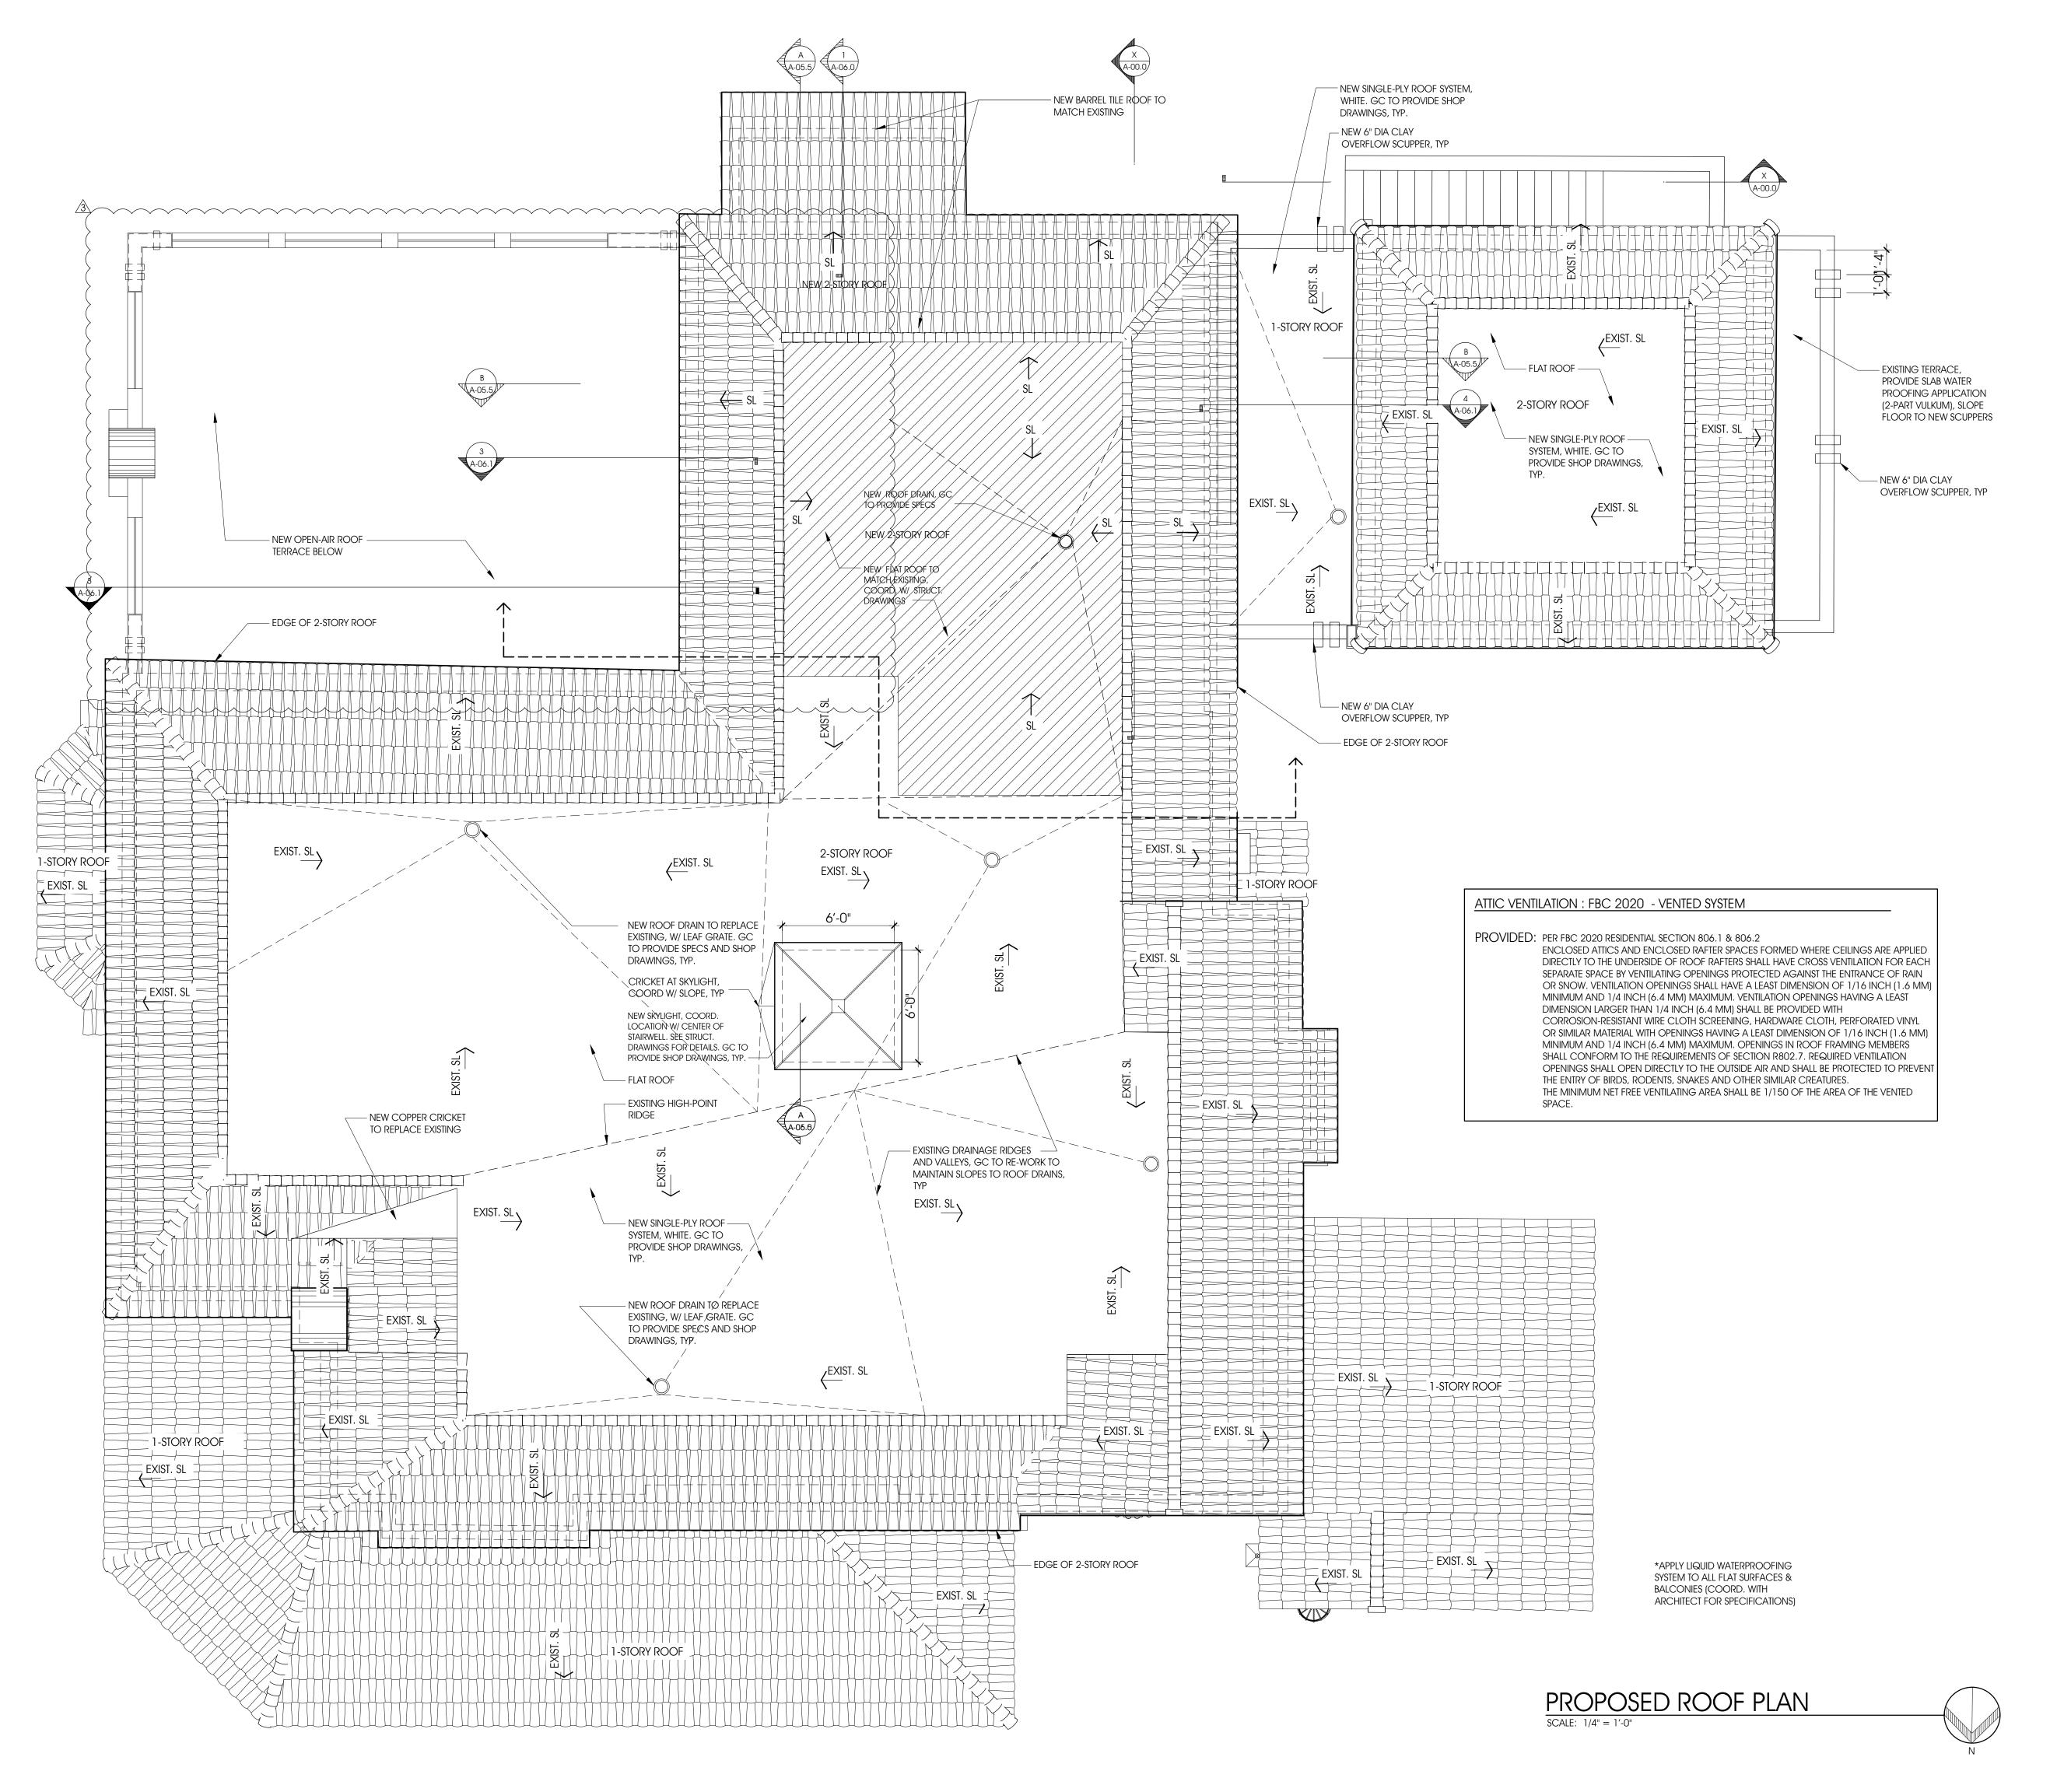

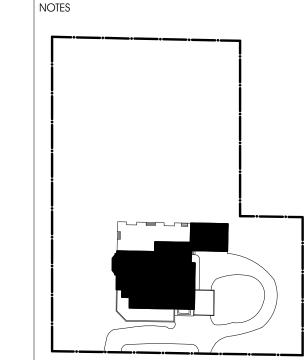

KEYPLAN SCALE: N.T.S.

LOCUS ARCHITECTURE

> 500 South Dixie Highway, Suite 307 Coral Gables, Florida 33146 Tel (305) 740-0120 Email: locus@locusarchitecture.net

CONSULTANT(S)

NO.	REVISION/SUBMISSION	DATE
	REVIEW	01-13-25
	COA HISTORICAL SUBM (MASTER PLAN)	02-06-23
	PERMIT SUBMITTAL	10-28-23
	BOA SUBMITTAL	02-08-24
	COA SUBMITTAL	04-17-24
	BOA RESUBMITTAL	
3	OWNER REVISIONS	01-27-25

PROJECT

Historical: Remodel & Additions
Soane Residence

SCALE

DRAWN

REVIEWED NDL

PROJ. NO.

326.02

1104 Malaga Avenue Coral Gables, FL 33134

DRAWING


Proposed Roof Plan




Nelson de Leon AR 13937

SHEET NO.

A-04.1

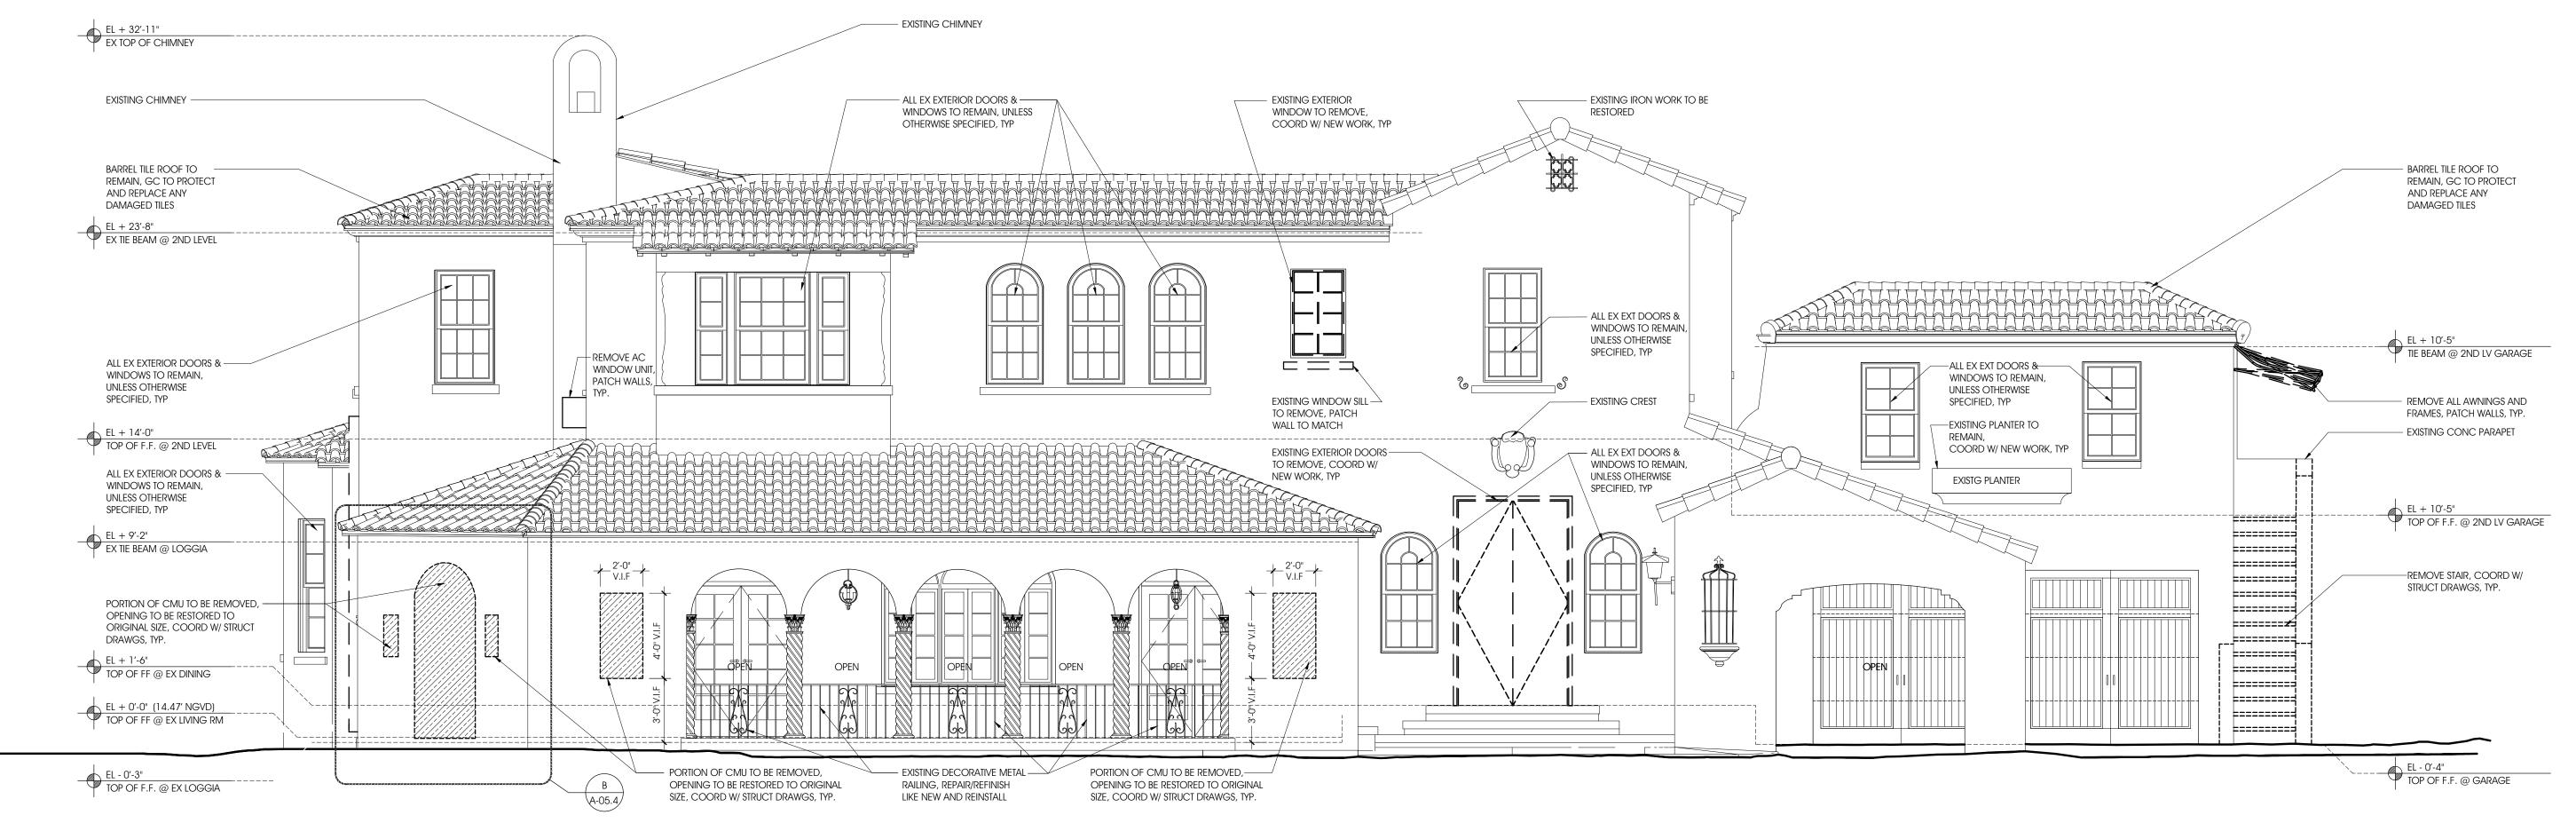

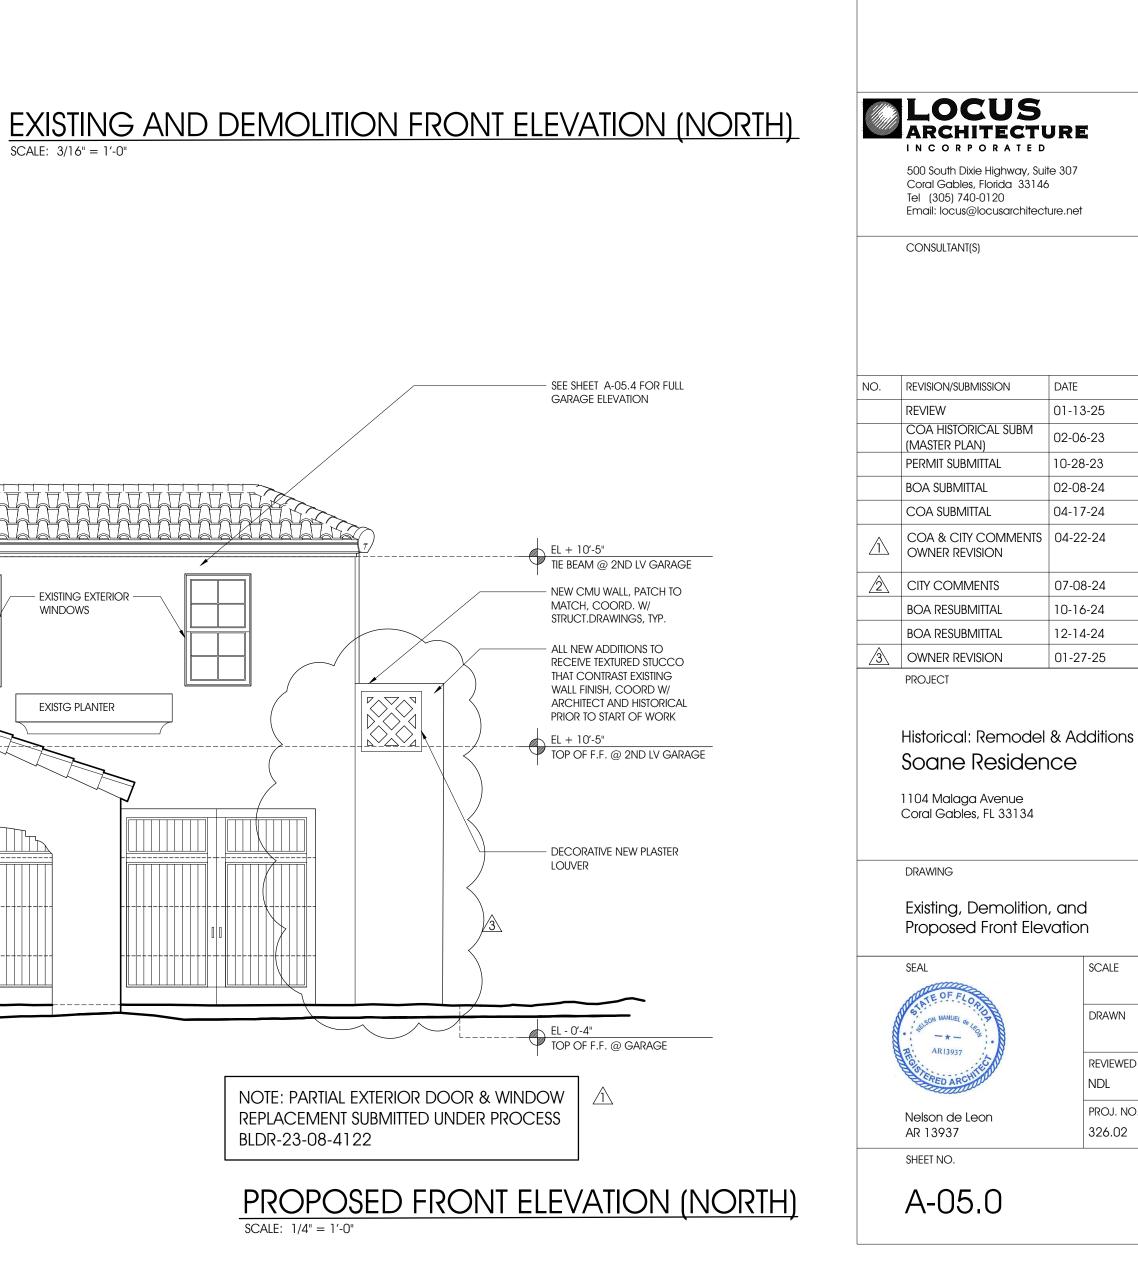

DRAWN

REVIEWED

PROJ. NO.

326.02

NDL

HISTORIC DEPARTMENT

1. WINDOW/DOOR MUNTINS ARE TO BE

3. HOUSE IS NOT TO BE RESTUCCOED IN ITS


4. EXISTING WINDOW SILLS ARE TO REMAIN. 5. WORK WITH STAFF ON ALL DECORATIVE DETAILS TO BE RESTORED (E.G. THE WOODEN SPINDLES,


IRON WORK, LIGHT FIXTURES, ETC.) PRIOR TO

FABRICATION . DETAILED DRAWINGS/SHOP


DRAWINGS ARE TO BE SUBMITTED.

HIGH-PROFILE / DIMENSIONAL. 2. WINDOW/DOOR GLASS TO BE CLEAR/NON-REFLECTIVE/NON-TINT.

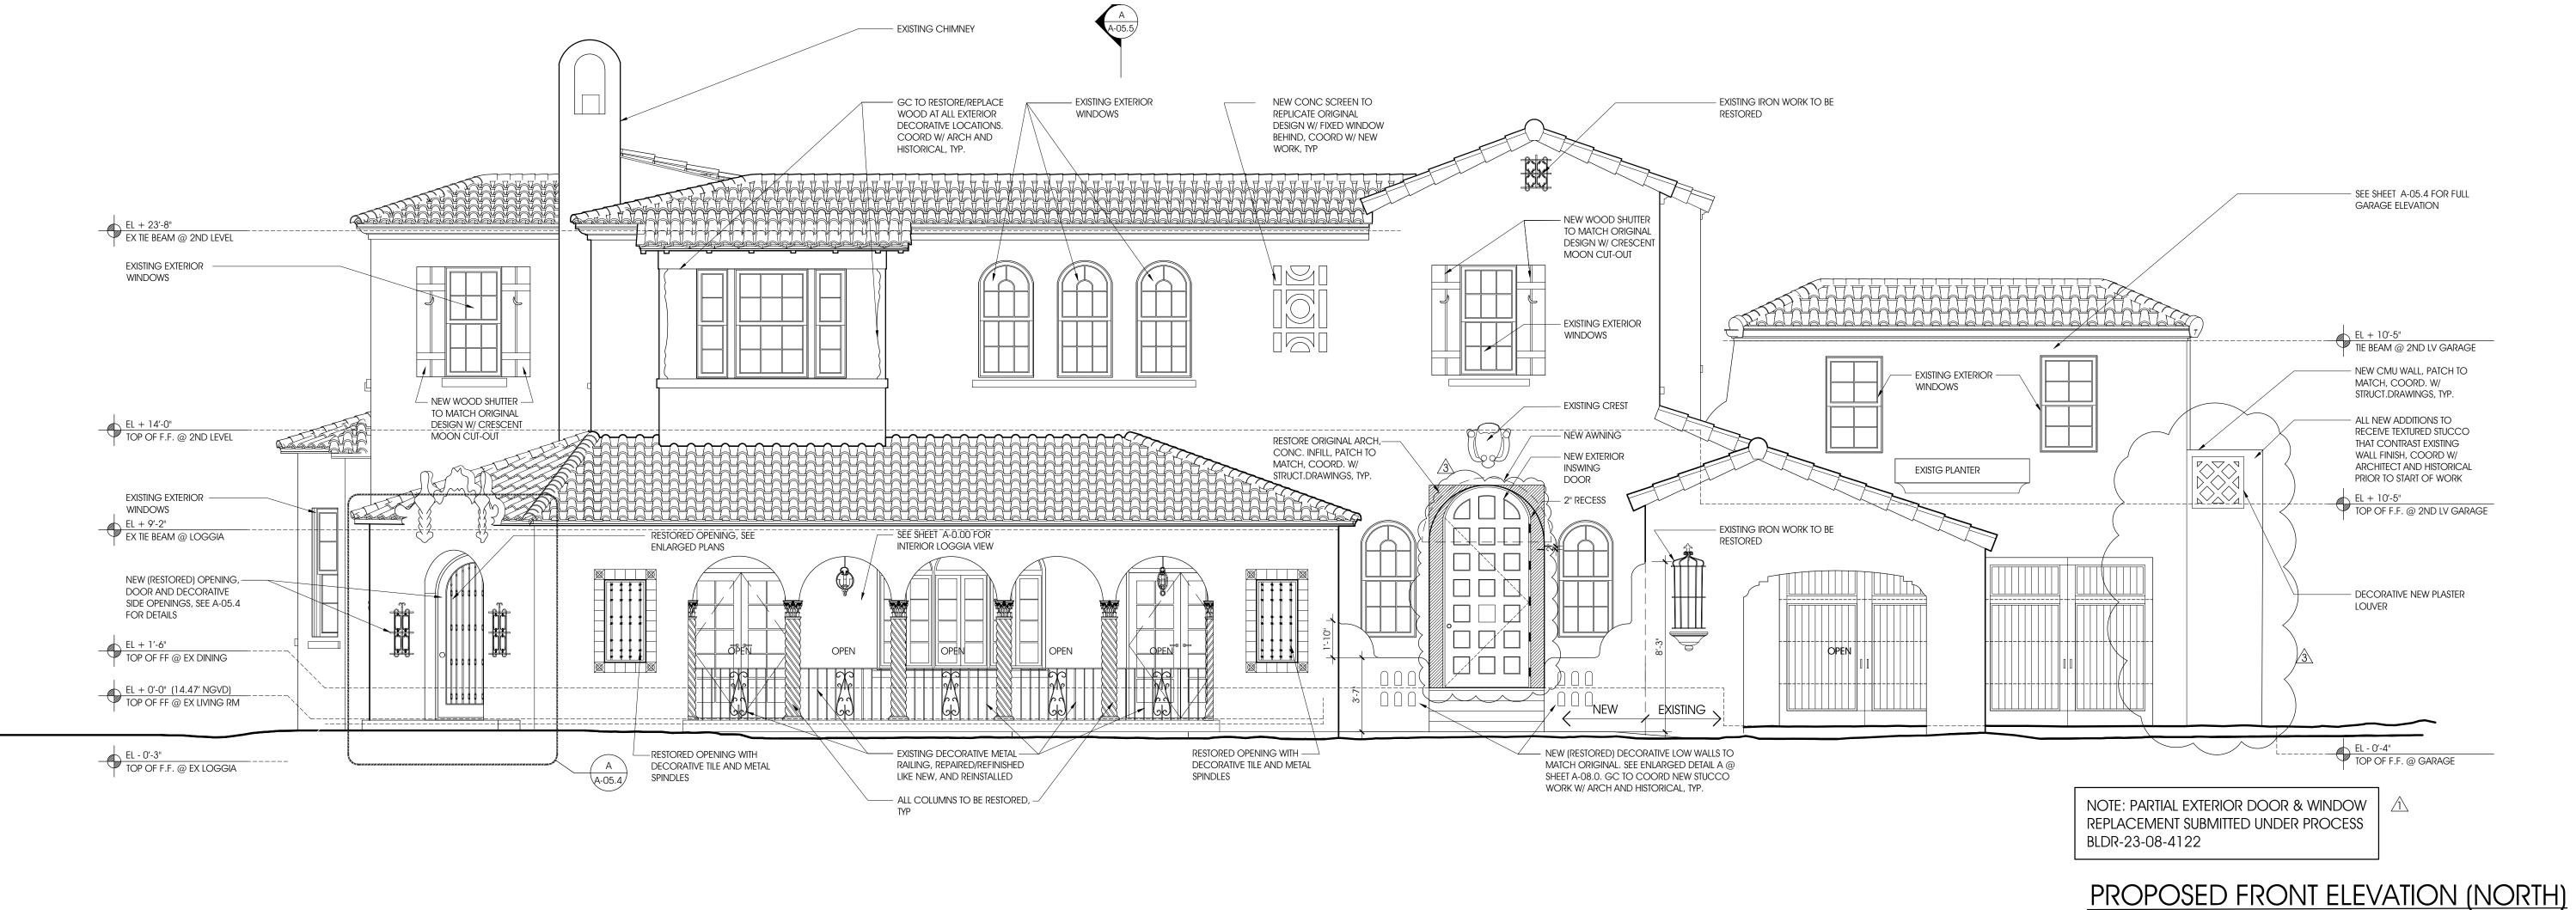


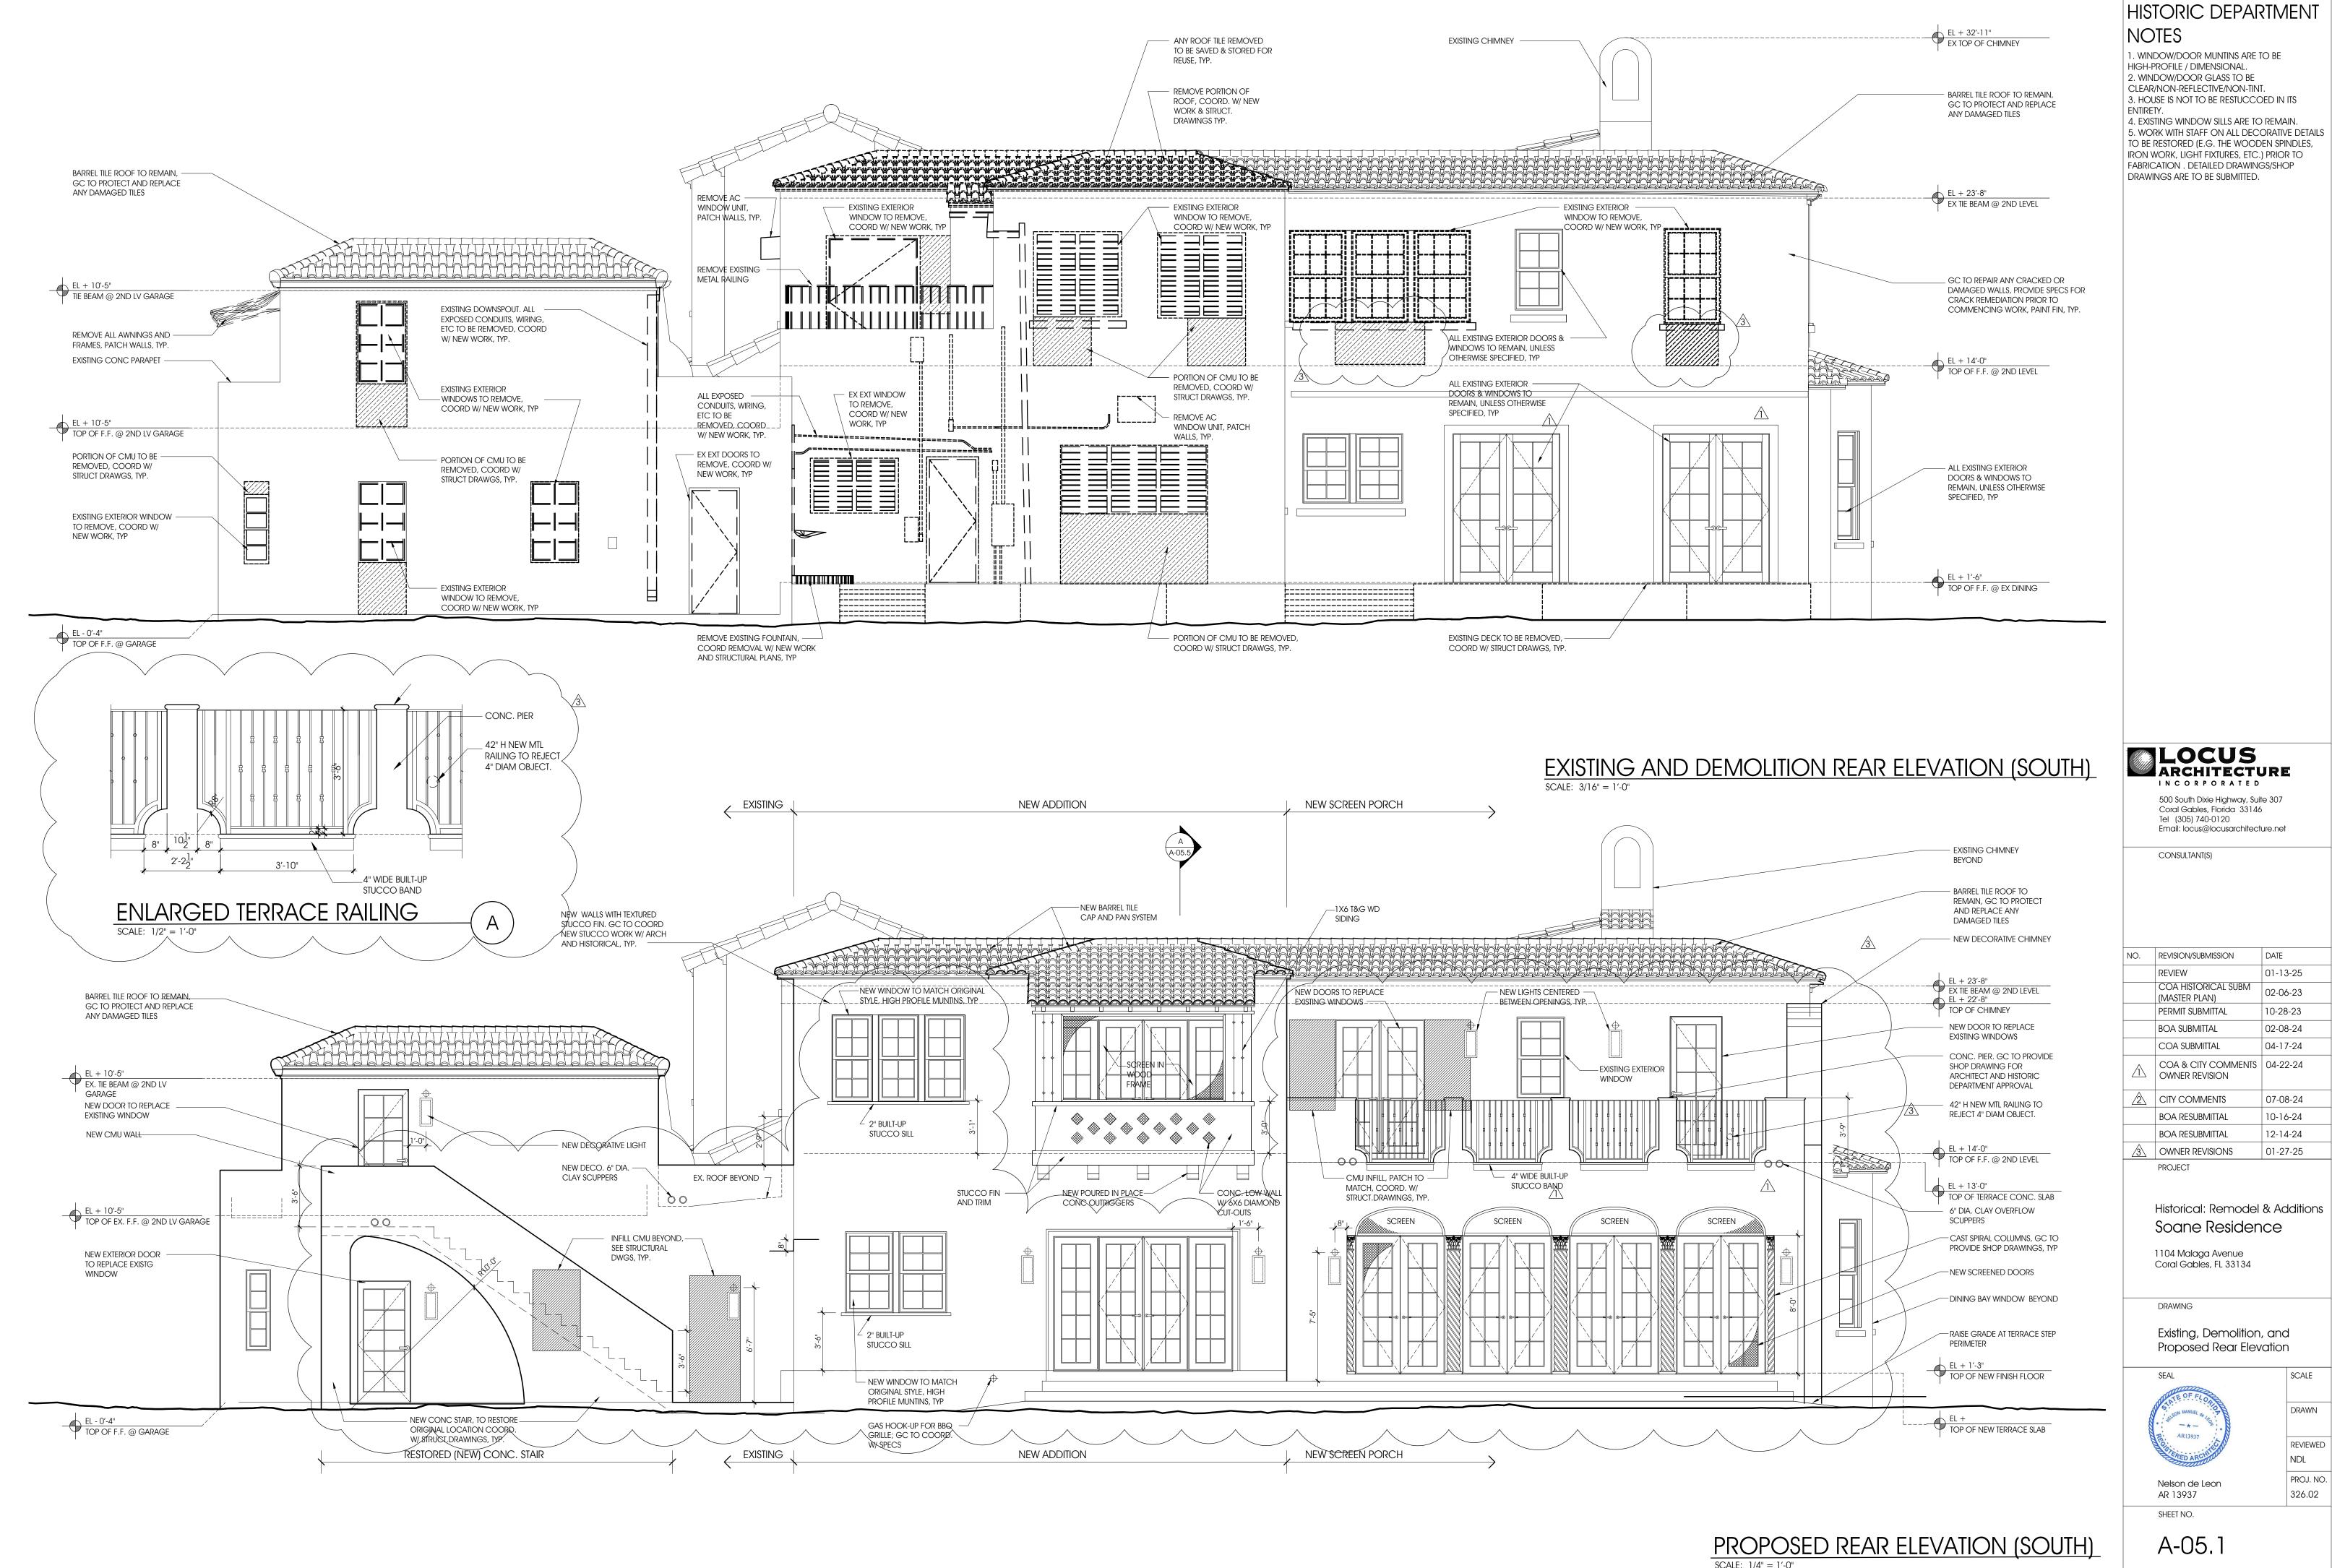

NOTES

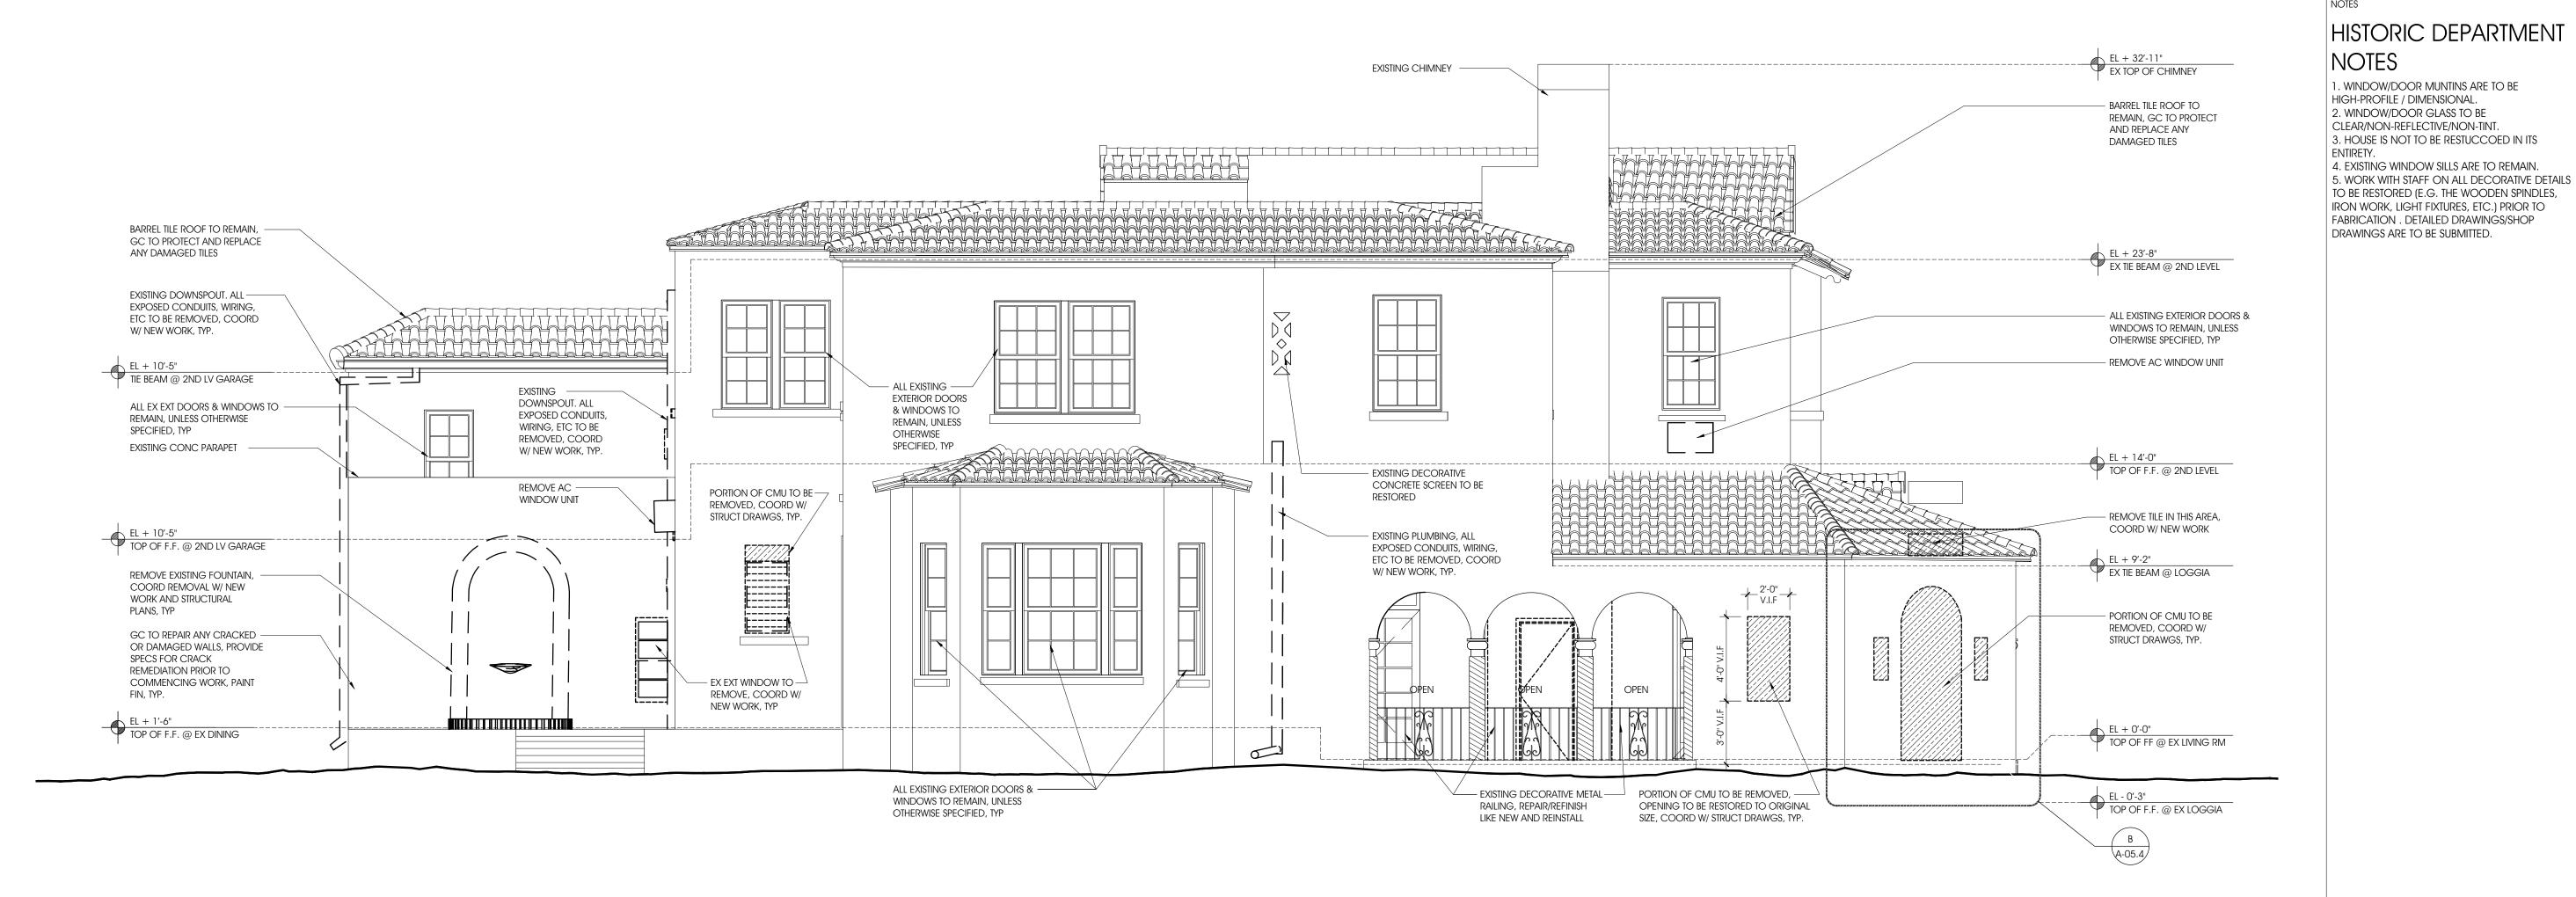



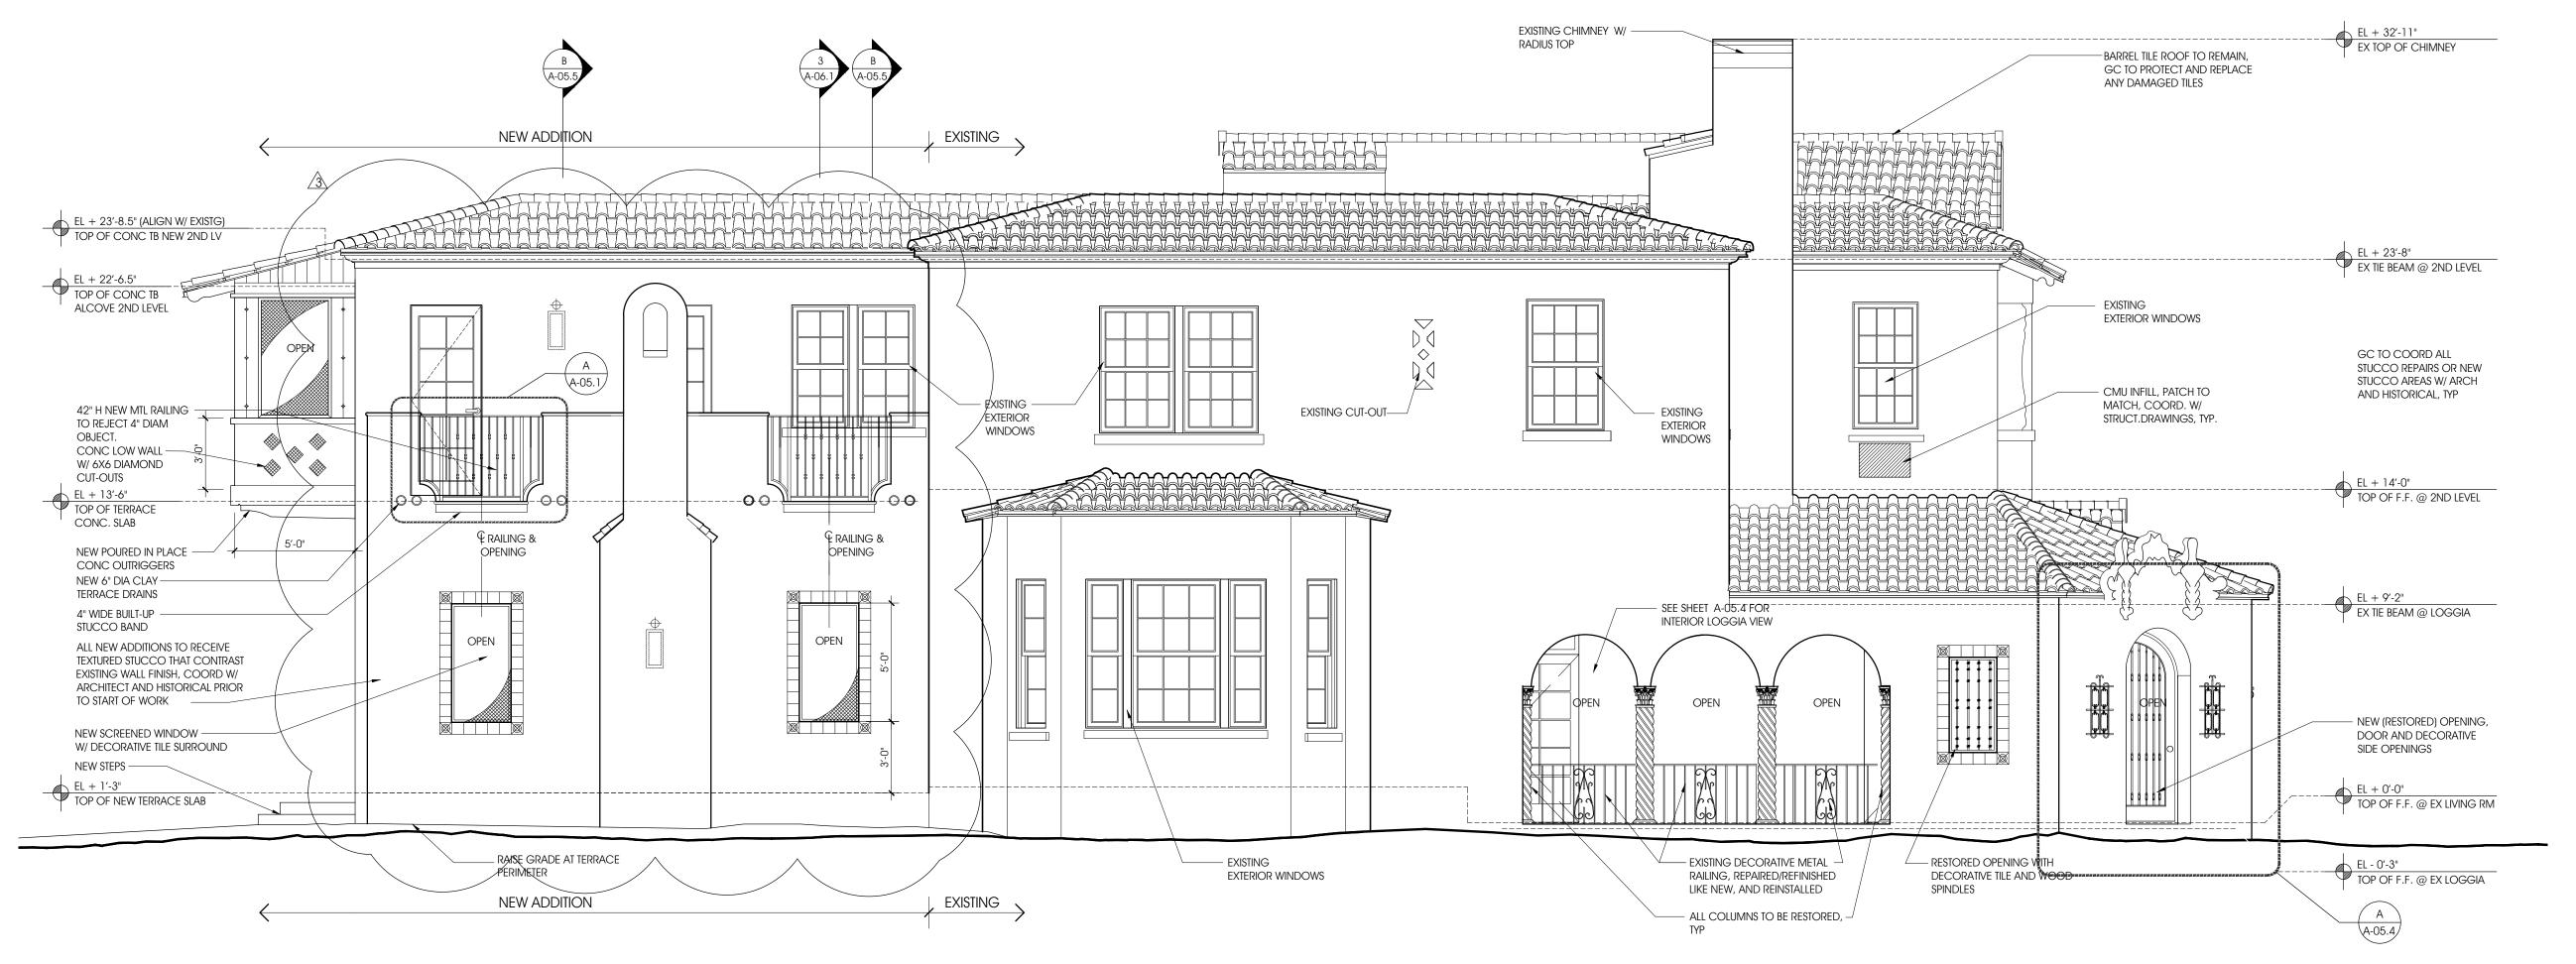

## PROPOSED SIDE ELEVATION (EAST)

#### Locus ARCHITECTURE INCORPORATED

500 South Dixie Highway, Suite 307 Coral Gables, Florida 33146 Tel (305) 740-0120 Email: locus@locusarchitecture.net

CONSULTANT(S)

NO.	REVISION/SUBMISSION	DATE
	REVIEW	01-13-25
	COA HISTORICAL SUBM (MASTER PLAN)	02-06-23
	PERMIT SUBMITTAL	10-28-23
	BOA SUBMITTAL	02-08-24
	COA SUBMITTAL	04-17-24
2	CITY COMMENTS	07-08-24
	BOA RESUBMITTAL	10-16-24
	BOA RESUBMITTAL	12-14-24
<u>/</u> 3\	OWNER REVISIONS	01-27-25

**PROJECT** 

Historical: Remodel & Additions Soane Residence

1104 Malaga Avenue Coral Gables, FL 33134

DRAWING

Existing, Demolition and Proposed Side Elevation (East)

DRAWN

REVIEWED


NDL

326.02



AR 13937 SHEET NO.

A-05.2

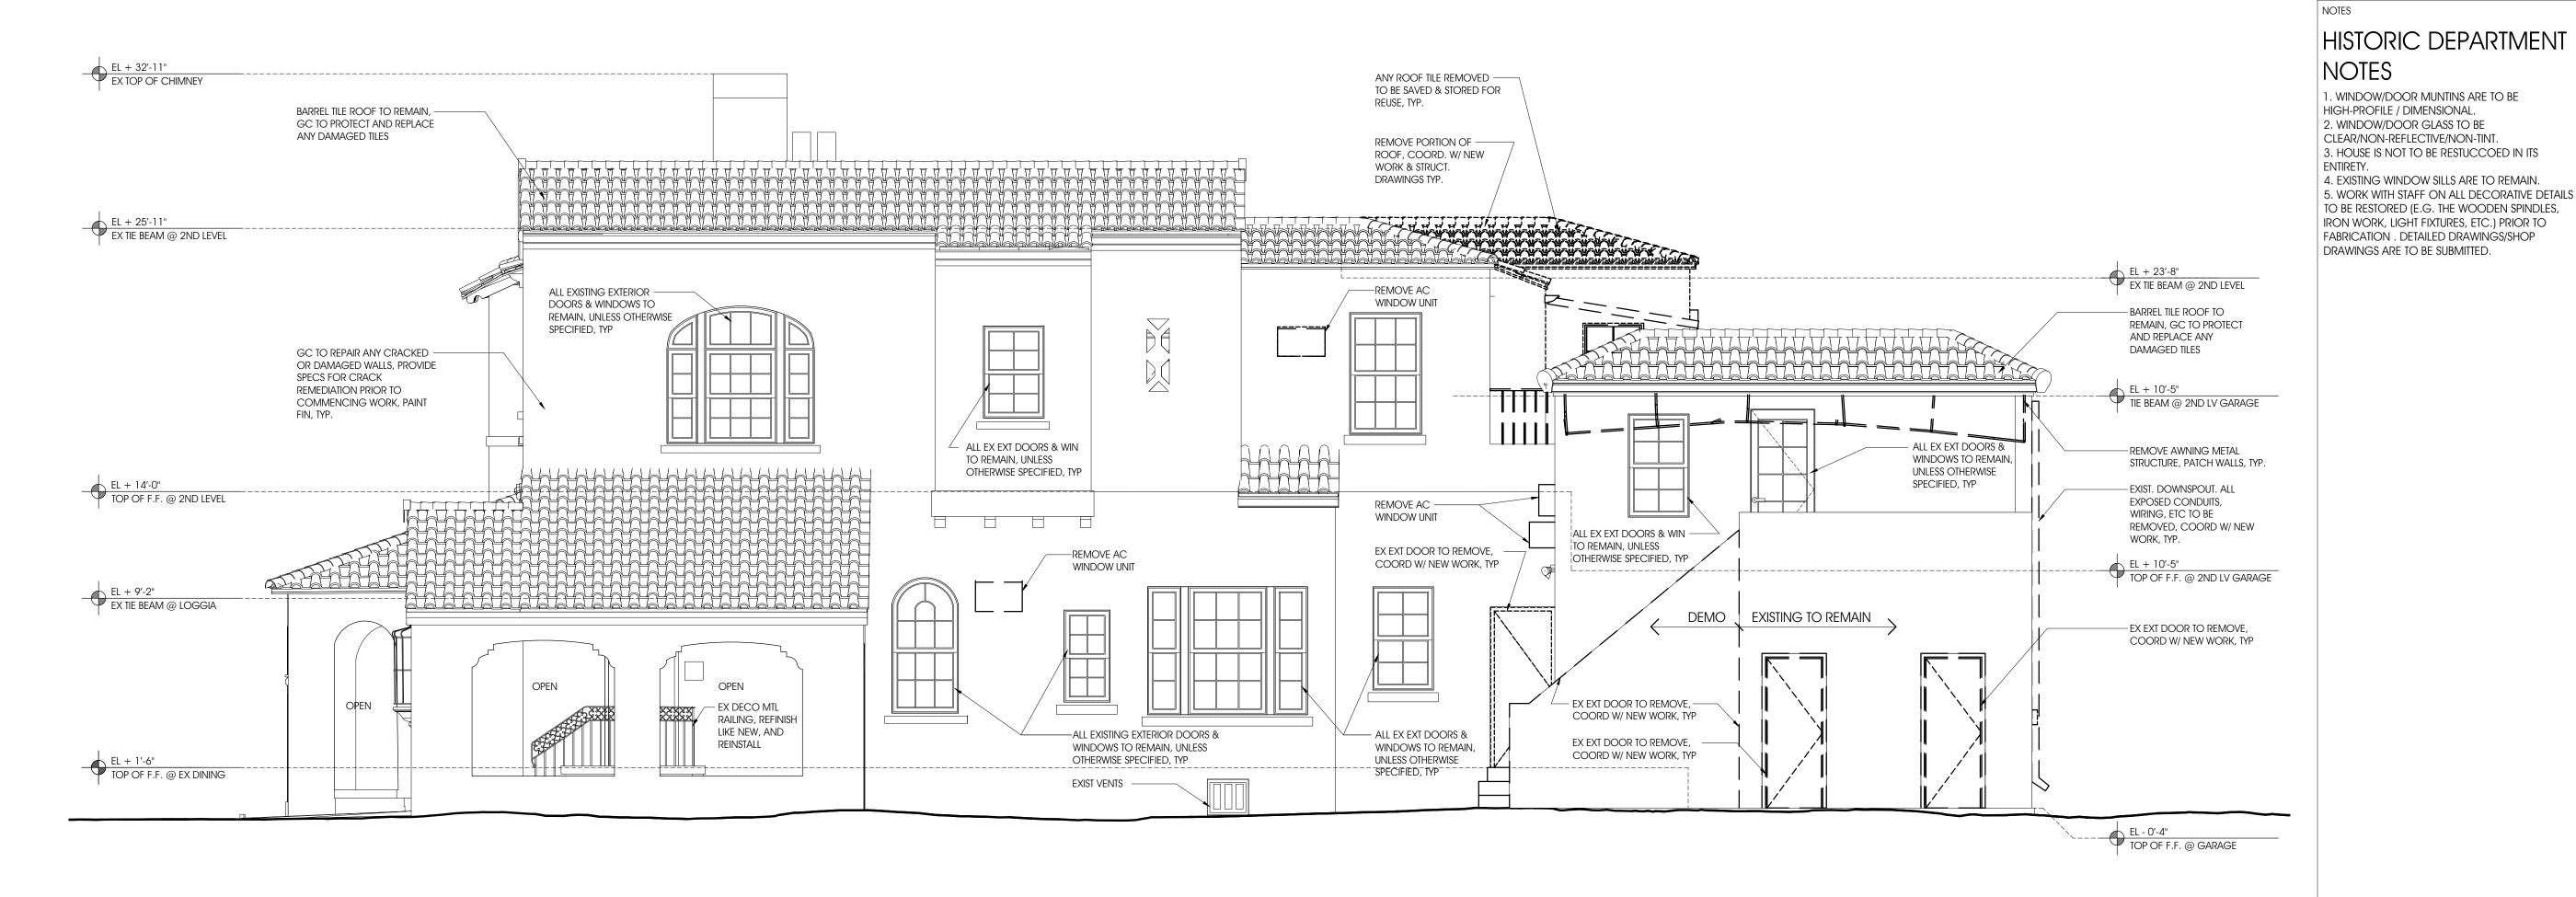

## EXISTING AND DEMOLITION SIDE ELEVATION (WEST)

DATE

01-13-25

02-06-23

10-28-23

02-08-24

04-17-24

07-08-24

10-16-24

12-14-24

01-27-25


DRAWN


REVIEWED


PROJ. NO.

326.02

NDL

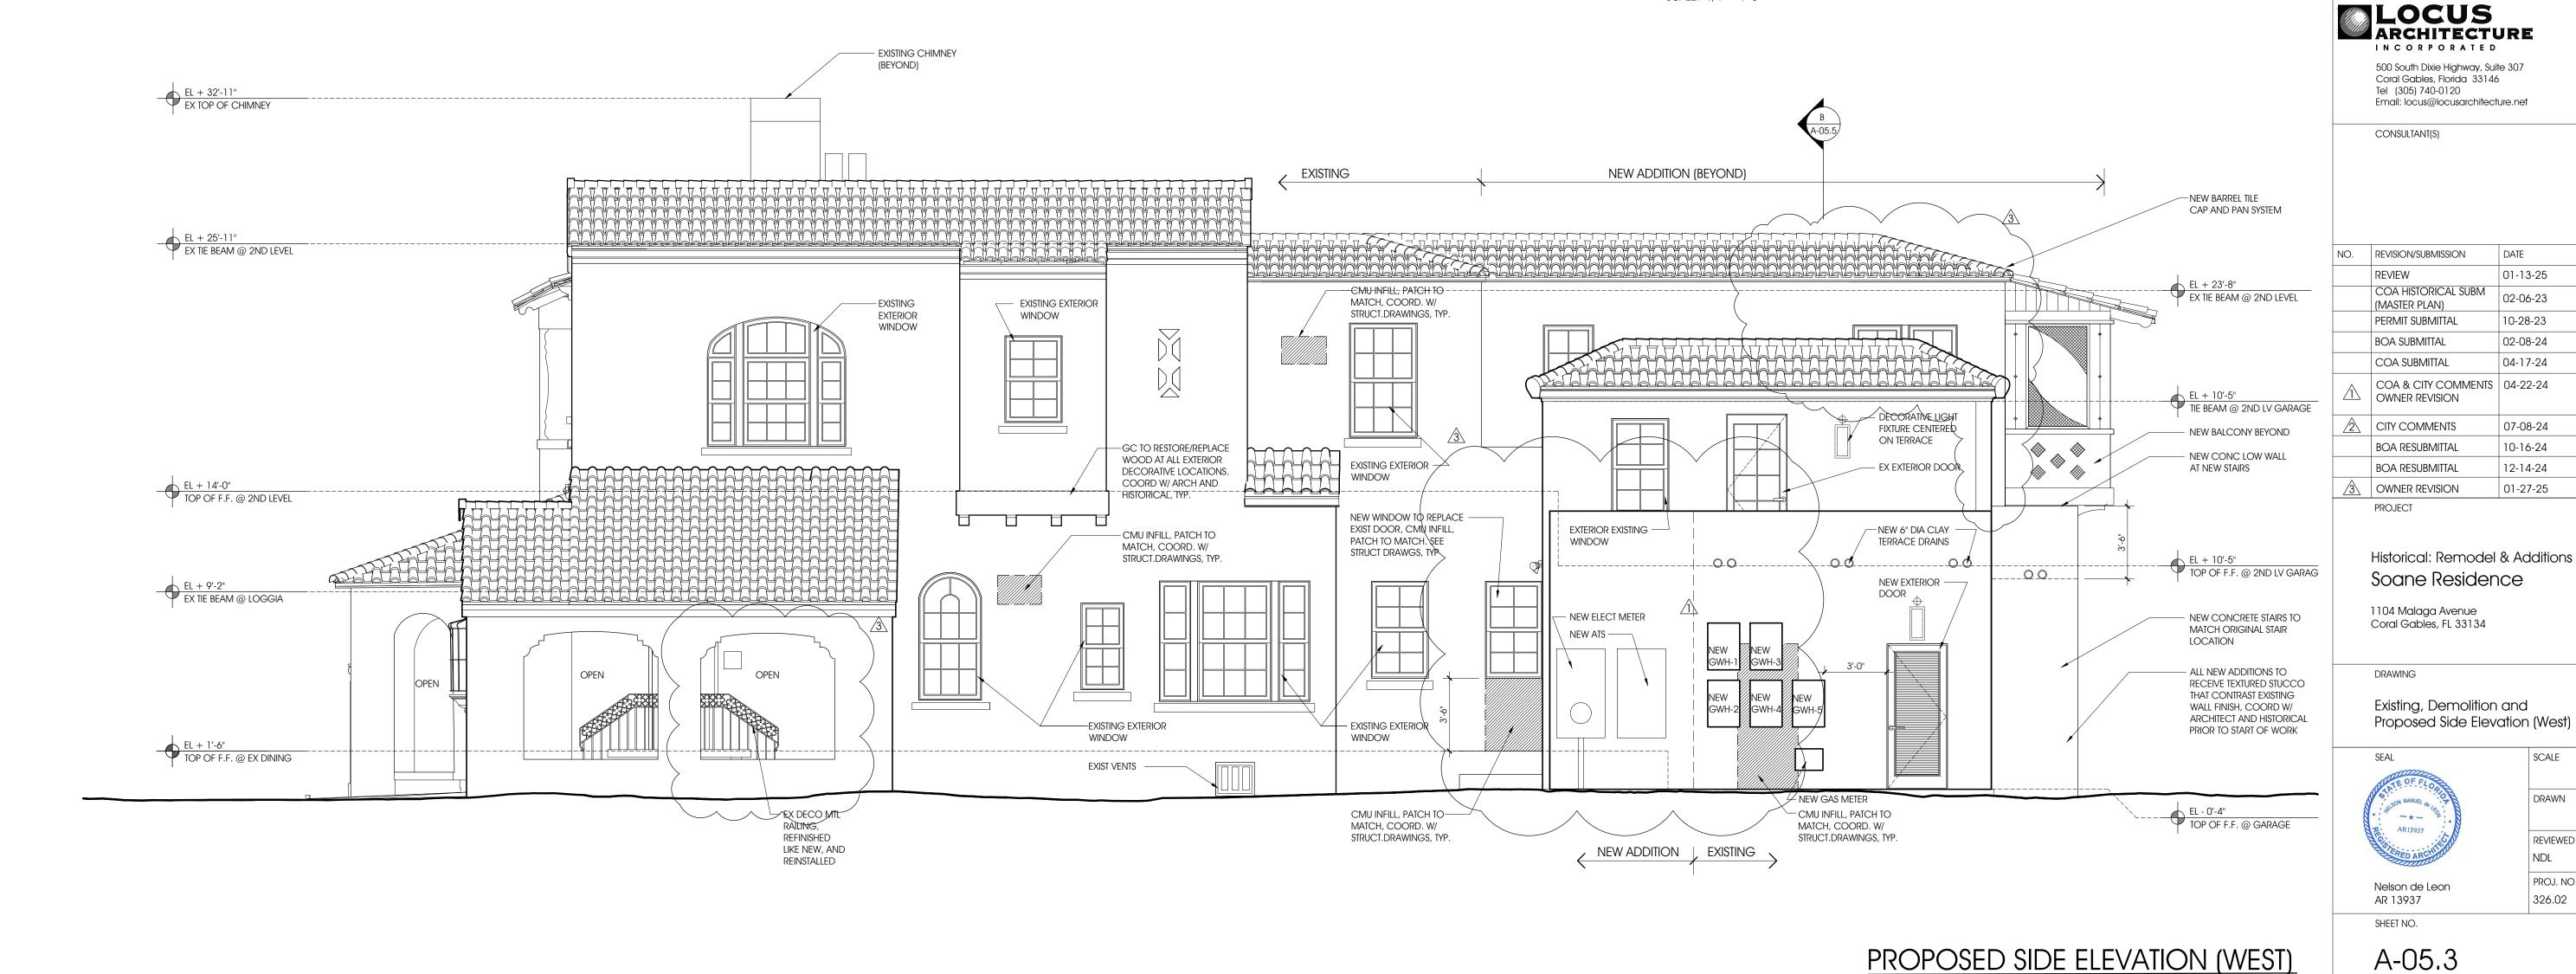


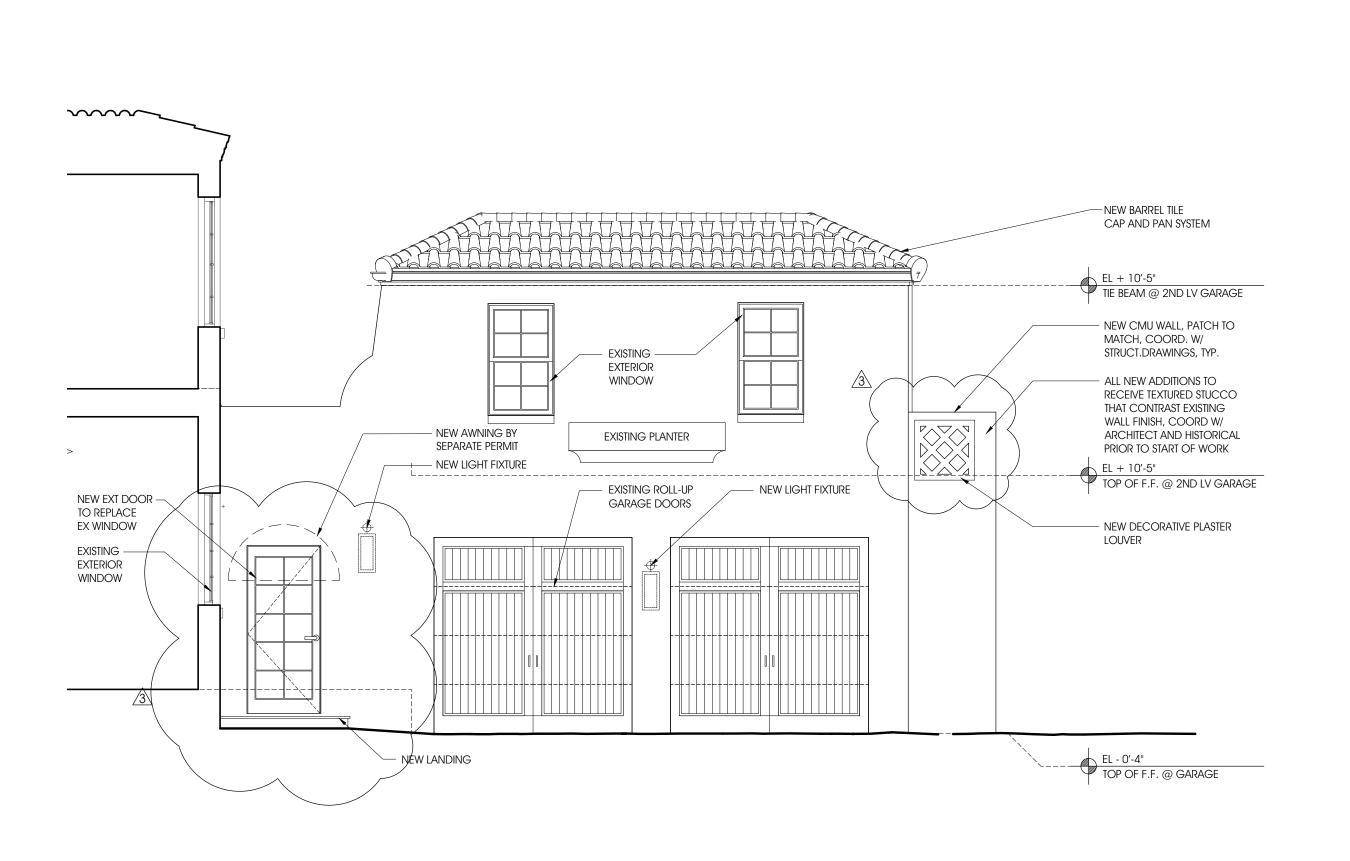

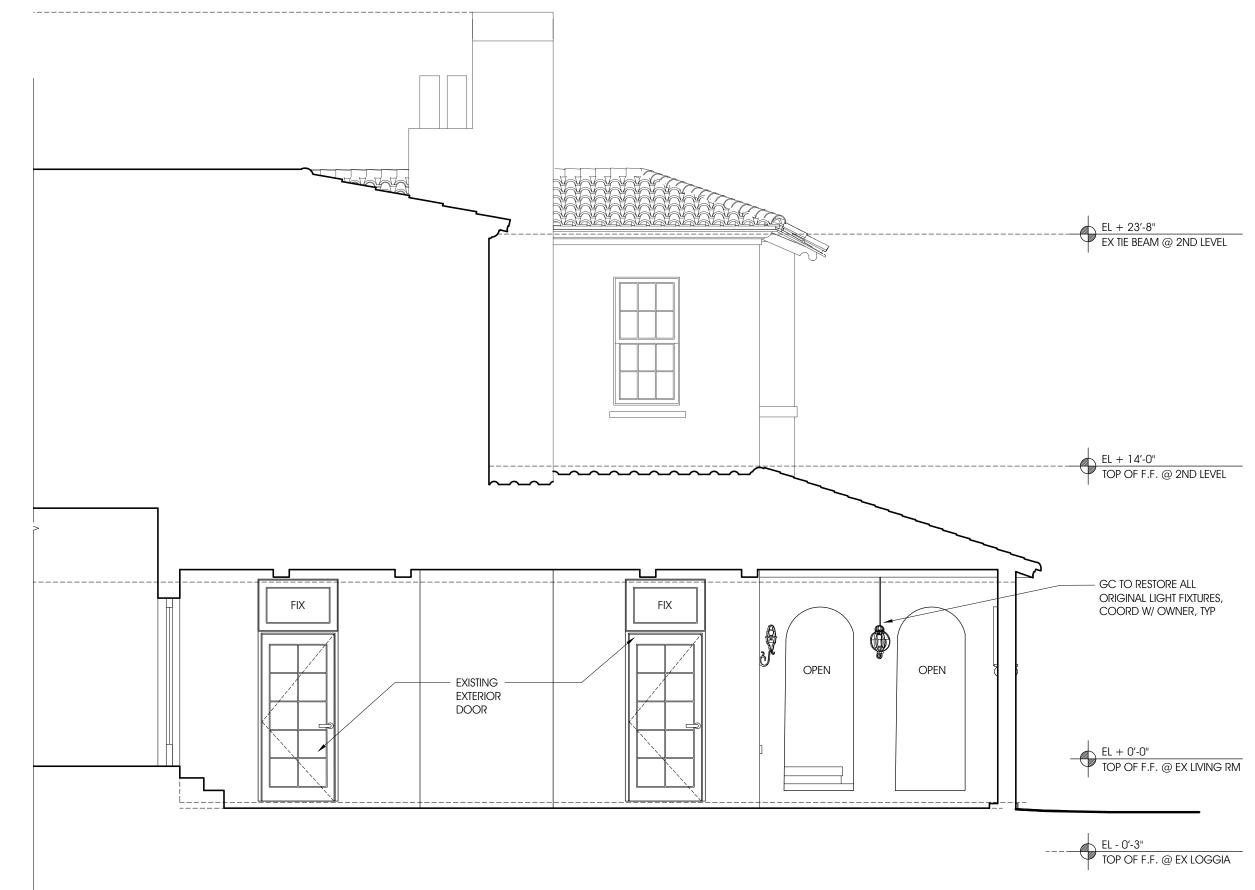

### PROPOSED GARAGE ELEVATION

## PROPOSED LOGGIA ELEVATION 02

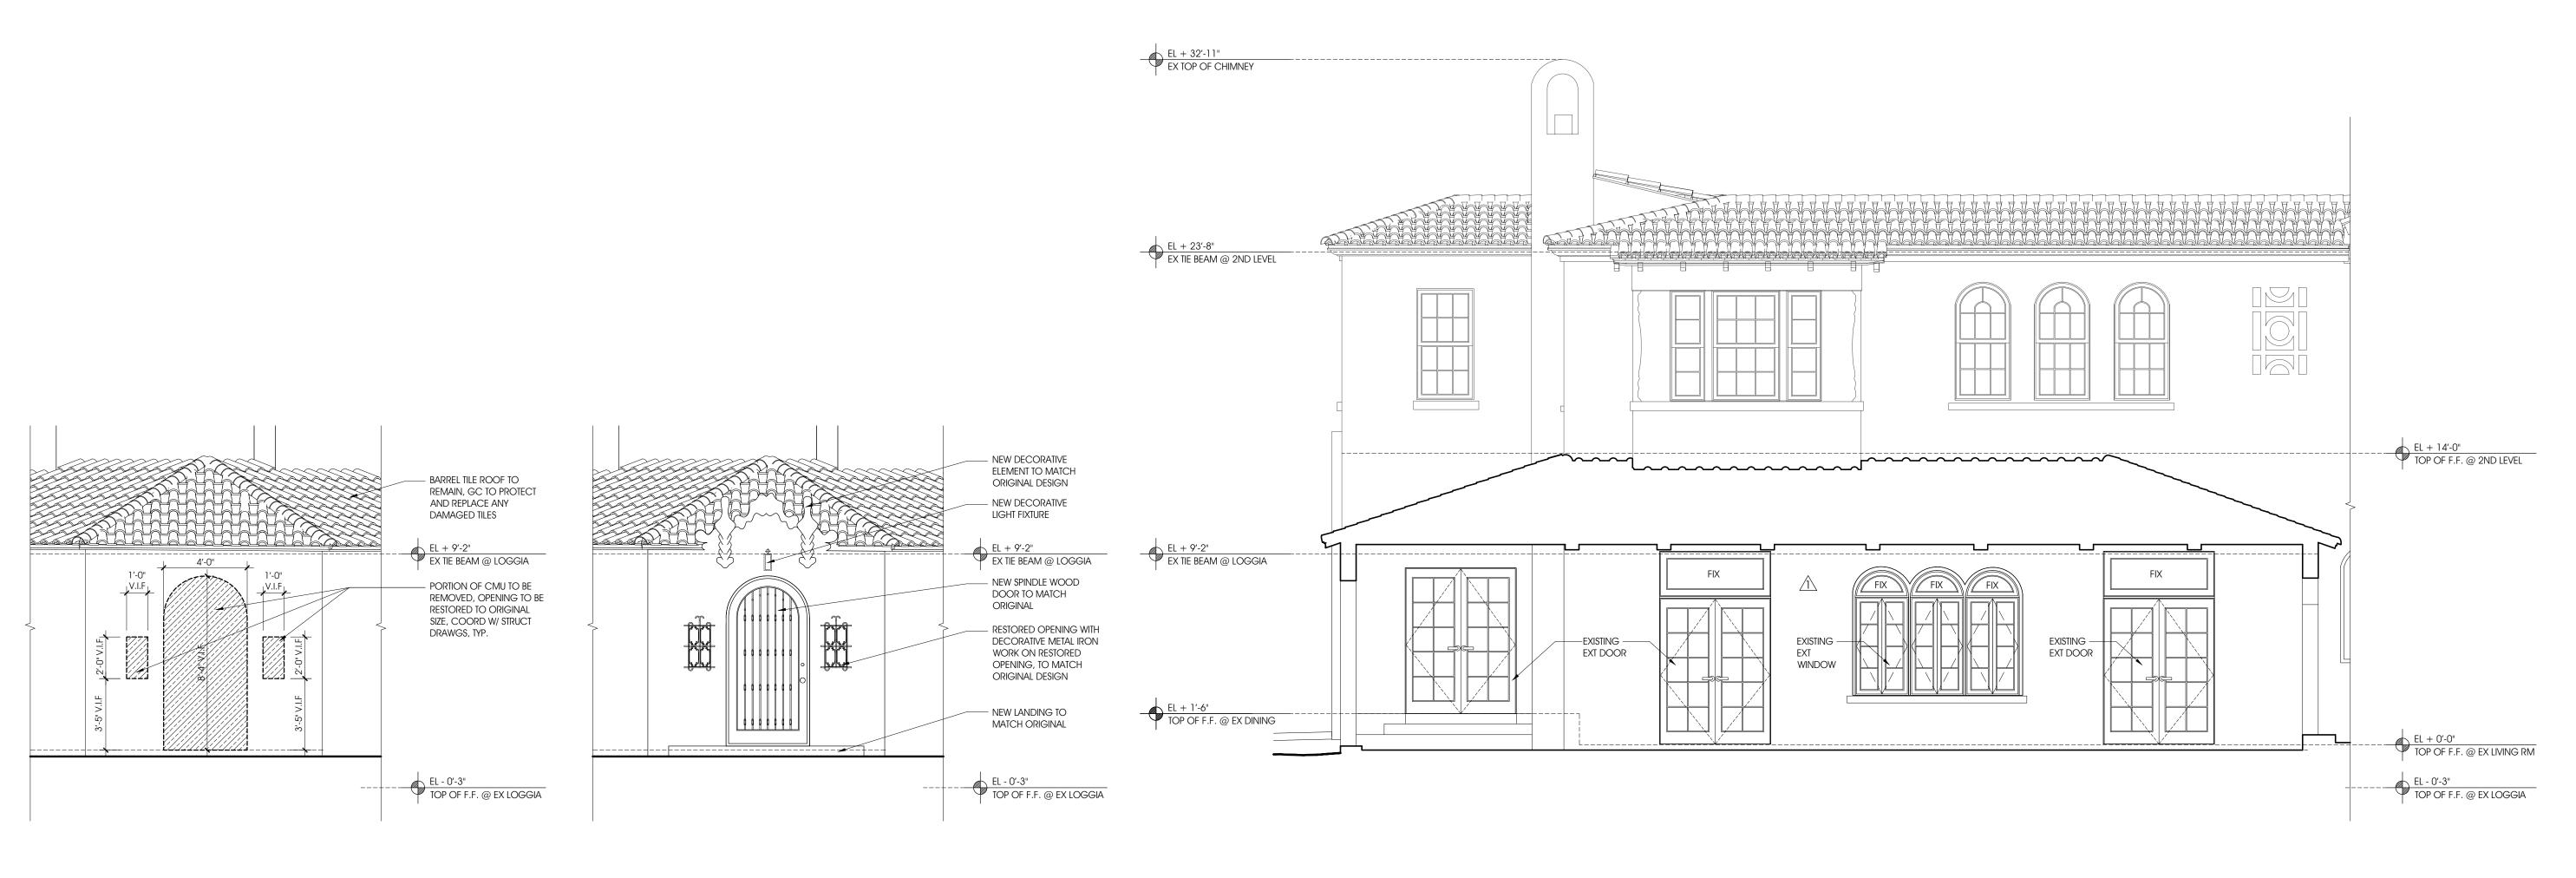

LOGGIA CORNER DETAIL

SCALE: 1/4" = 1'-0"

PROPOSED LOGGIA ELEVATION 01

HISTORIC DEPARTMENT

NOTES 1. WINDOW/DOOR MUNTINS ARE TO BE HIGH-PROFILE / DIMENSIONAL. 2. WINDOW/DOOR GLASS TO BE CLEAR/NON-REFLECTIVE/NON-TINT. 3. HOUSE IS NOT TO BE RESTUCCOED IN ITS

4. EXISTING WINDOW SILLS ARE TO REMAIN. 5. WORK WITH STAFF ON ALL DECORATIVE DETAILS TO BE RESTORED (E.G. THE WOODEN SPINDLES, IRON WORK, LIGHT FIXTURES, ETC.) PRIOR TO

FABRICATION . DETAILED DRAWINGS/SHOP

DRAWINGS ARE TO BE SUBMITTED.

LOCUS INCORPORATED 500 South Dixie Highway, Suite 307

Tel (305) 740-0120

Coral Gables, Florida 33146

Email: locus@locusarchitecture.net

CONSULTANT(S)

NO. REVISION/SUBMISSION DATE 01-13-25 REVIEW COA HISTORICAL SUBM 02-06-23 (MASTER PLAN) PERMIT SUBMITTAL 10-28-23 BOA SUBMITTAL 02-08-24 04-17-24 COA SUBMITTAL COA & CITY COMMENTS | 04-22-24 OWNER REVISION CITY COMMENTS 07-08-24 OWNER REVISION 01-27-25

PROJECT

Historical: Remodel & Additions Soane Residence

1104 Malaga Avenue Coral Gables, FL 33134

DRAWING

Proposed Partial Elevations (Loggia and Garage)



REVIEWED NDL PROJ. NO. Nelson de Leon 326.02 AR 13937


DRAWN


SHEET NO.

A-05.4

LOGGIA CORNER DEMO DETAIL


SCALE: 1/4" = 1'-0"

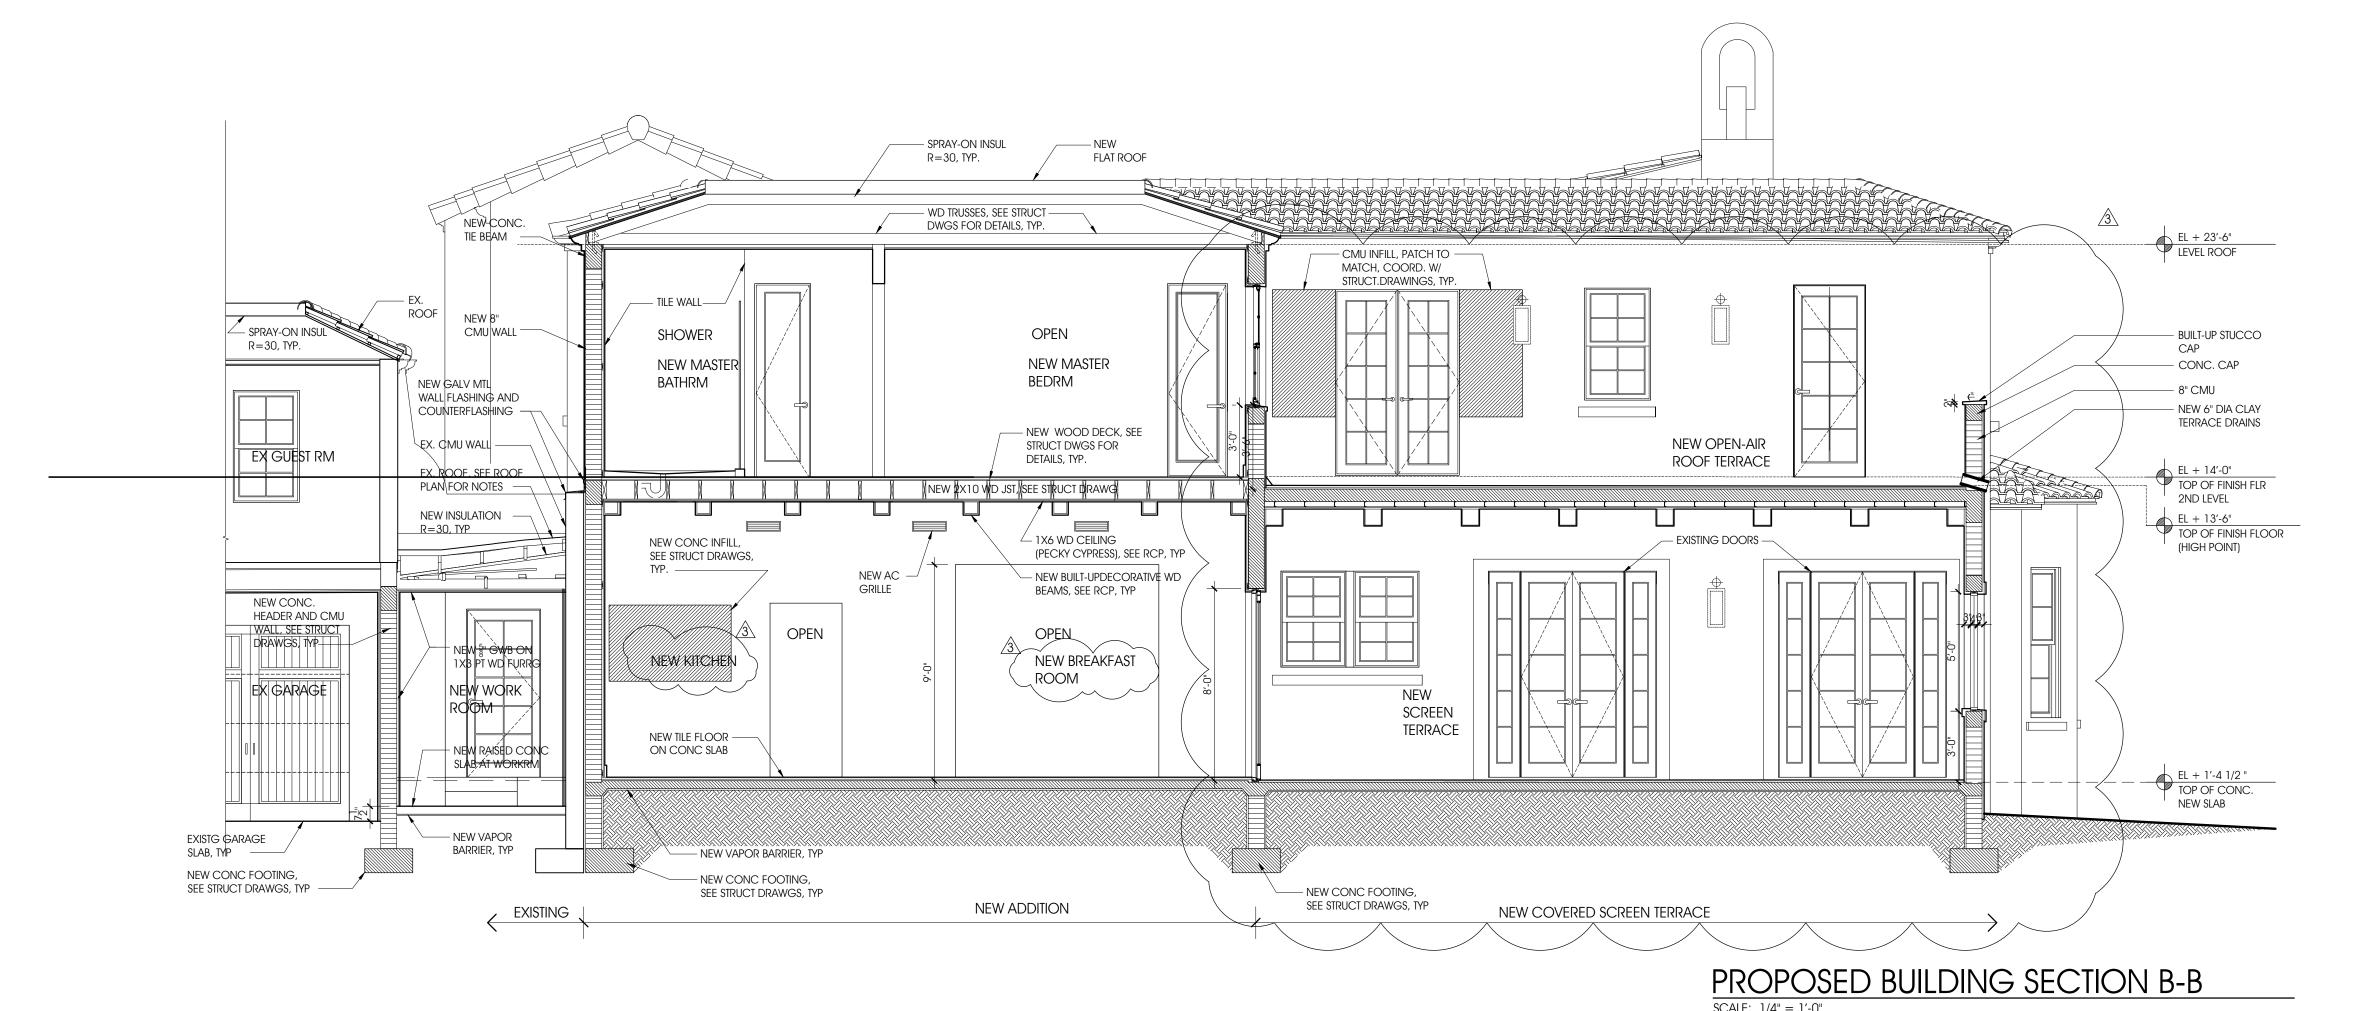

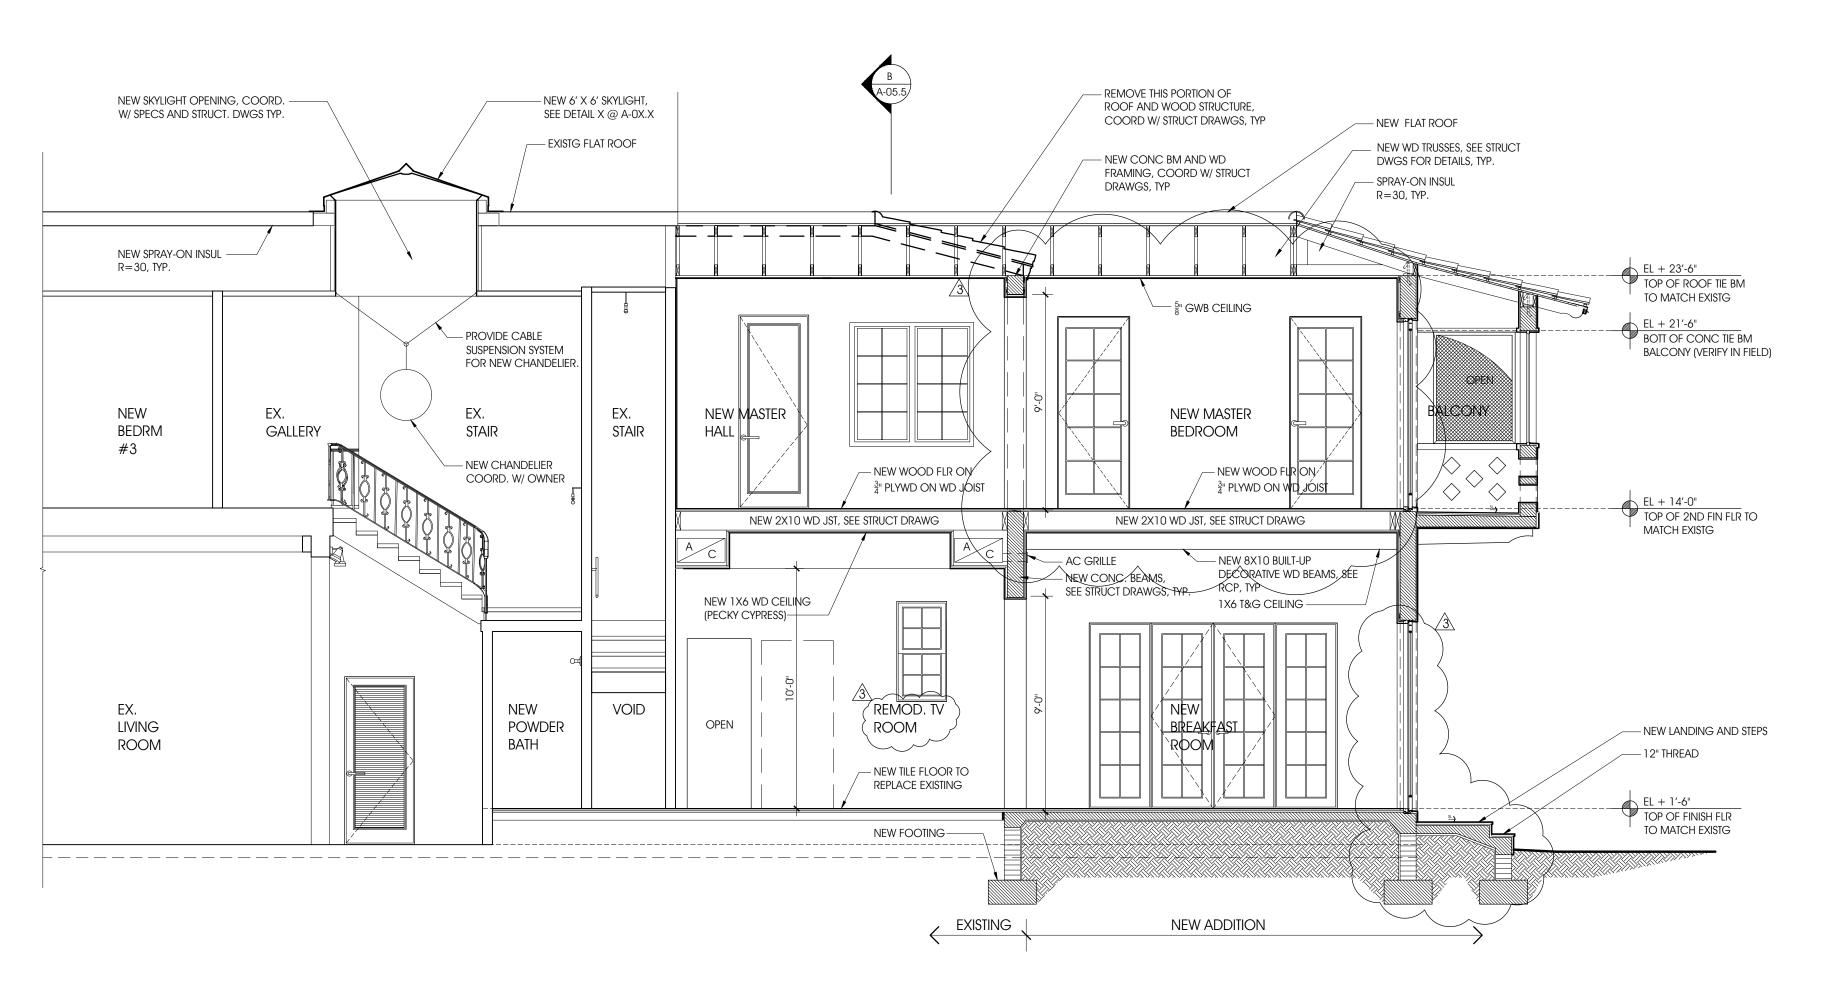



PROPOSED BUILDING SECTION A-A


SCALE: 1/4" = 1'-0"

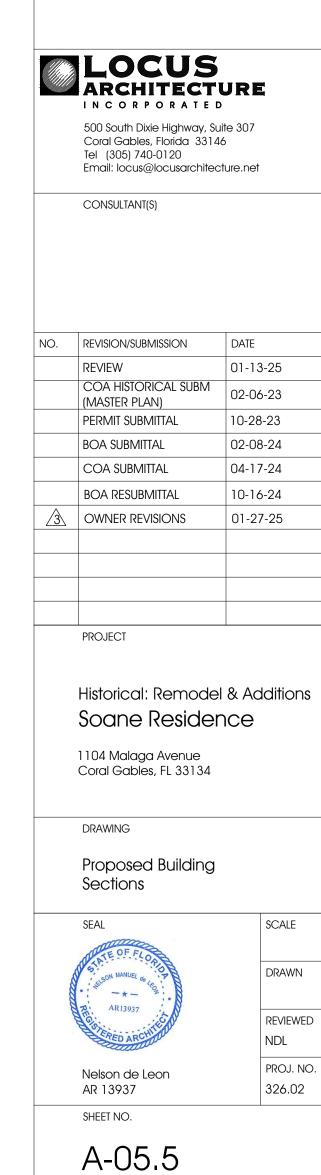

NOTES

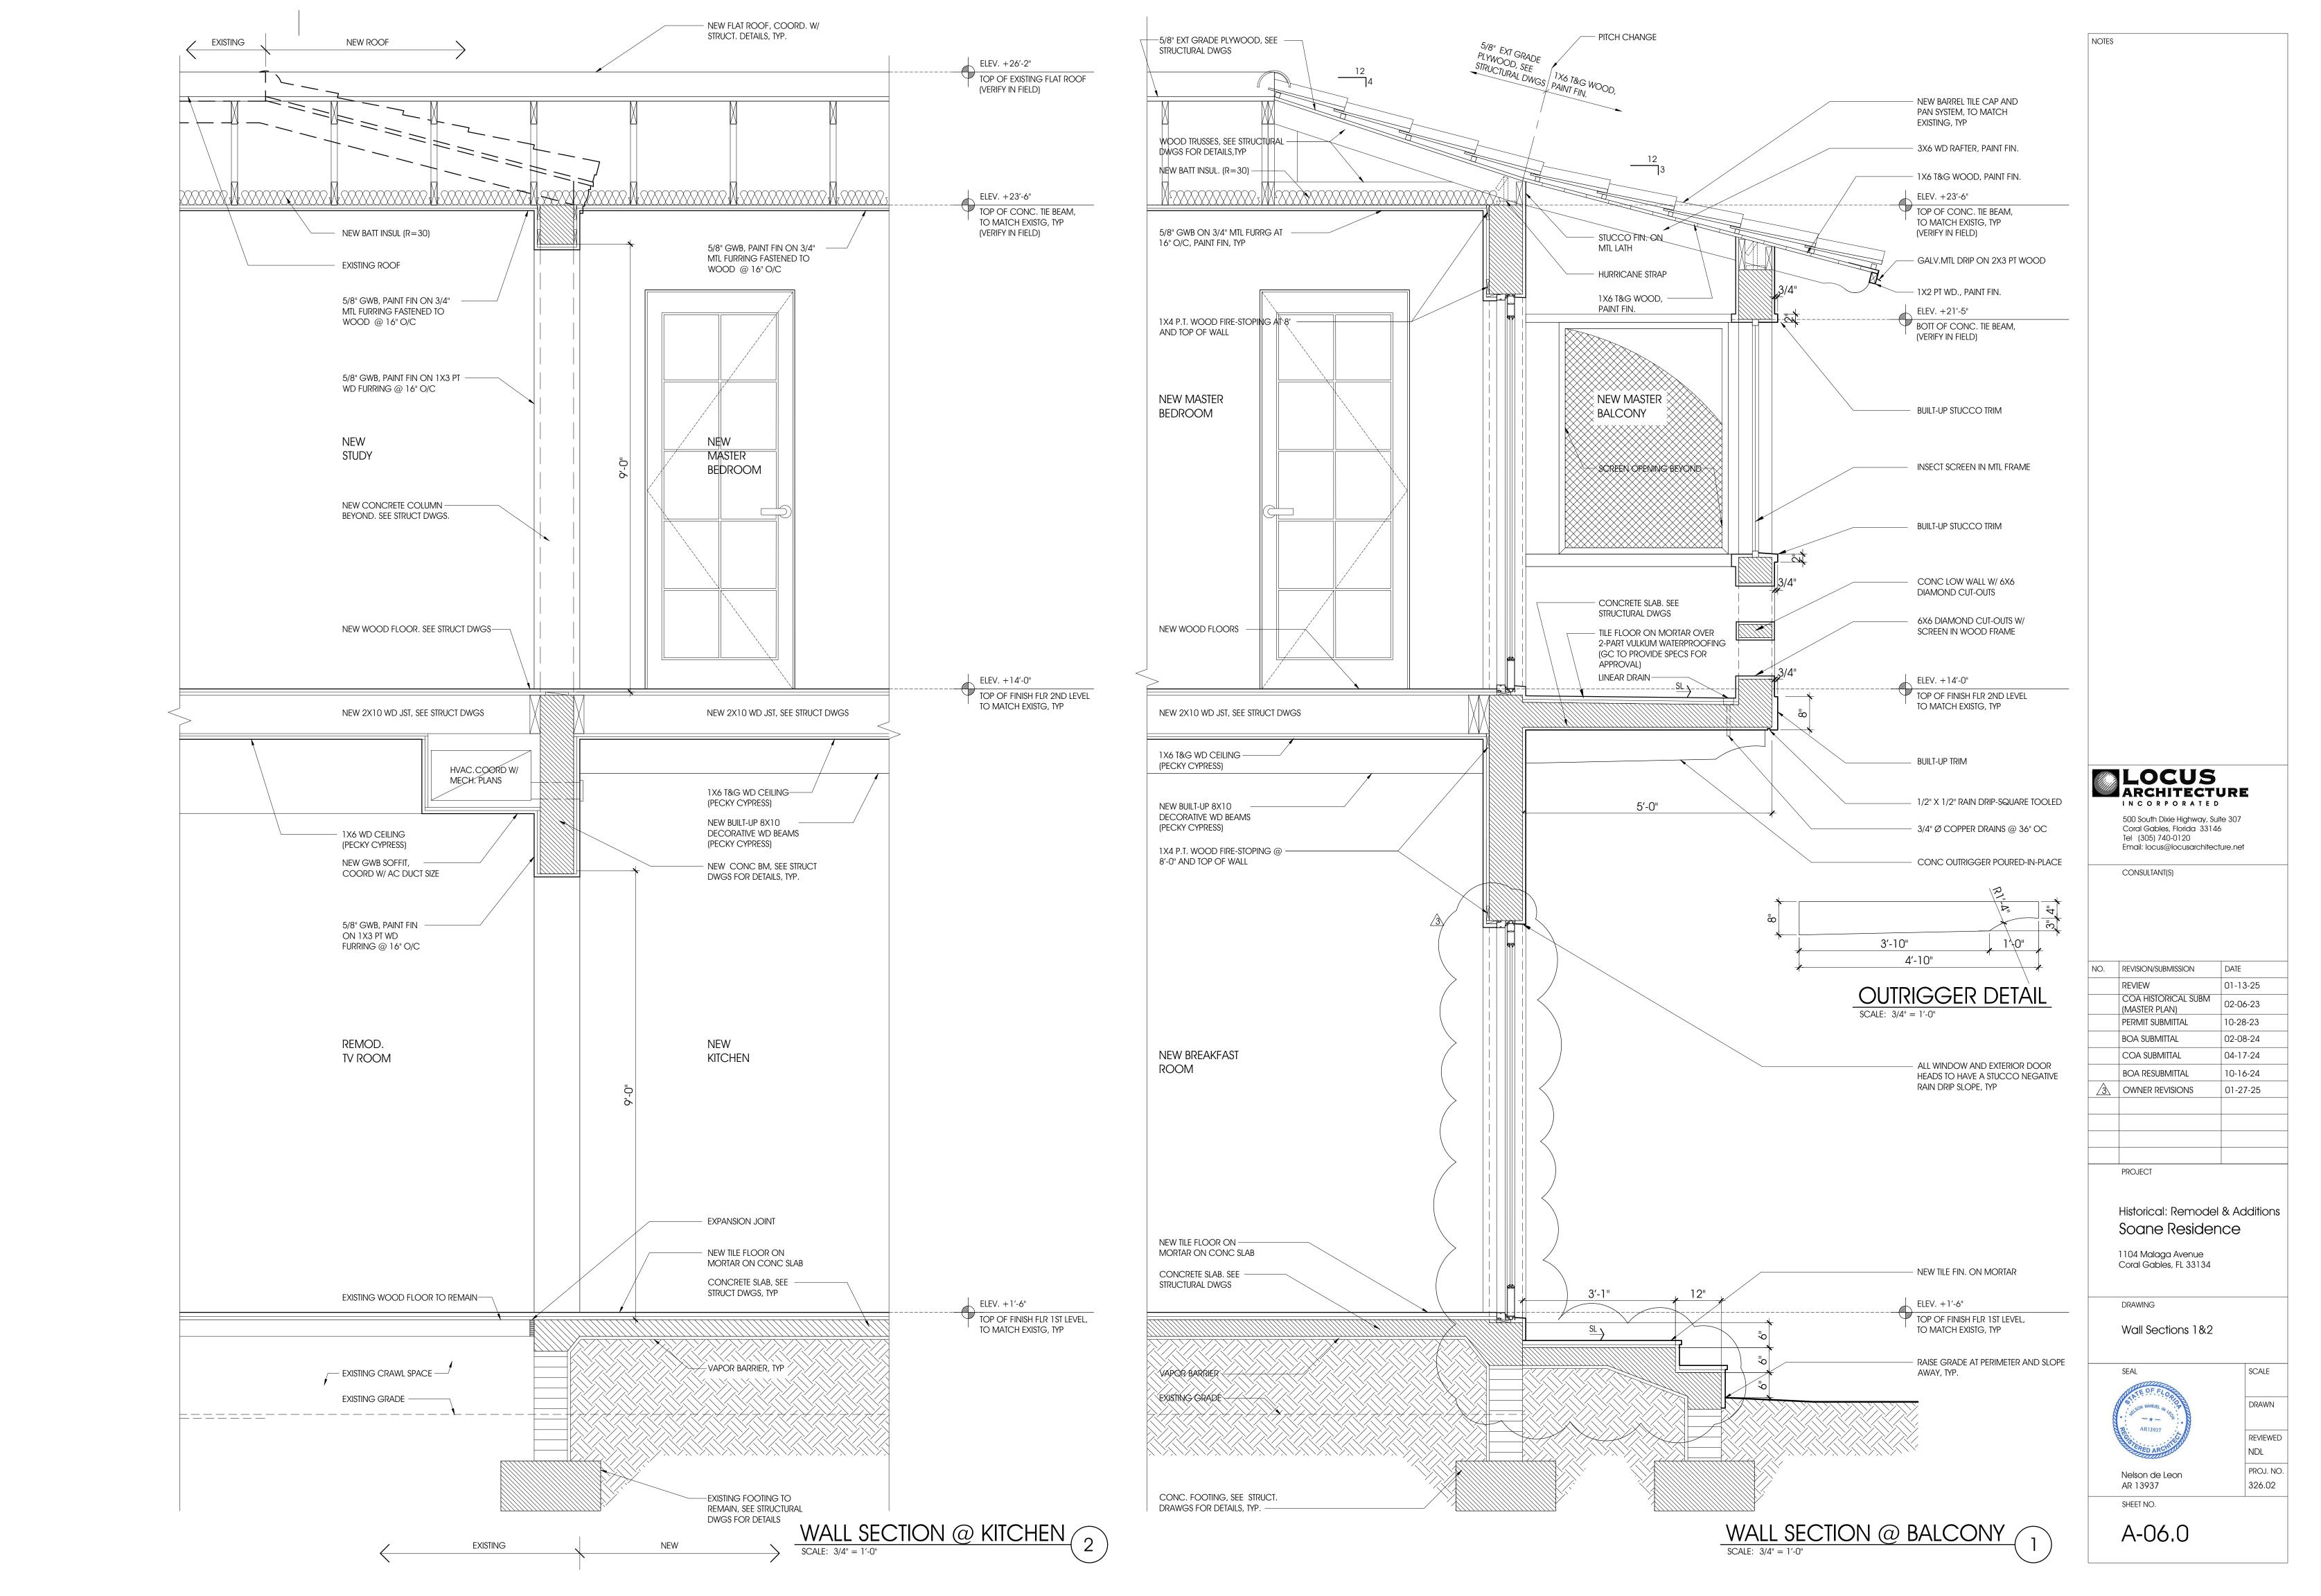

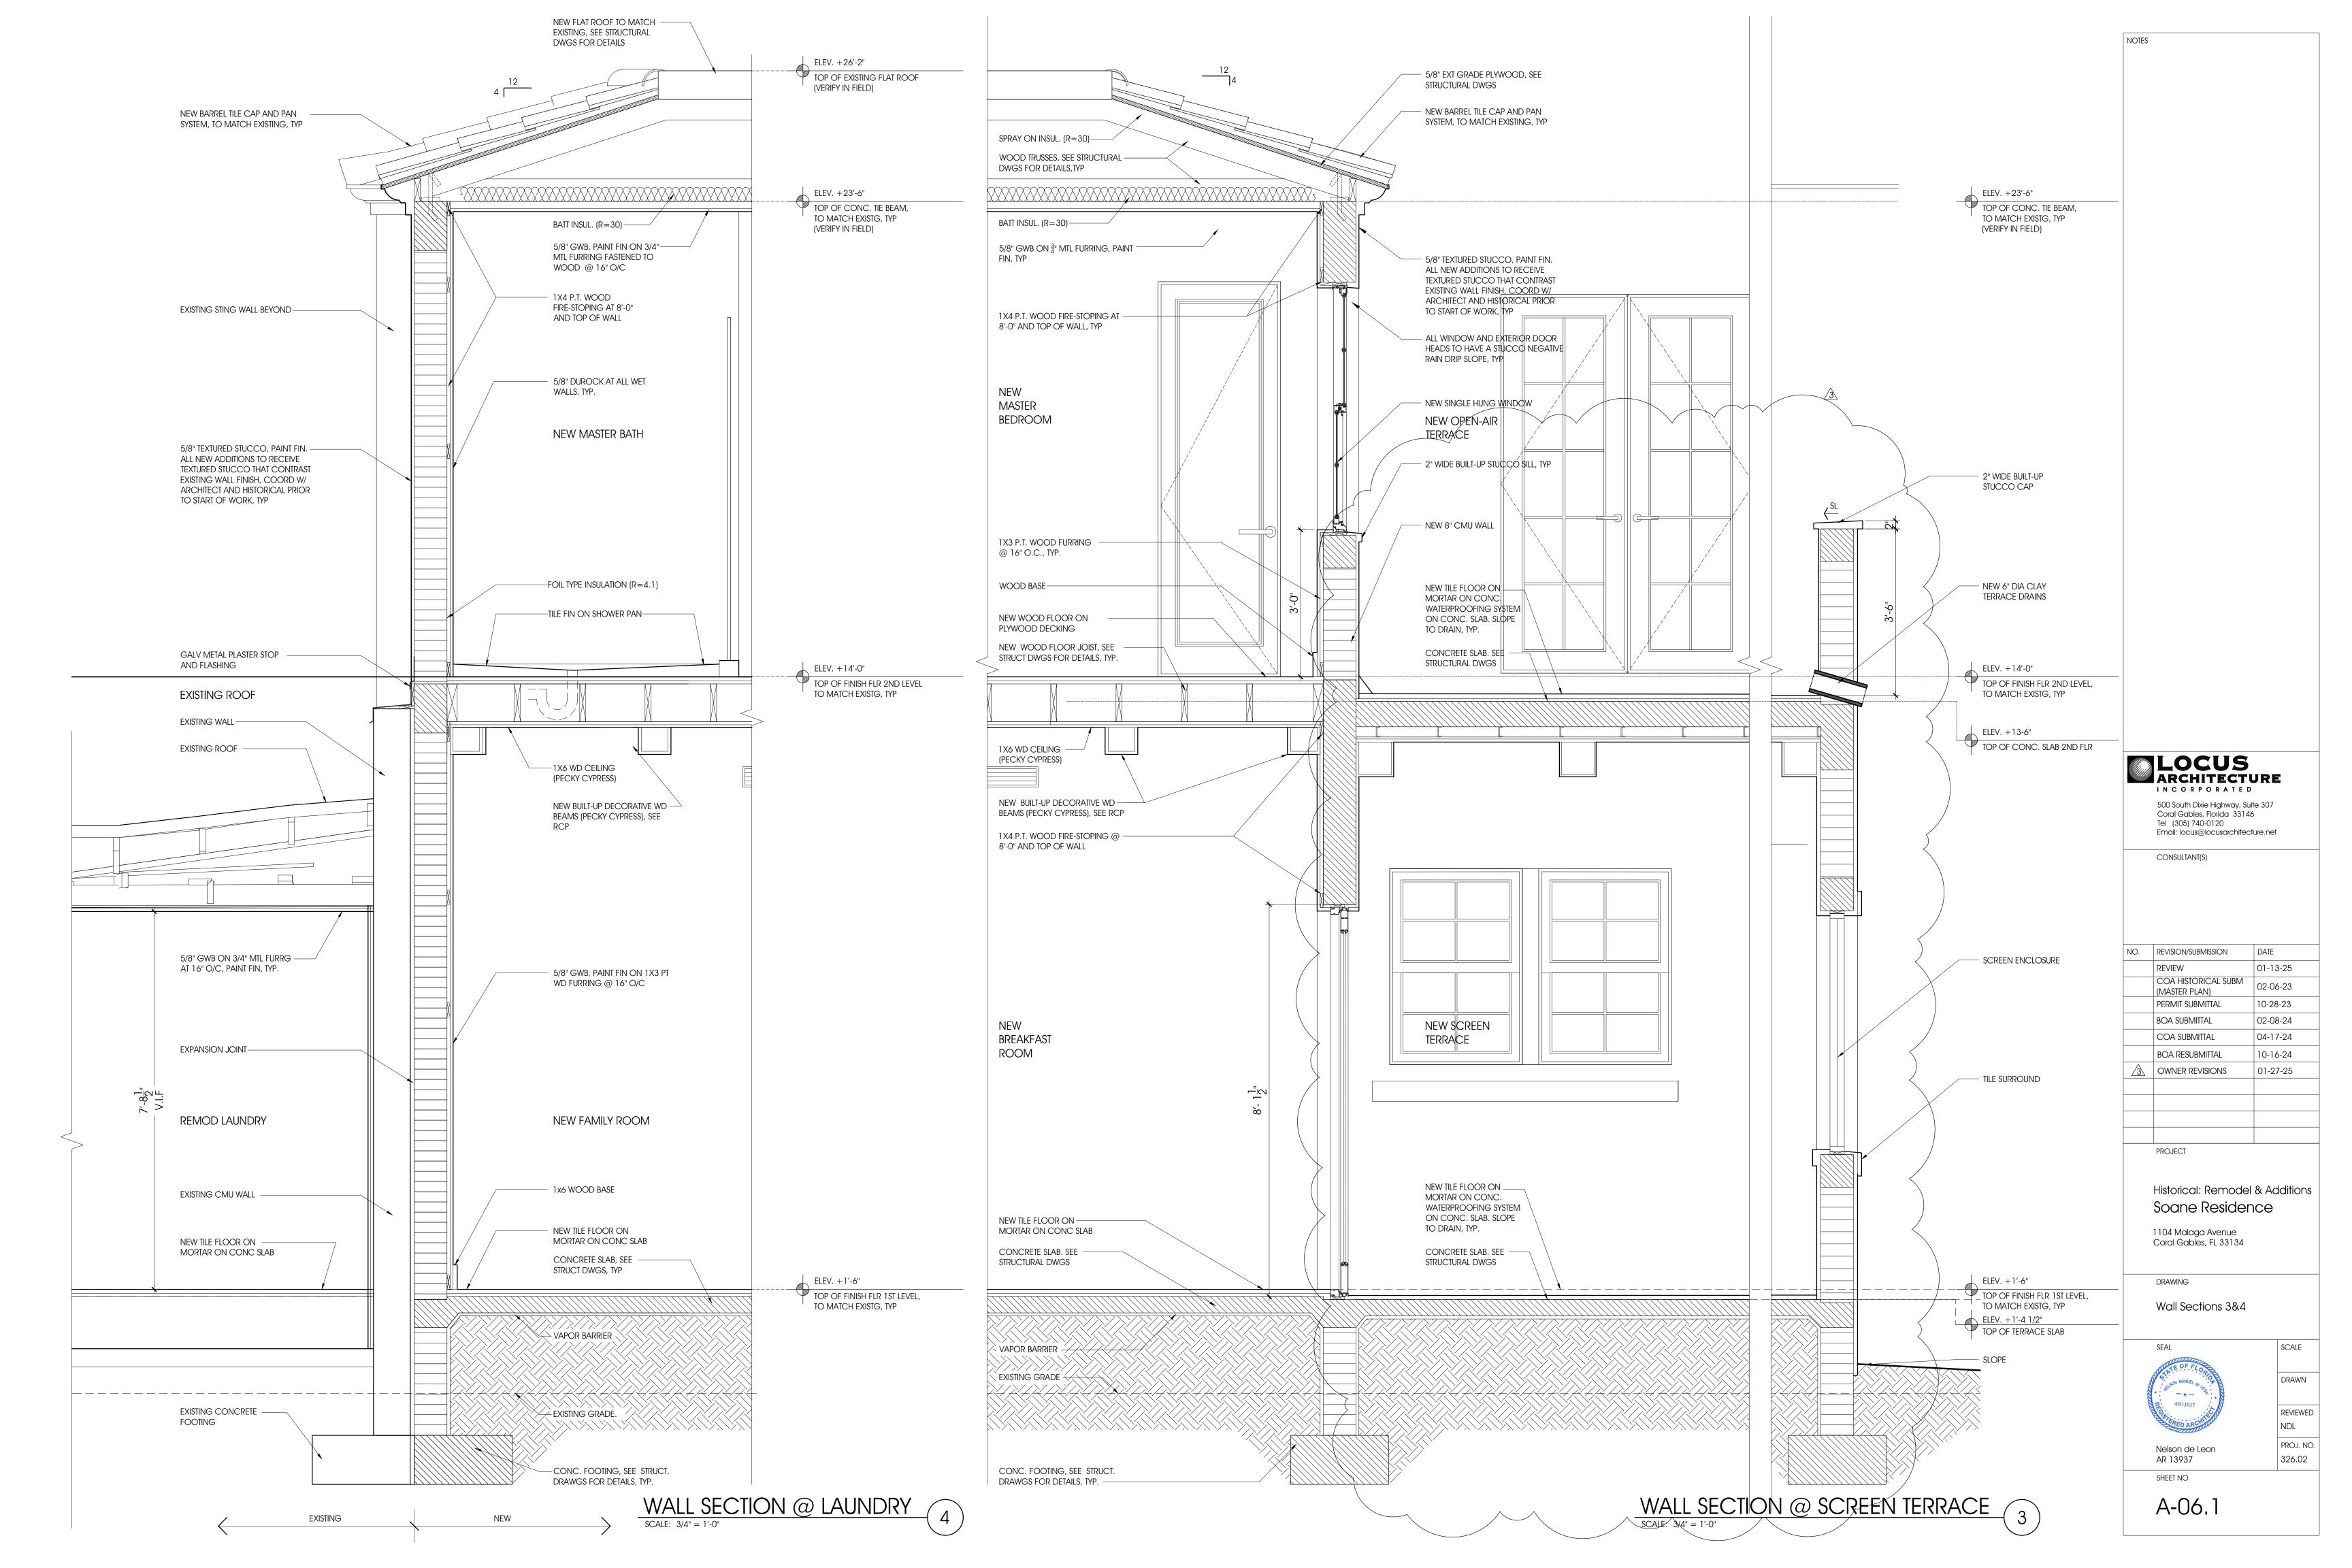

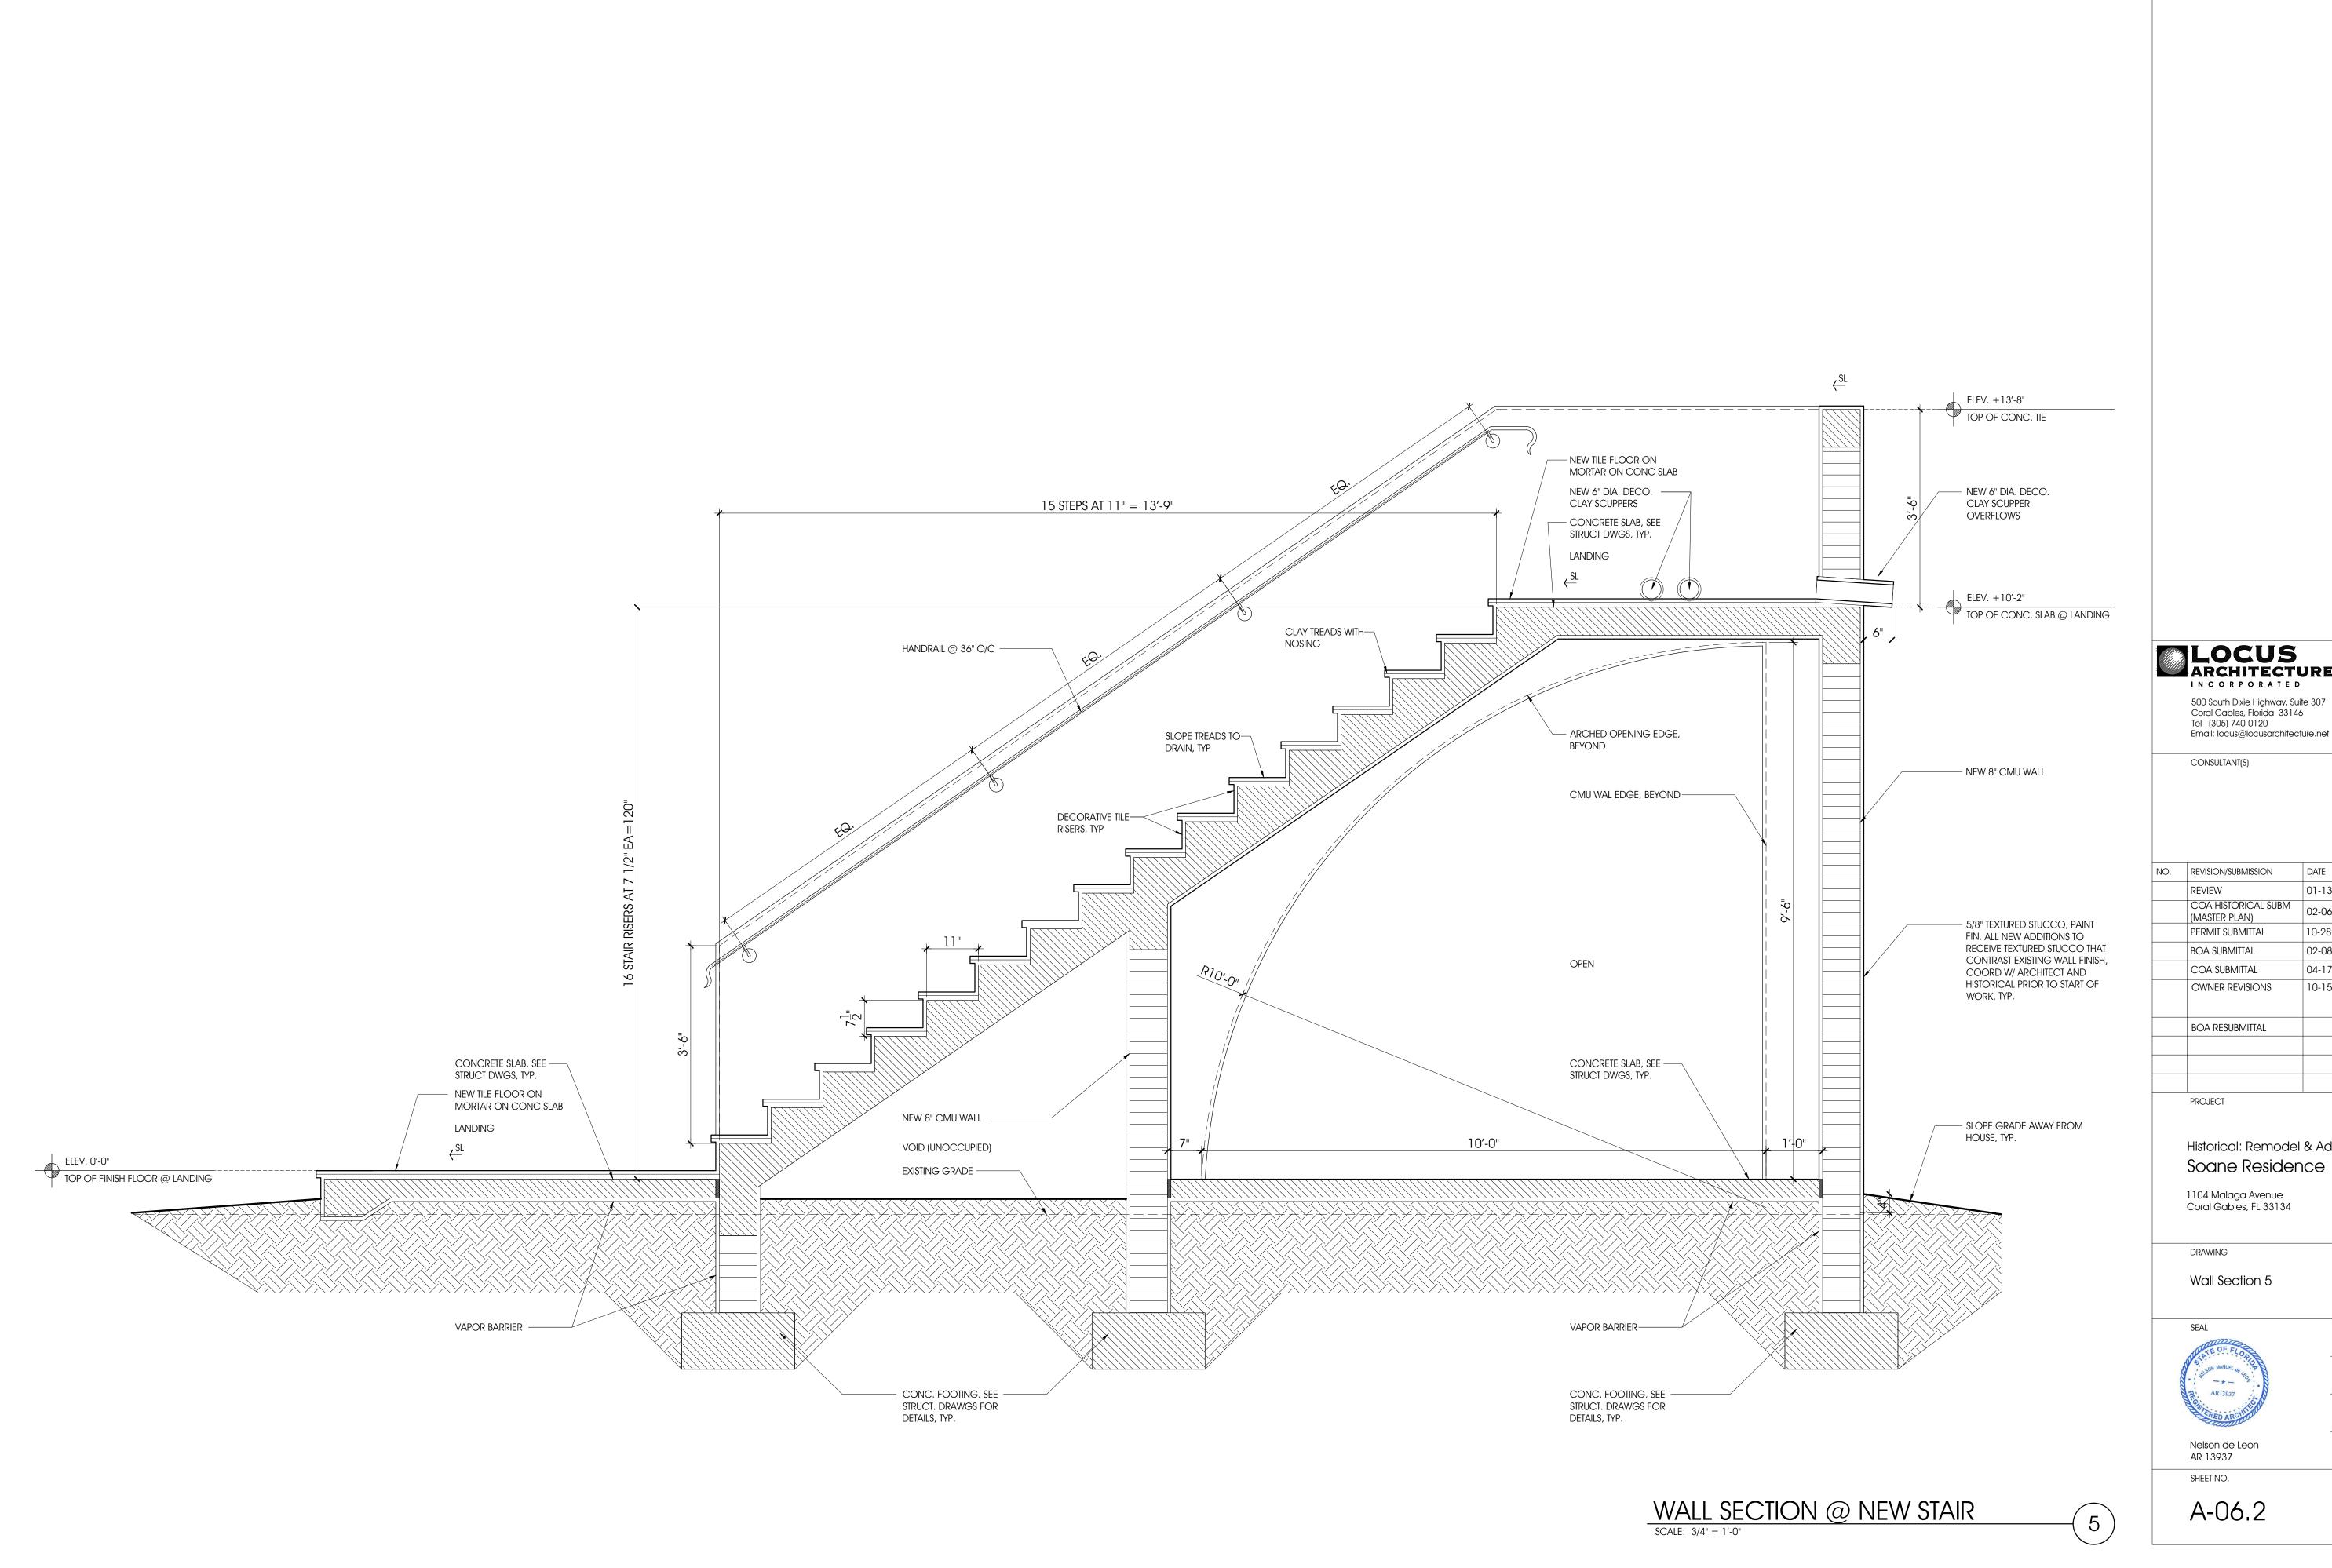


LOCUS


NOTES


Tel (305) 740-0120 Email: locus@locusarchitecture.net

NO.	REVISION/SUBMISSION	DATE
	REVIEW	01-13-25
	COA HISTORICAL SUBM (MASTER PLAN)	02-06-23
	PERMIT SUBMITTAL	10-28-23
	BOA SUBMITTAL	02-08-24
	COA SUBMITTAL	04-17-24
	OWNER REVISIONS	10-15-24
	BOA RESUBMITTAL	

Historical: Remodel & Additions Soane Residence

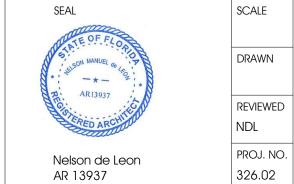

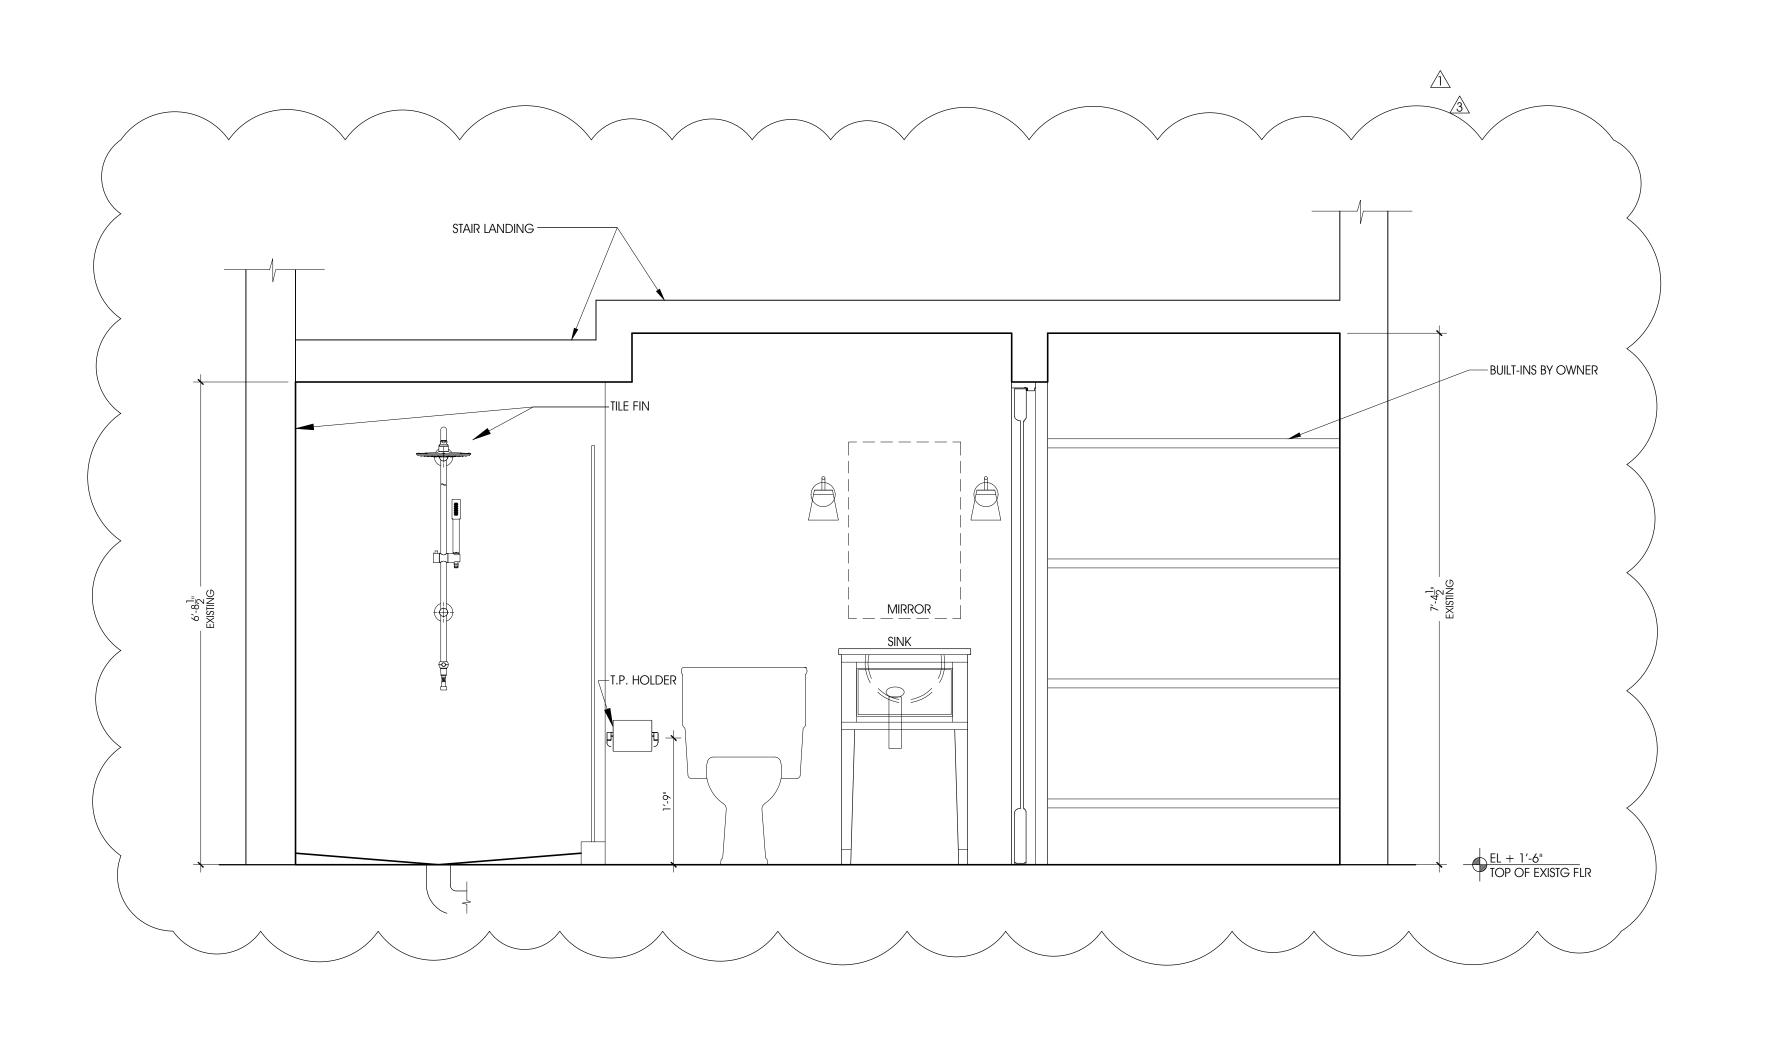

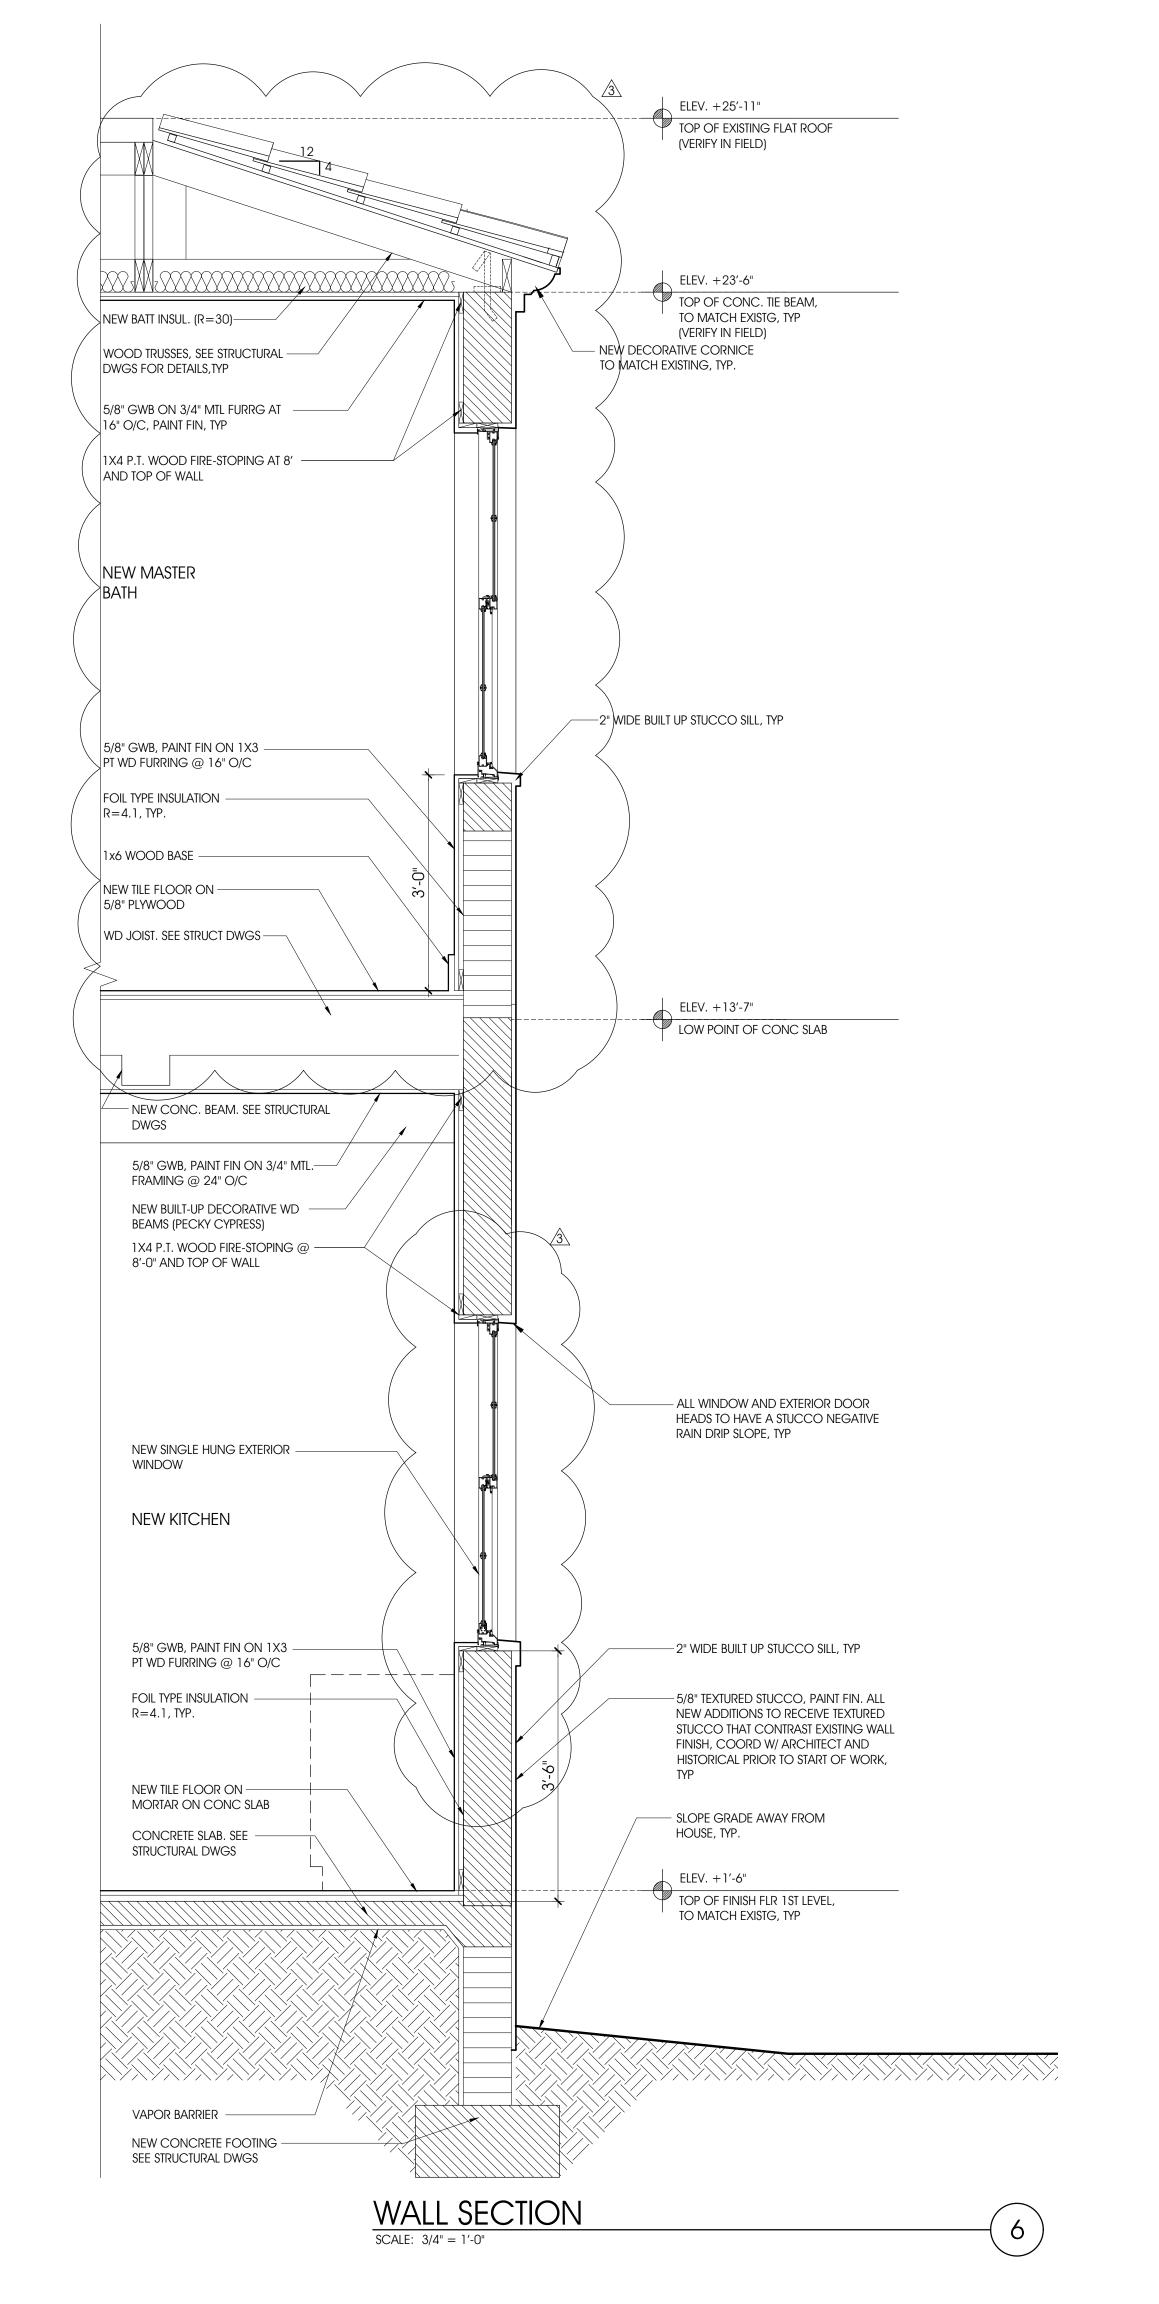



500 South Dixie Highway, Suite 307 Coral Gables, Florida 33146 Tel (305) 740-0120 Email: locus@locusarchitecture.net

CONSULTANT(S)

NOTES

NO.	REVISION/SUBMISSION	DATE
	REVIEW	01-13-25
	COA HISTORICAL SUBM (MASTER PLAN)	02-06-23
	PERMIT SUBMITTAL	10-28-23
	BOA SUBMITTAL	02-08-24
	COA SUBMITTAL	04-17-24
$\triangle$	OWNER REVISION	04-22-24
	BOA RESUBMITTAL	10-16-24
<u>3</u>	OWNER REVISIONS	01-27-25

PROJECT

Historical: Remodel & Additions Soane Residence

SCALE

DRAWN


REVIEWED NDL PROJ. NO.

326.02

1104 Malaga Avenue Coral Gables, FL 33134


DRAWING


Wall Section 6

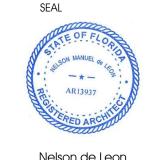

Nelson de Leon AR 13937 SHEET NO.

A-06.3

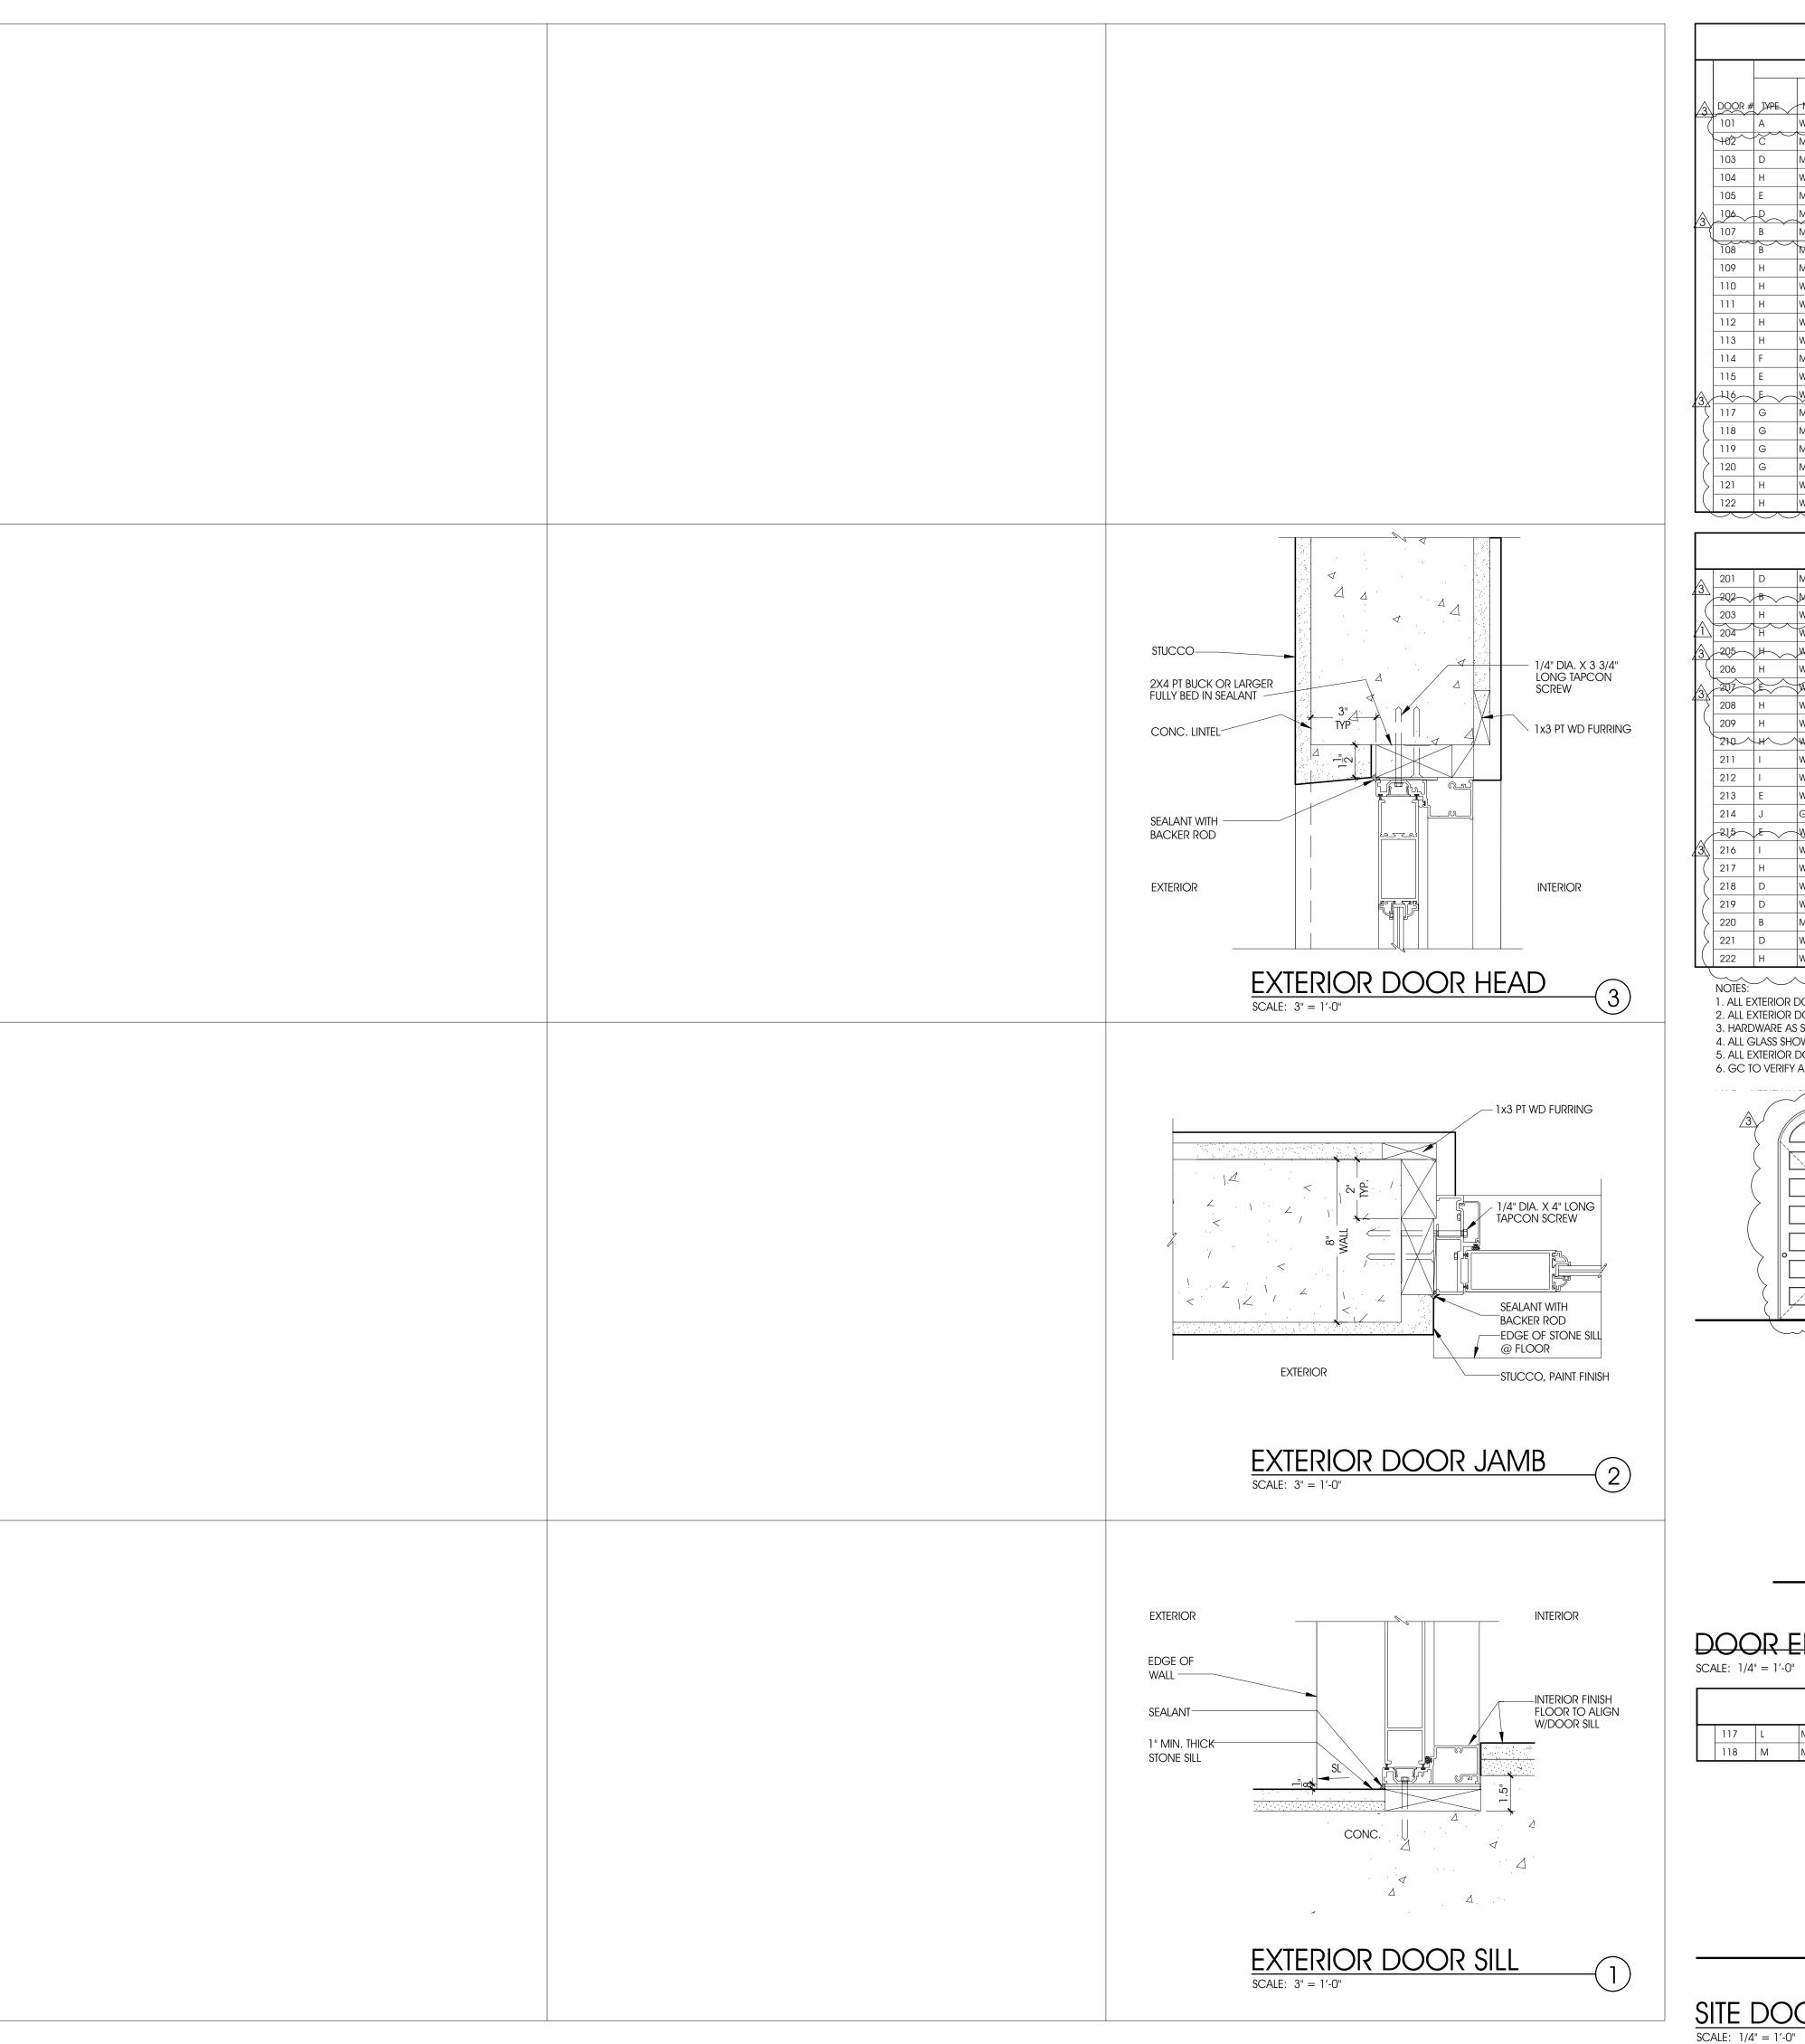


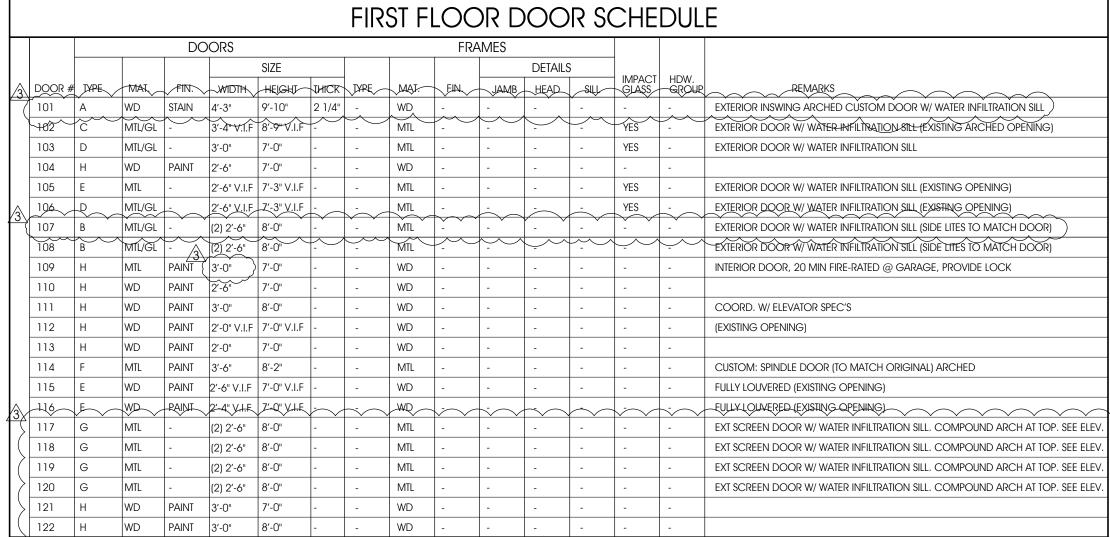

								SEC	CON	ID F	LOC	OR D	OOC	OR S	CHE	DULE
	201	D	MTL/GL	-	2'-6"	7′-3"	-	-	MTL	-	-	-	-	YES	-	EXTERIOR DOOR W/ WATER INFILTRATION SILL
(3)	202~	B	MILIGE	·	(2) 2'-6"	8',0"		~	MIL		~~~	-	~~~	YEŞ	~~	EXTERIOR DOOR W. WATER INFILIRATION SILL (SIDE LITES)
	203	Н	WD	PAINT	3′-0"	7′-0"	-	-	WD	-	-	-	-	-	-	COORD. W/ ELEVATOR SPEC'S
	204	H	WD	PAINT	2'-0"	8'-0"	<u> -</u>	\	\\\\\\\\\\\\\\\\\\\\\\\\\\\\\\\\\\\\\\	-				-	_	
3	205	#	WD	PAINT	3'-0"	8'-0"		~~~	WD_	<u> </u>	~~~			~		COORD, WHELEVATOR SPEC'S
	206	Н	WD		2′-6"	7′-0"	-	-	WD	-	-	-	-	-	-	COORD. W/ ELEVATOR SPEC'S
3	20/		WA		2-6 VIE	7-3 VII.E						$\sim$				FULT COVERED EXISTING OPENING
	208	Н	WD	PAINT	2′-6"	7′-0"	-	-	WD	-	-	-	-	-	-	COORD. W/ ELEVATOR SPEC'S
	209	Н	WD	PAINT	2′-6"	7′-0"	-	-	WD	-	-	-	-	-	-	COORD. W/ ELEVATOR SPEC'S
	210	#/	/WD^	PAINT	2^6"	7'3'V.LF^	<u> </u>					^_		- ^	^_	(MAICH BEDROOM DOOR NEIGHT)
	211	1	WD	PAINT	(2) 1′-8"	7′-0" V.I.F	-	-	WD	-	-	-	-	-	-	CLOSET DOOR
	212	1	WD	PAINT	(2) 1′-8"	7′-0" V.I.F	-	-	WD	-	-	-	-	-	-	CLOSET DOOR
	213	Е	WD	PAINT	2′-6"	7′-0" V.I.F	-	-	WD	-	-	-	-	-	-	FULLY LOUVERED
	214	J	GL	-	2′-4"	7′-0"	-	-	-	-	-	-	-	-	-	CAT II SAFETY GLASS, FBC2406.4.3.2 - R4410.1
	215	E	WD	PAINI	2'-6"	7'-0" \\	-	~~	WQ (		~~~	~~~				FHLYLQUVERED
<u>3</u> [	216	1	WD	PAINT	(2)1′-4" VIF	7′-0" V.I.F	-	-	WD	-	-	-	-	-	-	CLOSET DOOR
(	217	Н	WD	PAINT	2′-8"	7′-0" V.I.F	-	-	WD	-	-	-	-	-	-	(MATCH BEDROOM DOOR HEIGHT)
	218	D	WD	PAINT	2′-6"	8'-0" V.I.F	-	-	MTL	-	-	-	-	YES	-	EXTERIOR DOOR W/ WATER INFILTRATION SILL
	219	D	WD	PAINT	2′-6"	8'-0" V.I.F	-	-	MTL	-	7	-	-	YES	-	EXTERIOR DOOR W/ WATER INFILTRATION SILL
$  \rangle  $	220	В	MTL/GL	-	(2) 2′-6"	8'-0"	-	-	MTL	-	-	-	-	YES	-	EXTERIOR DOOR W/ WATER INFILTRATION SILL (SIDE LITES)
$  \rangle  $	221	D	WD	PAINT	3′-0"	8'-0" V.I.F	-	-	MTL	-	-	-	-	YES	-	EXTERIOR DOOR W/ WATER INFILTRATION SILL
	222	Н	WD	PAINT	2′-6"	8'-0"	-	-	WD	-	-	-	-	-	-	COORD. W/ ELEVATOR SPEC'S

NOTES:


- 1. ALL EXTERIOR DOORS BY PGT WINDOOR OR OWNER APPROVED.
- 2. ALL EXTERIOR DOORS SHALL BE IMPACT RESISTANT 7/16", CLEAR GLASS, BONE WHITE FRAMES. 3. HARDWARE AS SELECTED BY ARCHITECT.
- 4. ALL GLASS SHOWER DOORS WILL BE 1/2" TEMPERED SAFETY GLASS, CATII. 5. ALL EXTERIOR DOORS TO BE KEYED WITH SAME MASTER KEY.
- 6. GC TO VERIFY ALL OPENINGS, PROVIDE NOA AND SHOP DRAWINGS FOR ARCHITECTS REVIEW.

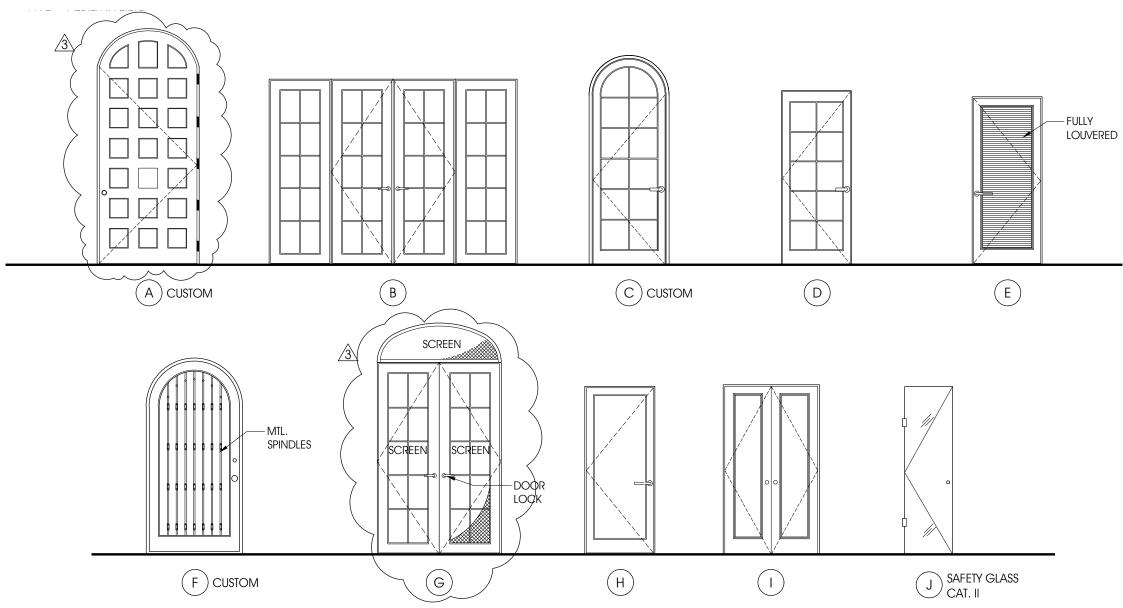

#### DOOR ELEVATIONS

SCALE: 1/4" = 1'-0"

							SITE	DC	OOR	SC	HED	ULE			
117	L	MTL	PAINT	3′-6"	5'-11 1/2"	-	-	MTL	-	-	-	-	-	-	ENTRANCE GATE
118	М	MTL	PAINT	(2) 7′-10"	5′-11 1/2"	-	-	MTL	-	-	-	-	-	-	GATE
		·	·										·		

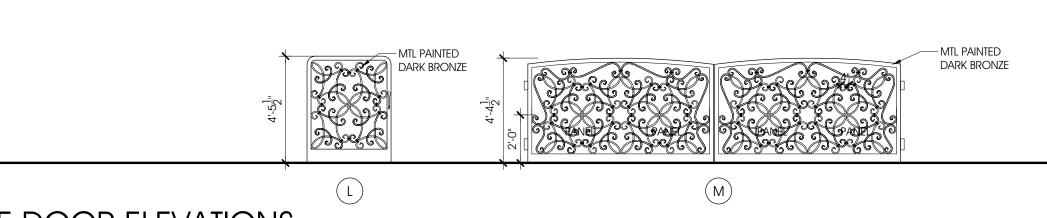

Locus ARCHITECTURE

INCORPORATED

NOTES

500 South Dixie Highway, Suite 307 Coral Gables, Florida 33146 Tel (305) 740-0120 Email: locus@locusarchitecture.net

CONSULTANT(S)

	REVISION/SUBMISSION	DATE
	REVIEW	01-13-25
	COA HISTORICAL SUBM (MASTER PLAN)	02-06-23
	PERMIT SUBMITTAL	10-28-23
	BOA SUBMITTAL	02-08-24
	COA SUBMITTAL	04-17-24
<u>i</u>	COA & CITY COMMENTS OWNER REVISION	04-22-24
	BOA RESUBMITTAL	10-16-24
3	OWNER REVISIONS	01-13-25


PROJECT

Historical: Remodel & Additions Soane Residence

1104 Malaga Avenue Coral Gables, FL 33134


DRAWING

Door Schedule and Details

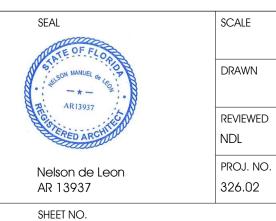

A-07.0

SITE DOOR ELEVATIONS

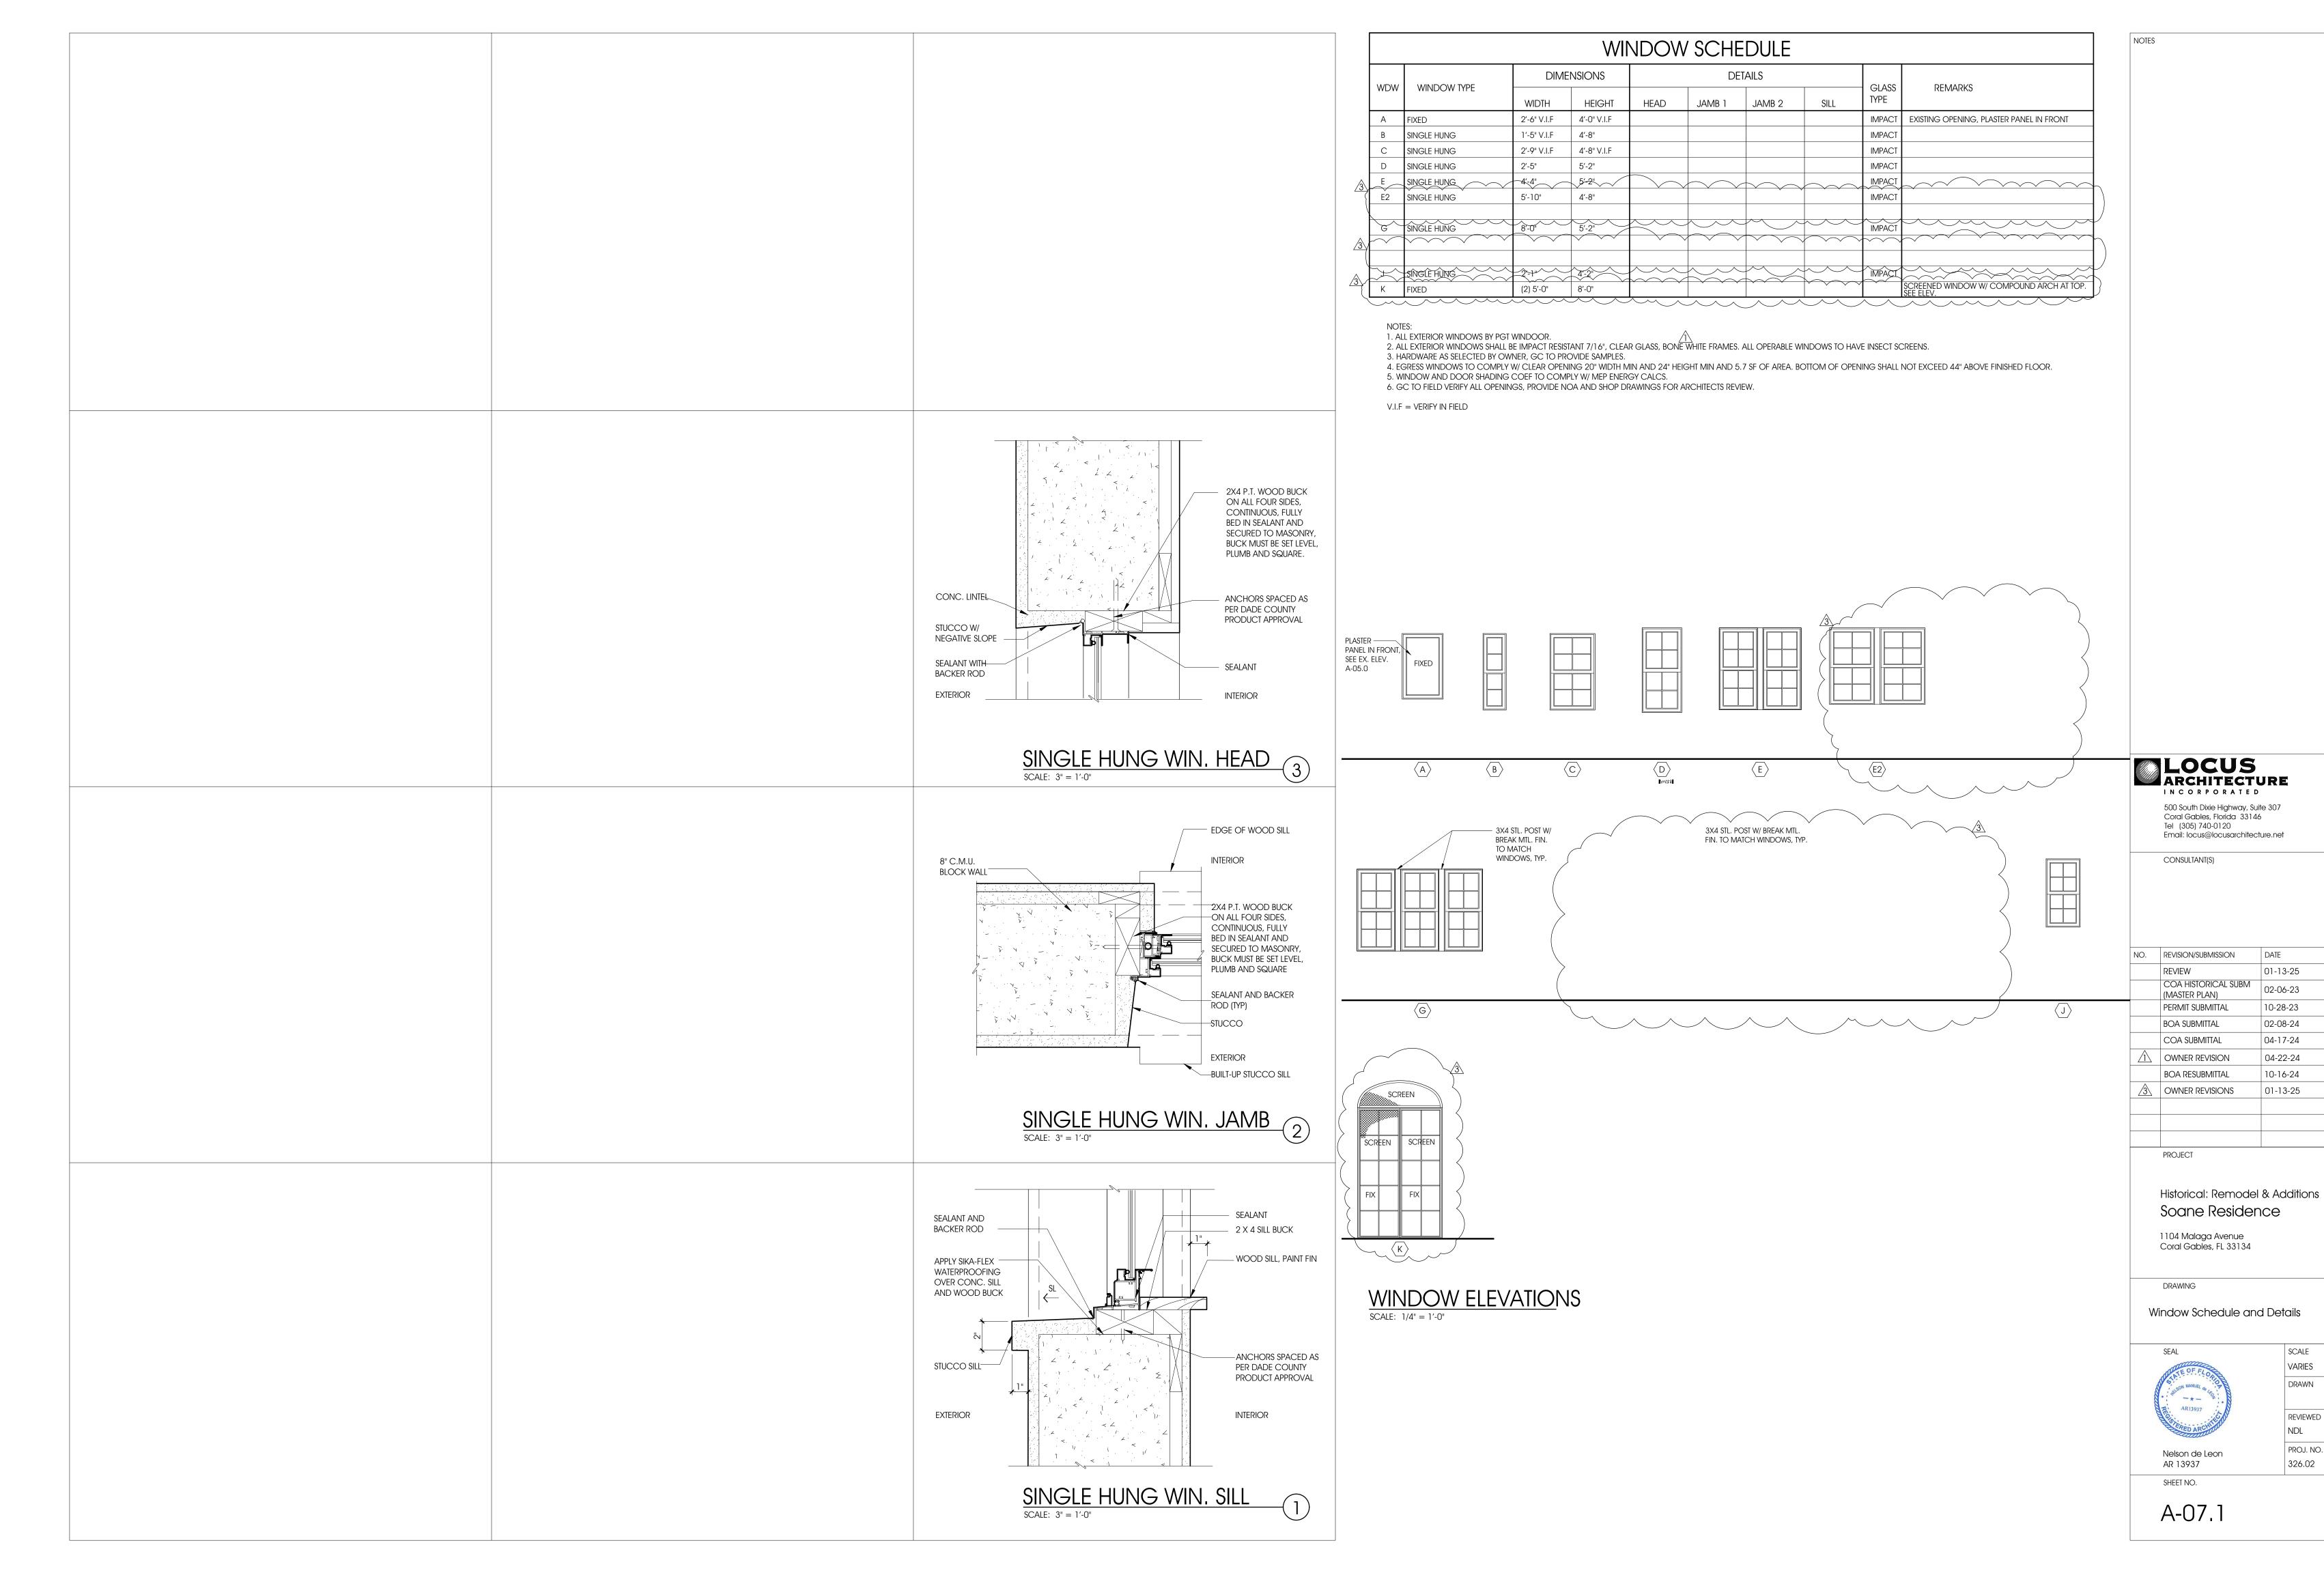

DATE

01-13-25

02-06-23

10-28-23

02-08-24

04-17-24

04-22-24

10-16-24


01-13-25

VARIES

DRAWN


REVIEWED NDL PROJ. NO.


326.02

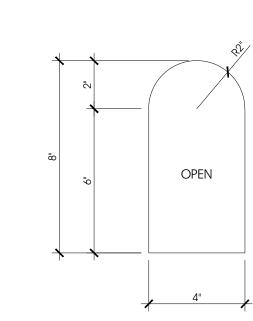


DECORATIVE OPENINGS DETAIL

SCALE: 3" = 1'-0"

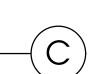

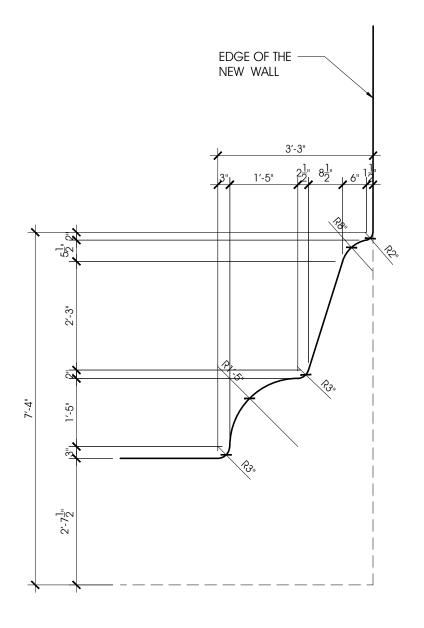


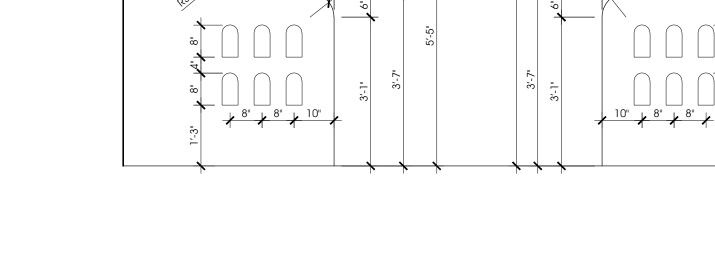

EDGE OF THE — EXISTING WALL — EDGE OF THE EXISTING WALL

DECORATIVE WINGWALL DETAIL

SCALE: 1/2" = 1'-0"

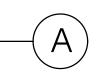

LOCUS ARCHITECTURE INCORPORATED

500 South Dixie Highway, Suite 307 Coral Gables, Florida 33146 Tel (305) 740-0120 Email: locus@locusarchitecture.net

CONSULTANT(S)

NO.	REVISION/SUBMISSION	DATE
	REVIEW	01-13-25
	COA HISTORICAL SUBM (MASTER PLAN)	02-06-23
	PERMIT SUBMITTAL	10-28-23
	BOA SUBMITTAL	02-08-24
	COA SUBMITTAL	04-17-24
	OWNER REVISION	10-15-24
	BOA RESUBMITTAL	

PROJECT

Historical: Remodel & Additions Soane Residence

1104 Malaga Avenue Coral Gables, FL 33134

DRAWING Details

DRAWN REVIEWED NDL PROJ. NO. 326.02

Nelson de Leon AR 13937 SHEET NO.

A-08.0